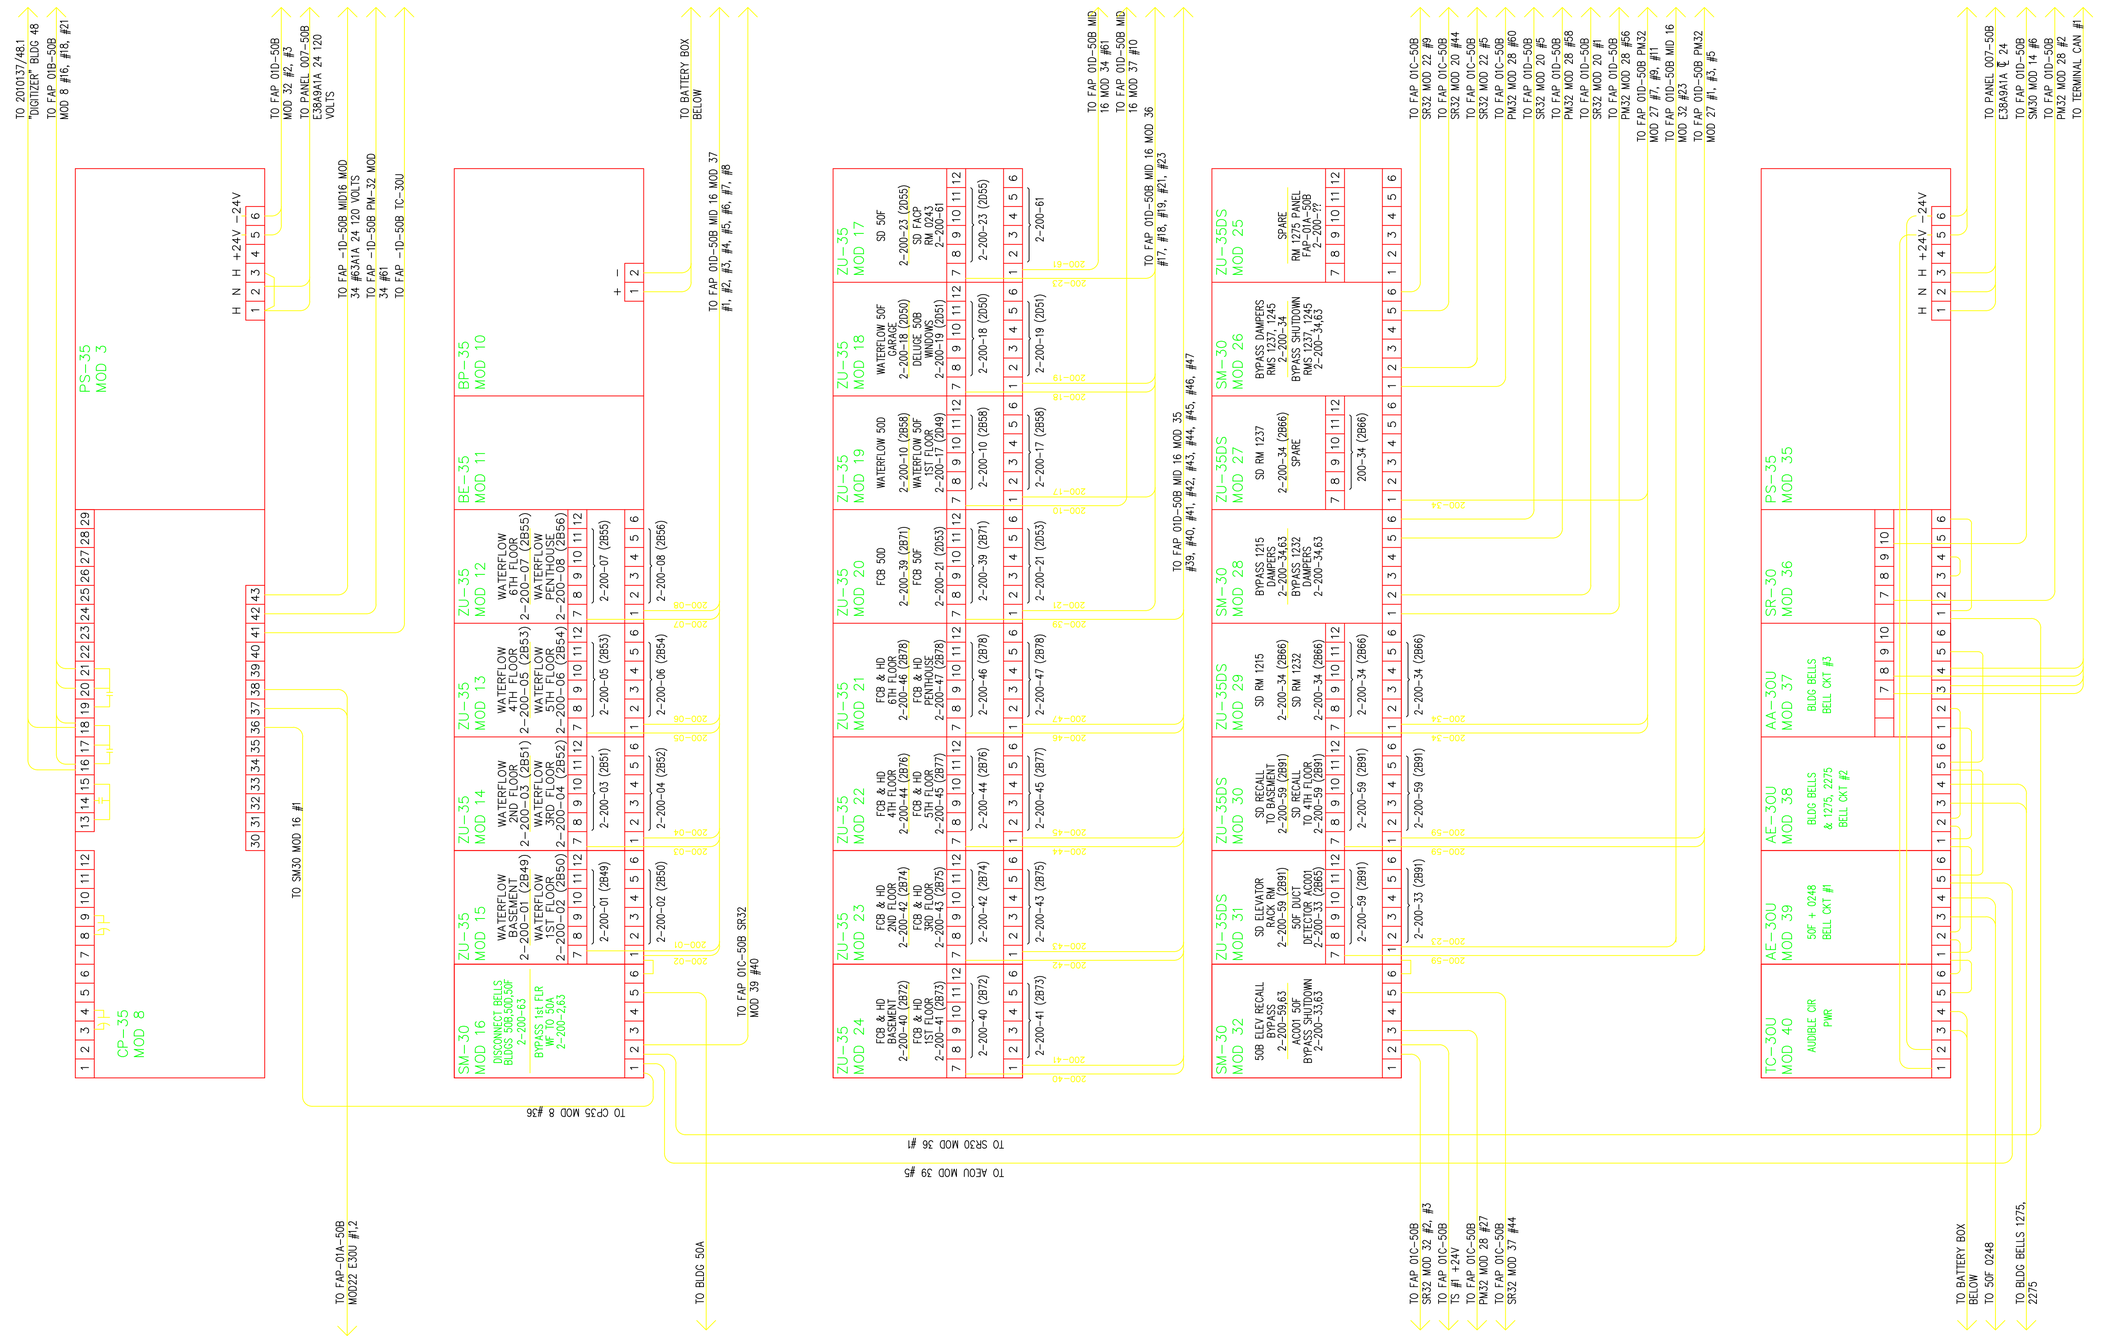

FIELD TO VERIFY WIRING

	AS BUILT	I	LDD	LDD	MCD	05/13/13	AS BUILT PER FIELD VERIFICATIONS
		H	AD	LDD	MCD	11/12/07	FIRE ALARM SYSTEM UPGRADE
		G	AD	LDD	MCD	03/15/07	PHASE III FIRE ALARM UPGRADE
		F	AD	AD	MCG	04/09/04	PHASE III FIRE ALARM UPGRADE
		E	GMS	MCG	MCG	04/16/02	ADD ELEVATOR RECALL CIRCUITS
		D	GMS	MCG	MCG	04/16/02	MODIFY ELEVATOR RECALL CIRCUITS
		C	TK	MCG	MCG	08/21/01	NEW INSTALLATION (FX-1051)
PROFESSIONAL SEAL (IF REVISION, APPLIES ONLY TO REVISED WORK)	ISSUE (PROGRESS, ESTIMATE, BID, CONSTRUCTION, CONFORMED, REVISION, RECORD)	REVISION NUMBER	DRAWN BY	CHECKED BY	APPR'D BY	DATE	REMARKS

50B FIRE ALARM SYSTEM
SYSTEM 3 PANEL FAP-01-50B INTERCONNECTION DIAGRAM

UNIVERSITY OF CALIFORNIA
LAWRENCE BERKELEY NATIONAL LABORATORY
FACILITIES DIVISION

DRAWN BY	AD	DATE 5/15/2007
CHECKED BY		5/15/2007
APPROVED BY		5/15/2007
CAD FILE PATH		
SCALE	As Noted	
DRAWING NO.	4B50BE177I	SHEET
PROJECT NO.	FC7500	1 OF 1