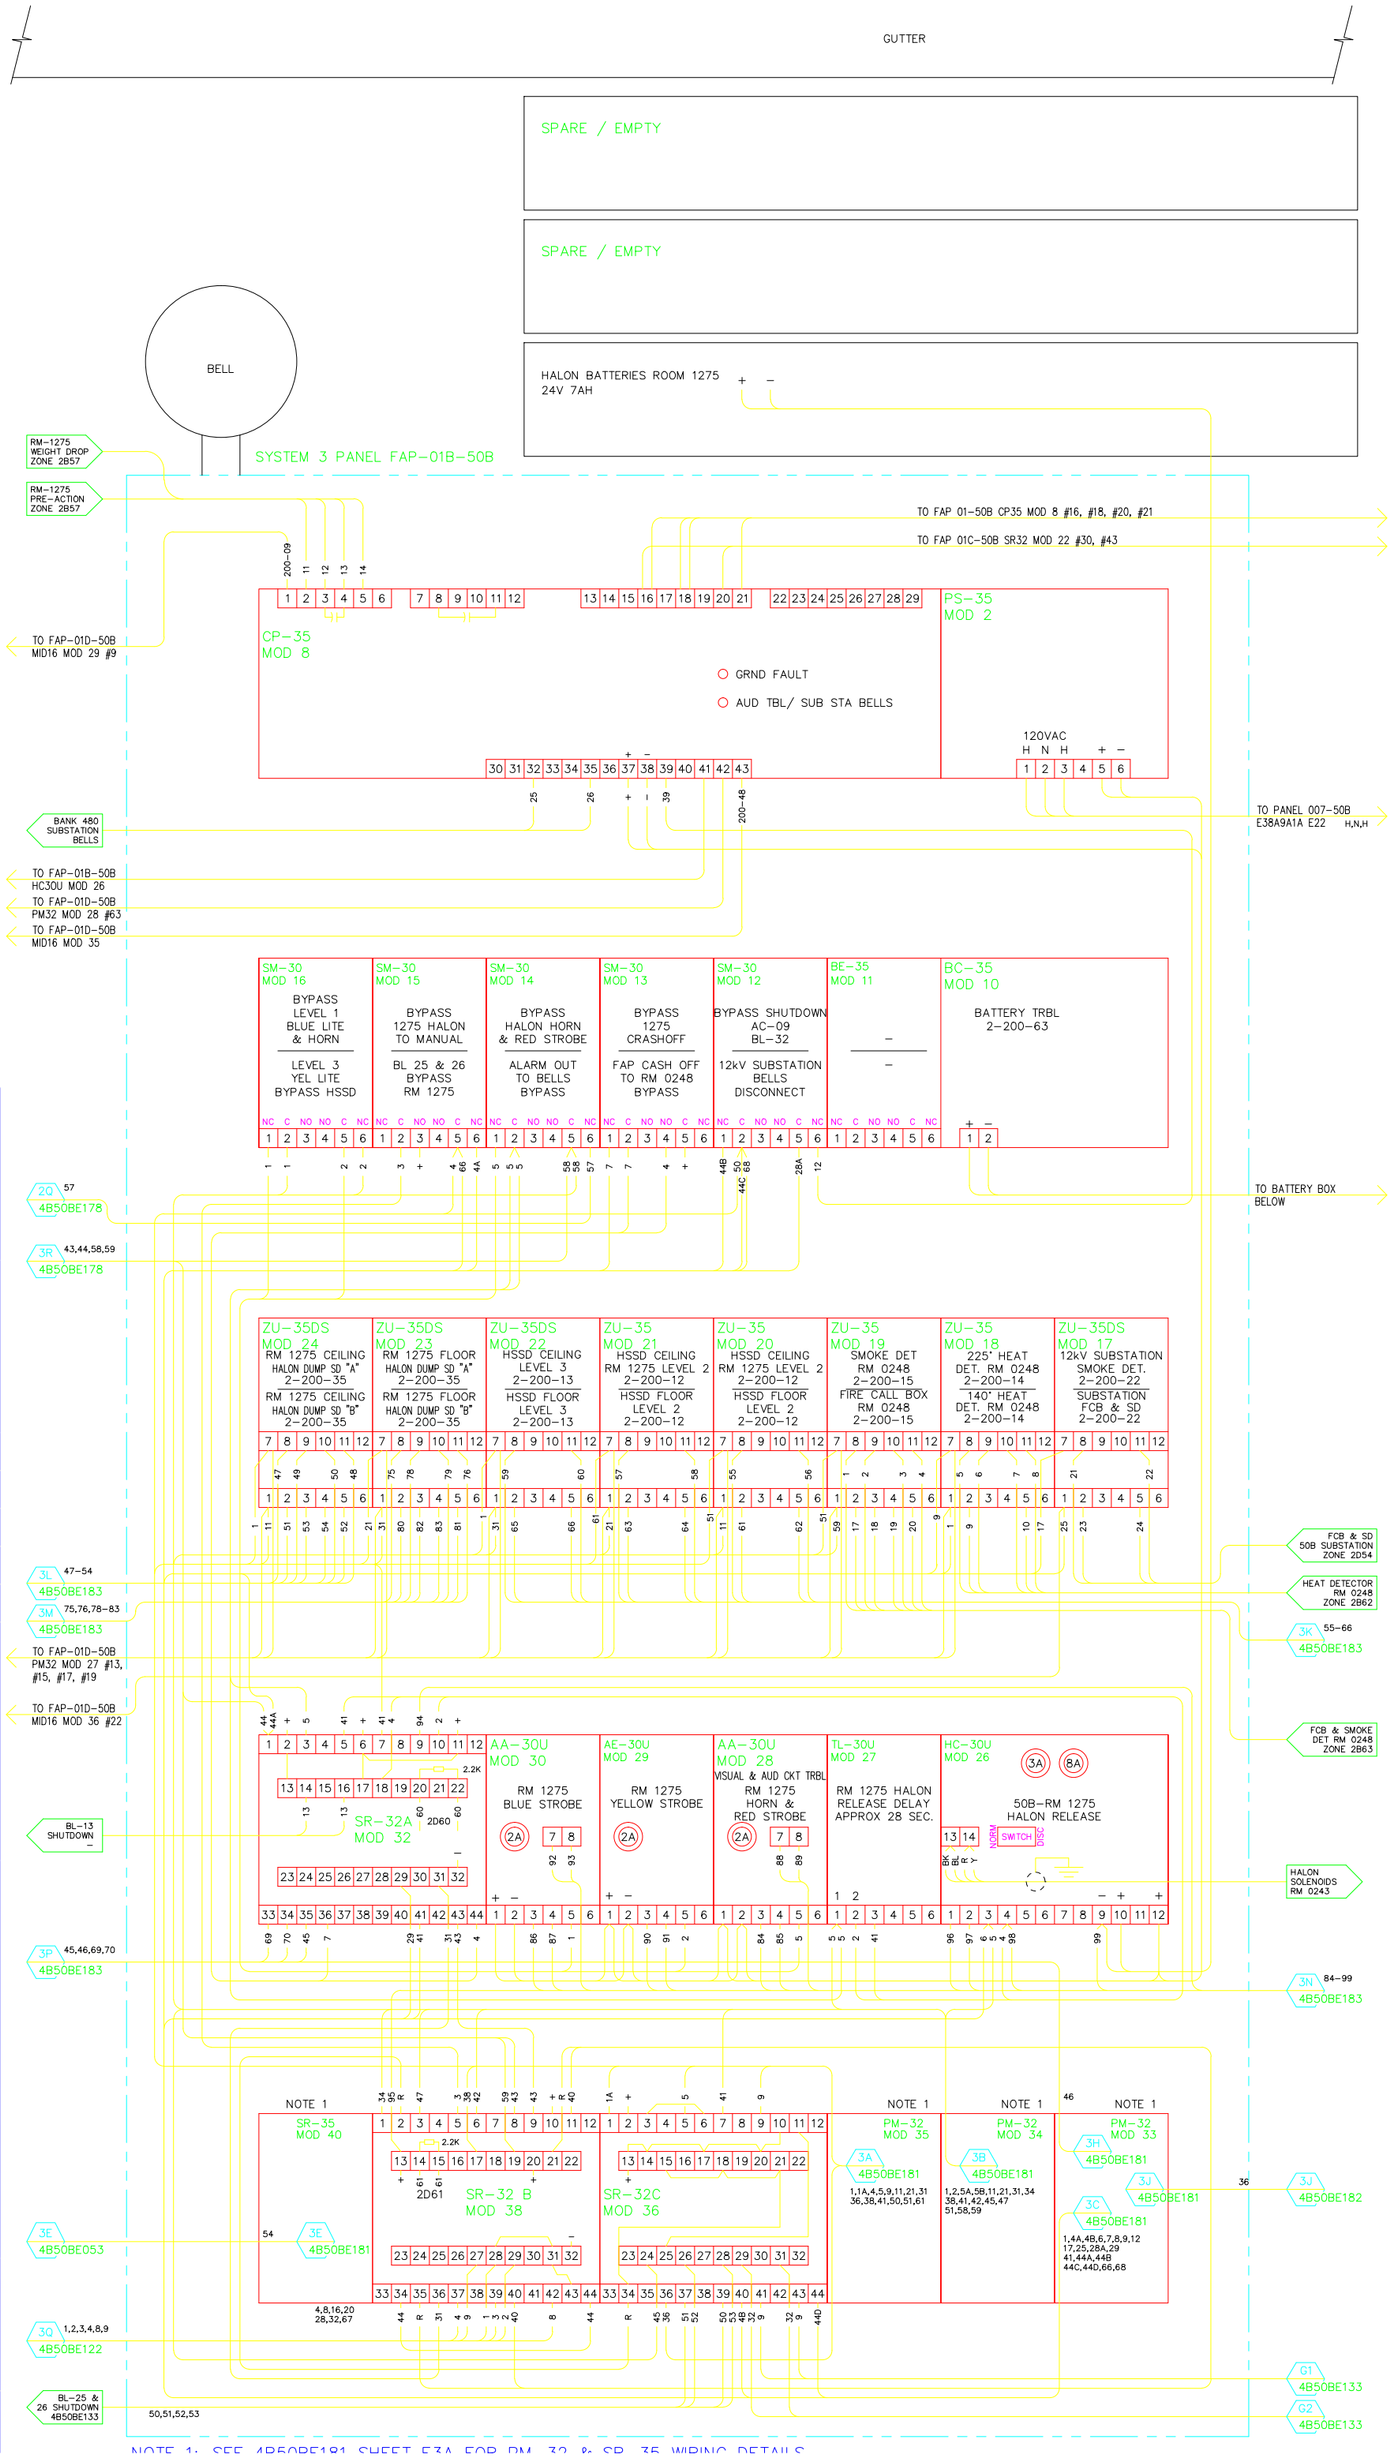

F	5/13/2013	ASBUILT			
A	RGB	MRC	AD	MCG	11/25/96 ISSUED FOR FIELD VERIFICATION
B	MRC	AD	MCG	05/07/04 PHASE III FIRE ALARM SYSTEM UP-GRADE	
C	AD	LDD	MCD	11/12/07 FIRE ALARM SYSTEM UP-GRADE	
D			MCD	09/30/08 AS BUILT	
E				05/15/09 AS BUILT	
F	LDD	LDD	MCD	06/13/13 AS BUILT PER FIELD VERIFICATIONS	

ISSUE — CHANGES, REVISIONS, CORRECTIONS (ORIGINAL RECORD)

REVISIONS — SEE (F) REVISION, APPLIES ONLY TO (NEWER WORK)

50B FIRE ALARM SYSTEM
SYS 3 PNL FAP-01B-50B
INTERCONNECTION DIAGRAM

UNIVERSITY OF CALIFORNIA
LAWRENCE BERKELEY NATIONAL LABORATORY
FACILITIES DIVISION

DRAWN BY	RGB	11/12/19
CHECKED BY	JJH	11/12/19
APPROVED BY	MCG	11/12/19
CAD FILE PATH		
SCALE	As Noted	
DRAWING NO.	4B50BE180F	
PROJECT NO.	FB4010	
SHEET	1 OF 1	