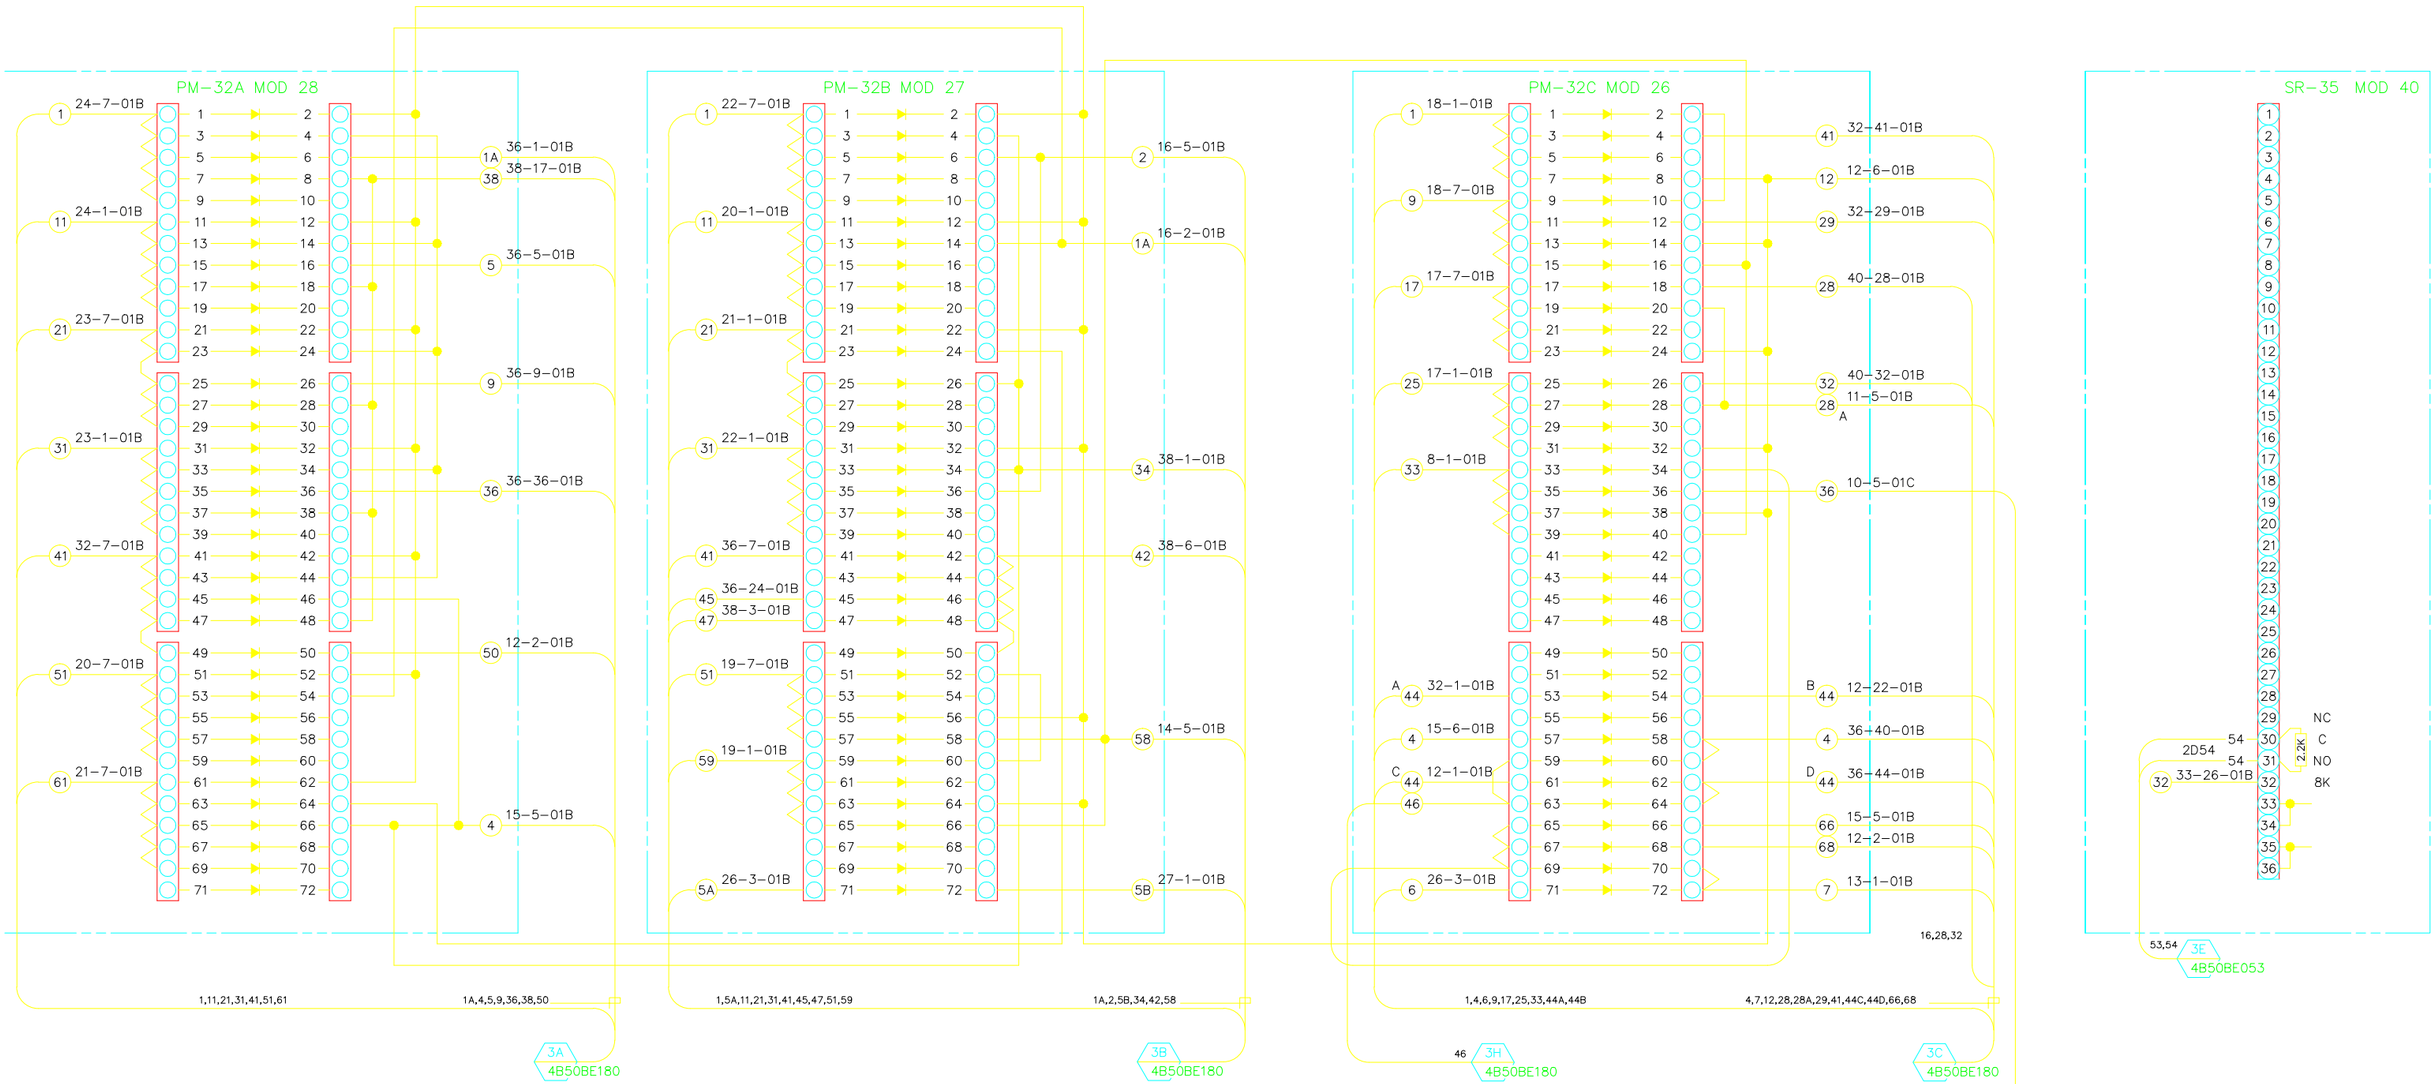

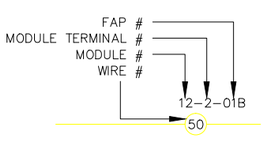

WIRE DESTINATION KEY

PART OF SYS 3 PANEL FAP-01B-50B (SEE SHEET E3, DWG.# 4B50BE180)

ASBUILT REVISION E 05/15/2009

PROFESSIONAL SEAL (IF REVISION, APPLIES ONLY TO REVISED WORK)

ISSUE (PROGRESS, ESTIMATE, BID, CONSTRUCTION, CONFORMED, REVISION, RECORD)

REVISION NUMBER	DRAWN BY	CHECKED BY	APPR'D BY	DATE	REMARKS
E				05/15/09	AS BUILT
D				09/30/08	AS BUILT
C	AD	LDD	MCD	11/12/07	FIRE ALARM SYSTEM UP-GRADE
B	MRC	AD	MCG	06/22/04	PHASE III FA UP-GRADE
A	ROB	ROB	MCG	11/25/96	ISSUED FOR FIELD VERIFICATION

50B FIRE ALARM SYSTEM

SYS 3 PNL FAP-01B-50B

PM-32 & SR-35 WIRING

UNIVERSITY OF CALIFORNIA
LAWRENCE BERKELEY NATIONAL LABORATORY
FACILITIES DIVISION

		DATE
DRAWN BY	ROB	11/12/199
CHECKED BY	JH	11/12/199
APPROVED BY	MCG	11/12/199
CAD FILE PATH	00022841	
SCALE	As Noted	
DRAWING NO.	4B50BE181E	SHEET 1 OF 1
PROJECT NO.	FB4010	