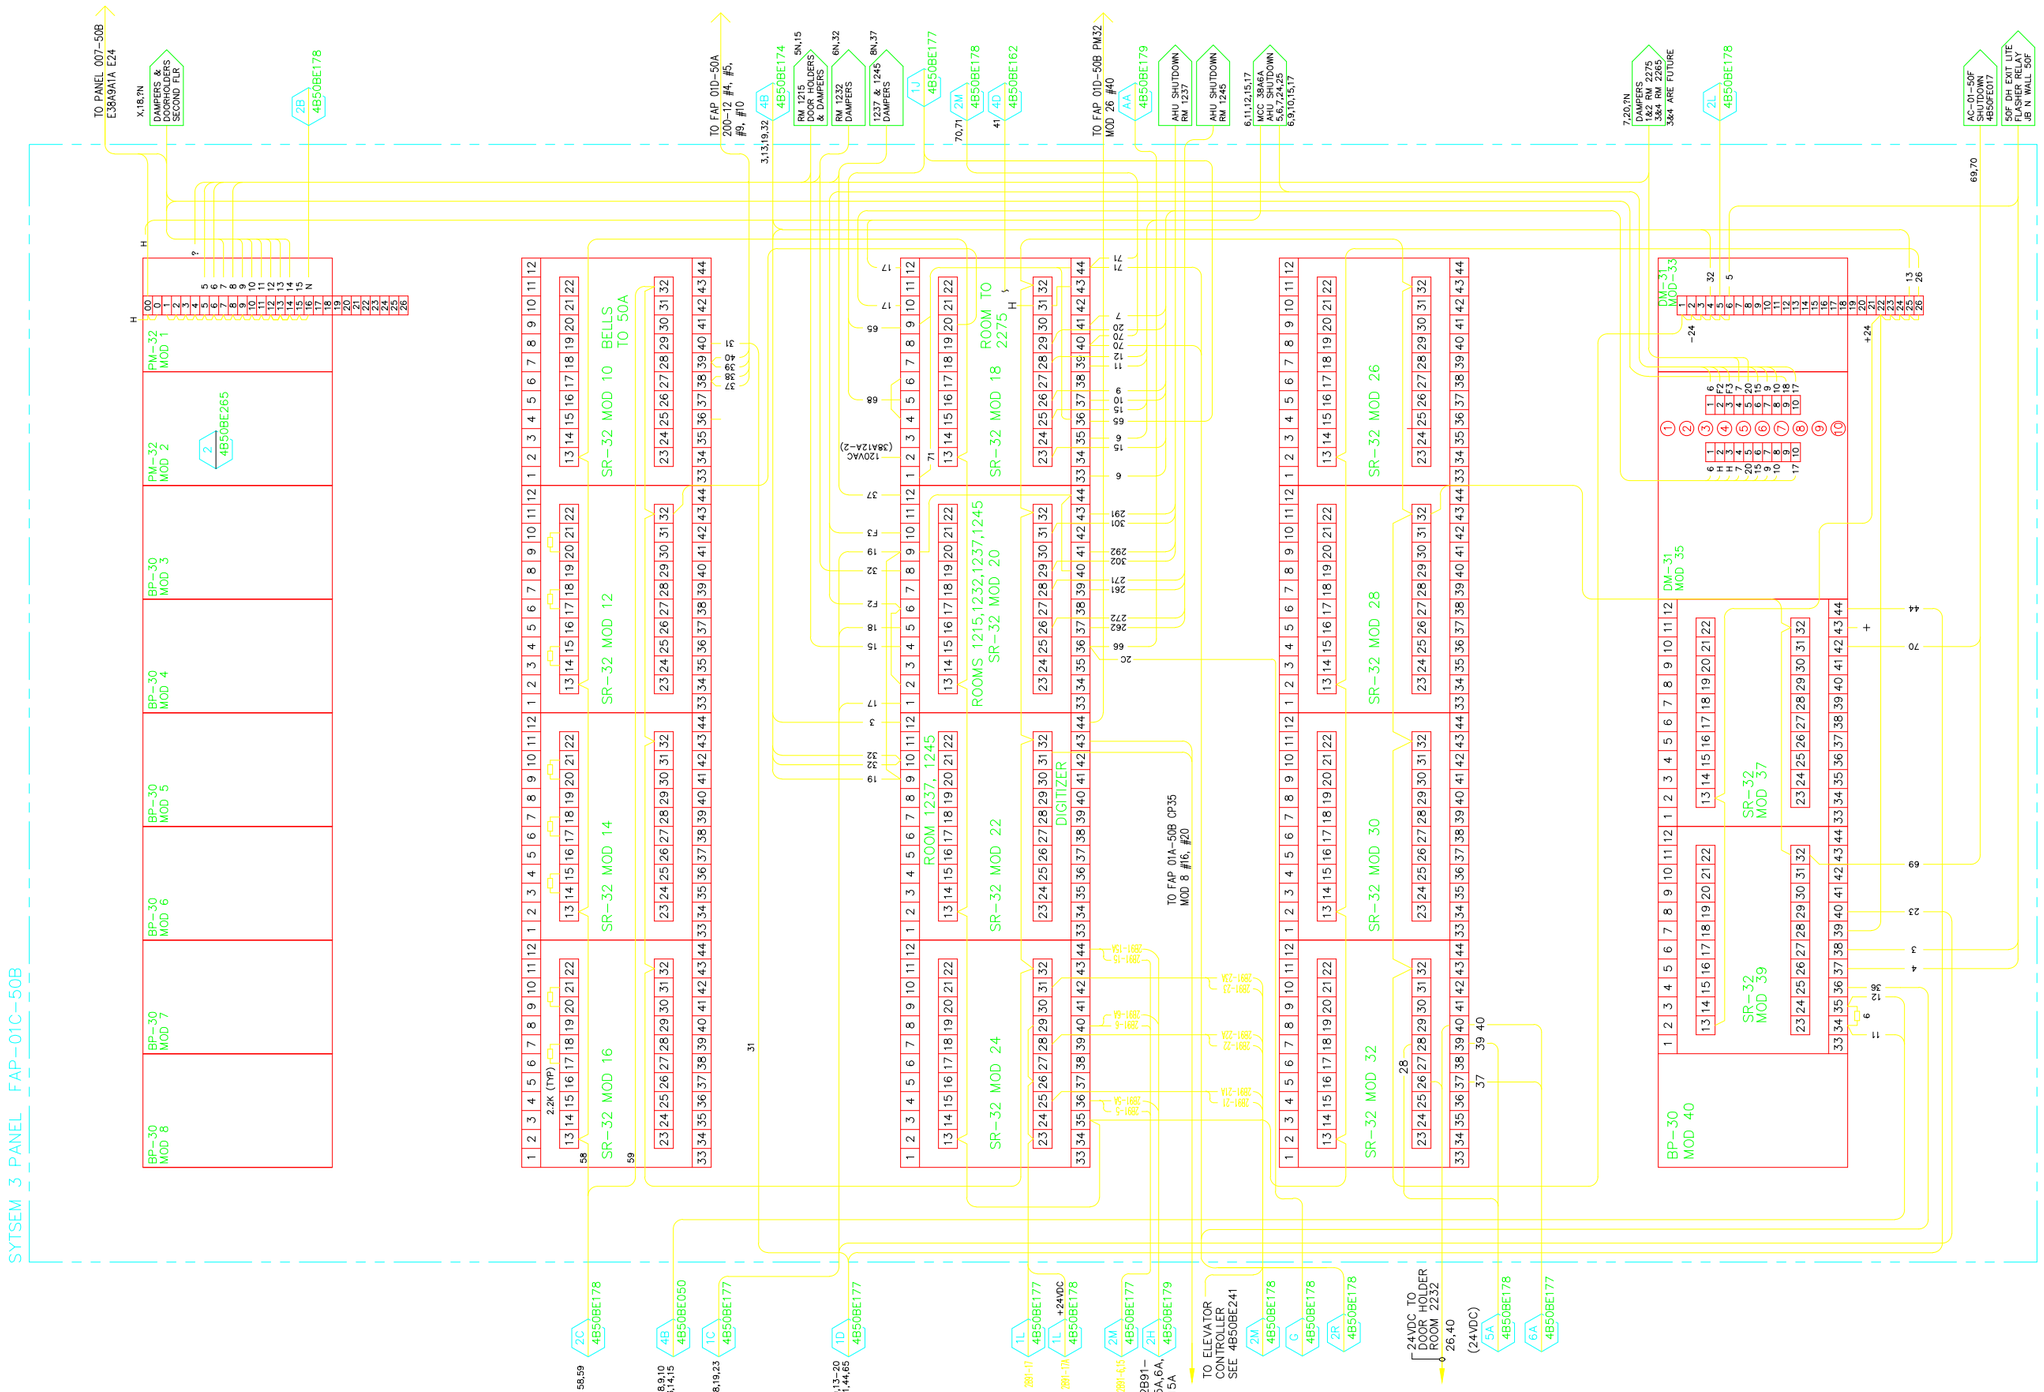

MOD 34 FUSES:

F1 AHU-6 SHUTDOWN
F2 1215 DAMPERS & DOORH, 1232 DAMPERS
F3 1237 DAMPERS
F4 2275 DAMPERS 1 & 2
F5 2275 DAMPERS 3 & 4
F6 AHU-5 SHUTDOWN
F7 AHU-24 SHUTDOWN
F8 AHU-25 SHUTDOWN
F9 SELF CONTAINED DOORH/SMOKES 2ND FLOOR
F10 AHU-7 SHUTDOWN

NOTE

LABEL ALL NEW AND MODIFIED WIRE AND CABLE IN THE FOLLOWING MANNER:

<ZONE NUMBER-WIRE SERIAL NUMBER>

THE WIRE SERIAL NUMBER SHALL BE A UNIQUE NUMBER BY ZONE. A LETTER SUFFIX MAY BE ADDED IF REQUIRED.

ASBUILT REVISION H 05/15/2009

REVISION NUMBER	DRAWN BY	CHECKED BY	APPR'D BY	DATE	REMARKS
H				05/15/09	AS BUILT
G				09/30/08	AS BUILT
F	AD	LDD	MCD	11/12/07	FIRE ALARM SYSTEM UP-GRADE
E	MRC	AD	MCG	06/22/04	PHASE III FA UP-GRADE
D	GMS	MCG	MCG	04/16/02	MODIFY ELEVATOR RECALL RELAY
C	TK	MCG	MCG	08/21/01	NEW INSTALLATION (FX-1051)
B	TK	MCG	MCG	08/21/01	DEMOLITION (FX-1051)

PROFESSIONAL SEAL (IF REVISION, APPLIES ONLY TO REVISED WORK)

ISSUE (PROGRESS, ESTIMATE, BID, CONSTRUCTION, CONFORMED, REVISION, RECORD)

50B FIRE ALARM SYSTEM
SYS 3 PNL FAP-01C-50B
INTERCONNECTION DIAGRAM

UNIVERSITY OF CALIFORNIA
LAWRENCE BERKELEY NATIONAL LABORATORY
FACILITIES DIVISION

DRAWN BY	ROB	DATE 11/12/19
CHECKED BY	JH	11/12/19
APPROVED BY	MCG	11/12/19
CAD FILE PATH	00022842	
SCALE	As Noted	
DRAWING NO.	4B50BE182H	SHEET 1 OF 1
PROJECT NO.	FB4010	