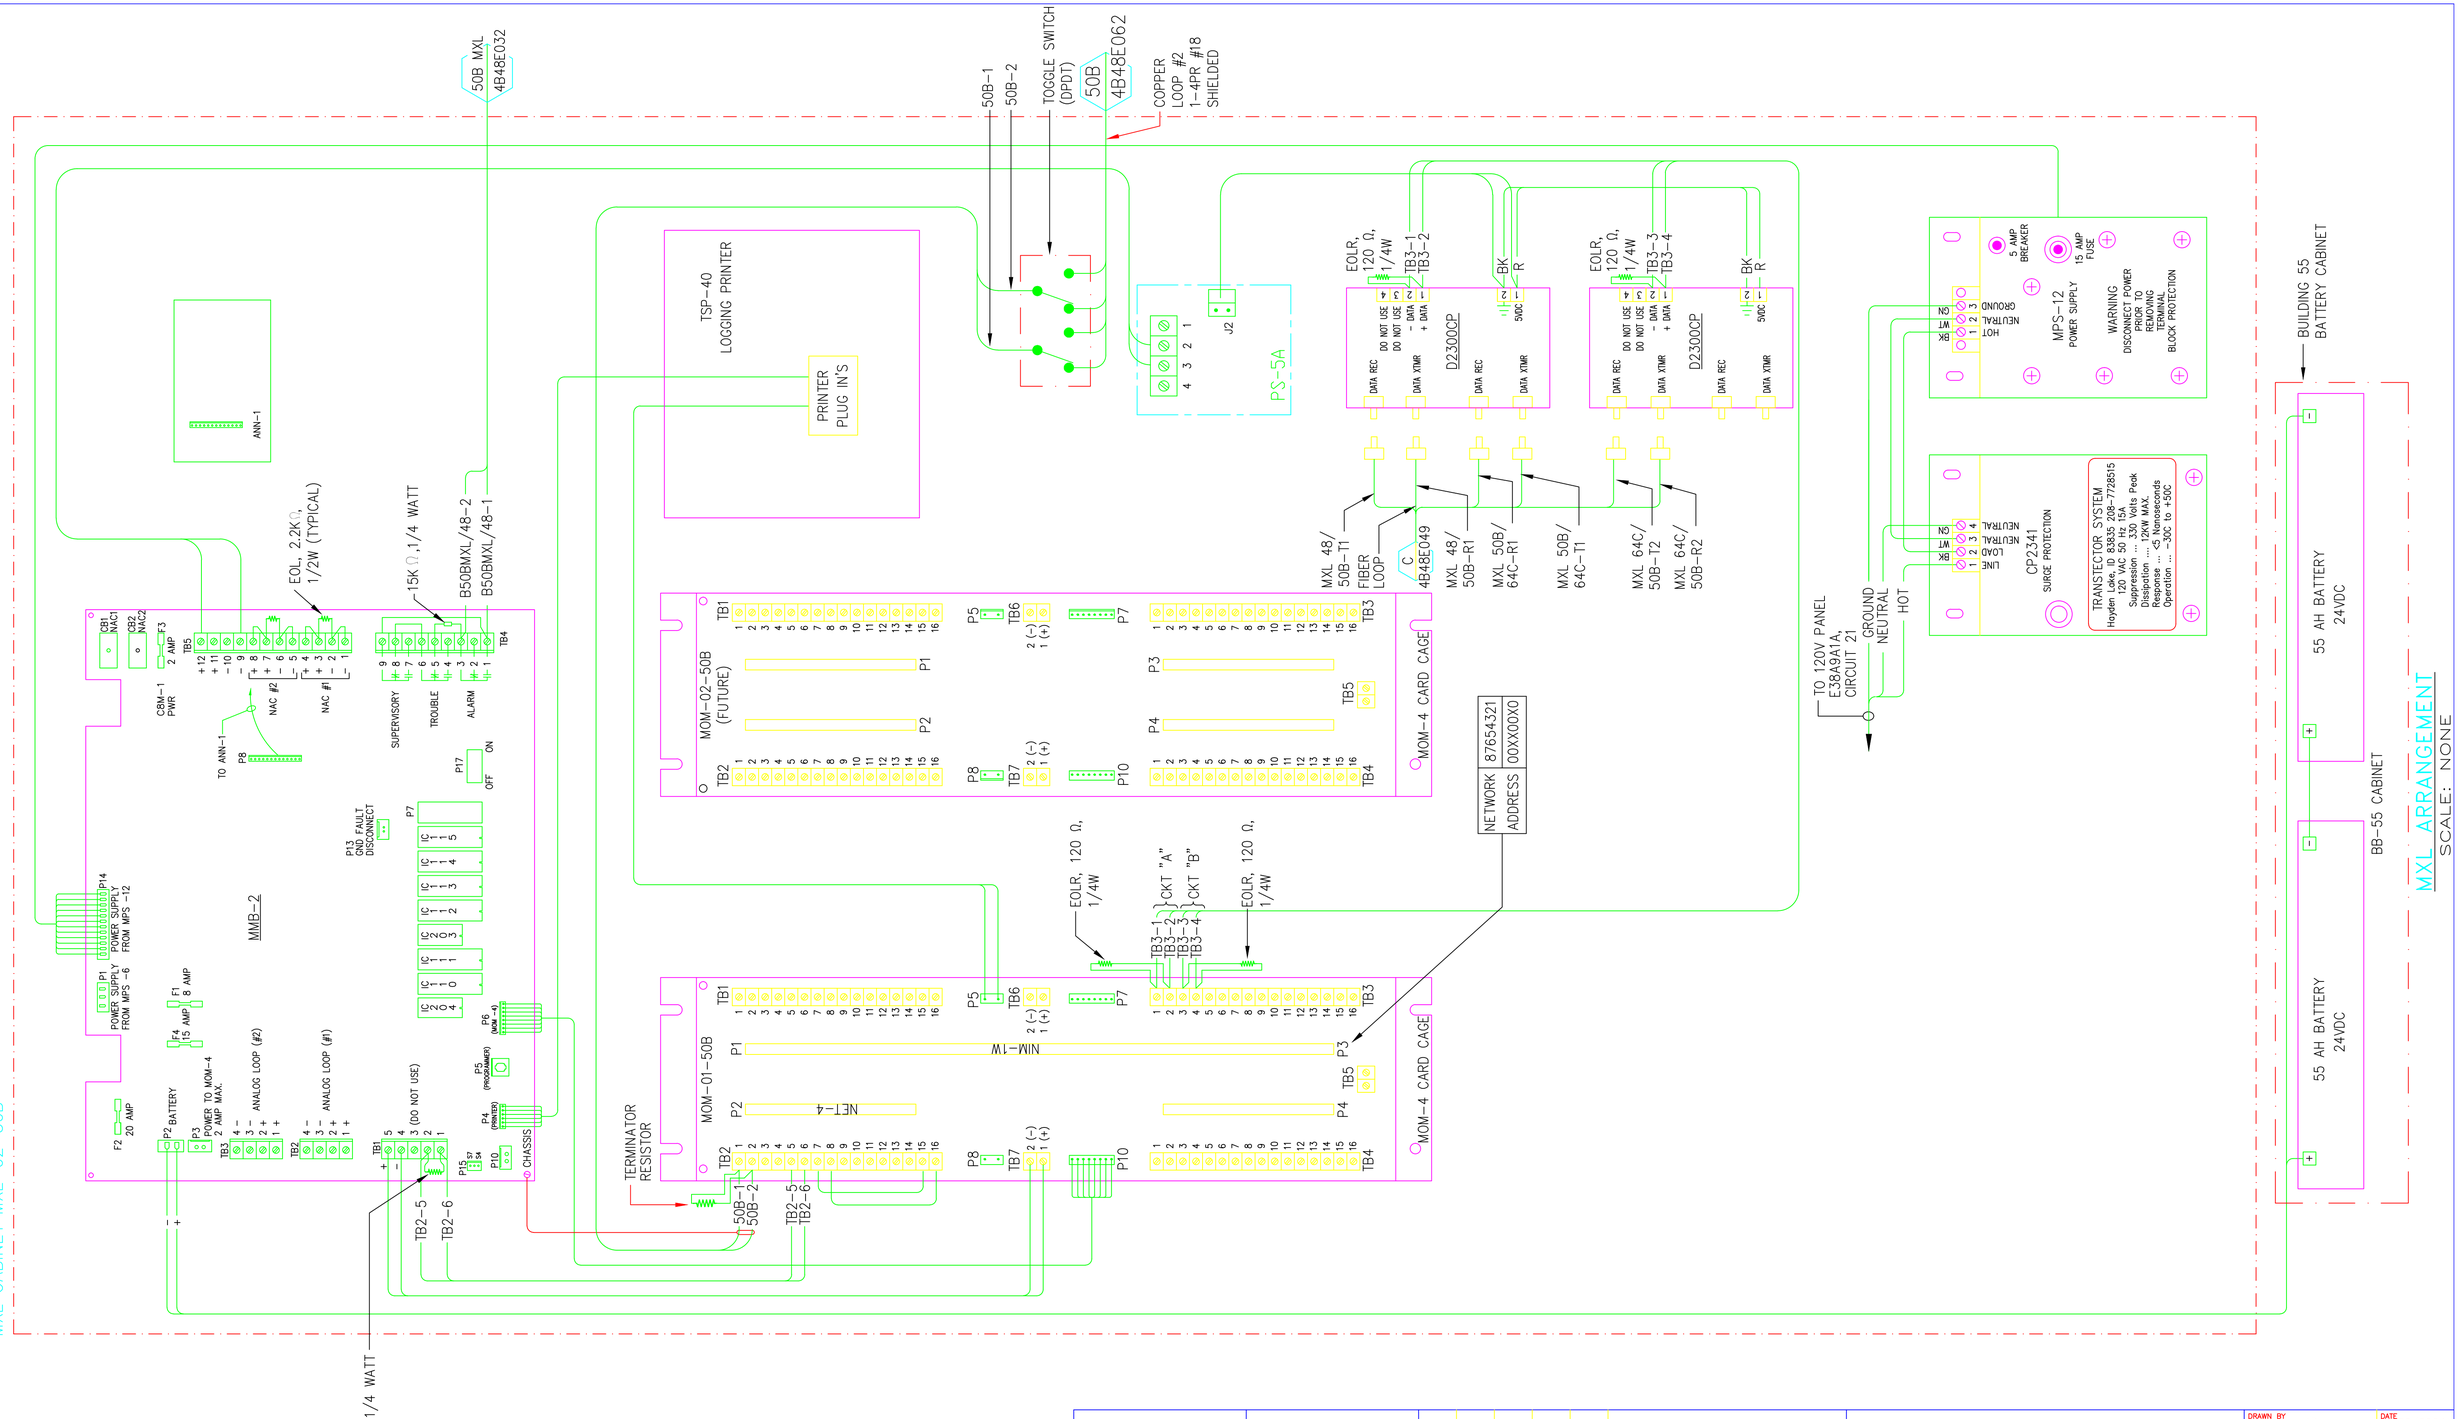

E	LDD	LDD	MCD	05/14/13	AS BUILT PER FIELD VERIFICATIONS		
D	AD	LDD	MCD	11/12/07	FIRE ALARM SYSTEM UPGRADE		
C	AD	LDD	MCD	03/03/06	REVISED FOR MXL COPPER LOOP		
B	AD	MCG	MCG	12/05/05	REVISED PER SIEMENS REVIEW		
A	AD	MCG	MCG	6/14/05	REVISED FOR MXL INSTALLATION		
REVISION NUMBER	DRAWN BY	CHECKED BY	APPR'D BY	DATE	REMARKS		

PROFESSIONAL SEAL (IF REVISION, APPLIES ONLY TO REVISED WORK)

ISSUE (PROGRESS, ESTIMATE, BID, CONSTRUCTION, CONFORMED, REVISION, RECORD)

AS BUILT

E

5/14/2013

50B FIRE ALARM

MXL #2

MXL CABINET LAYOUT

UNIVERSITY OF CALIFORNIA
LAWRENCE BERKELEY NATIONAL LABORATORY
FACILITIES DIVISION

		DATE
DRAWN BY	AD	9/30/2004
CHECKED BY	AD	9/30/2004
APPROVED BY	MCG	9/30/2004
CAD FILE PATH		
SCALE	Full	
DRAWING NO.	4B50BE257E	
PROJECT NO.	FE5200	
SHEET	1 OF 1	