MXL CABINET

MXL-01-50B

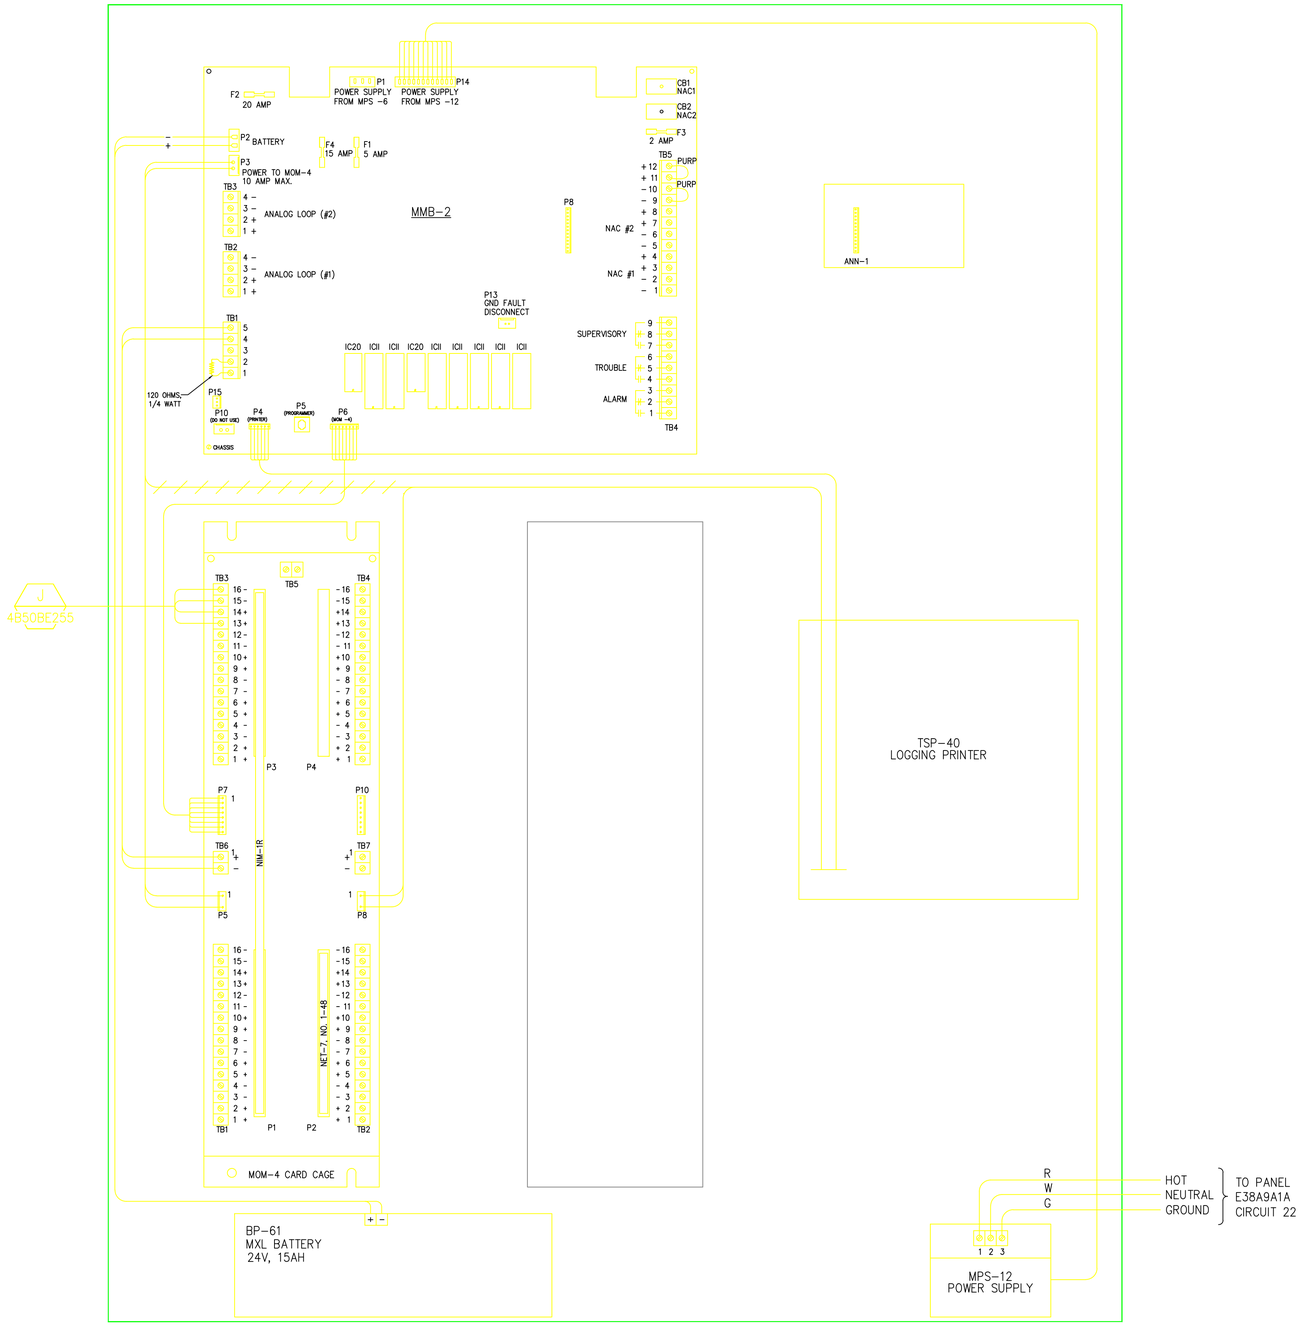

MXL ARRANGEMENT

SCALE: NONE

	AS BUILT A 5/14/2013	A	LDD	LDD	MCD	05/14/13	AS BUILT PER FIELD VERIFICATIONS
PROFESSIONAL SEAL (IF REVISION, APPLIES ONLY TO REVISED WORK)	ISSUE (PROGRESS, ESTIMATE, BID, CONSTRUCTION, CONFORMED, REVISION, RECORD)	REVISION NUMBER	DRAWN BY	CHECKED BY	APPR'D BY	DATE	REMARKS

50B BUILDING 50B

REPLACEMENT FIRE ALARM SYSTEM

MXL #1 FAP ARRANGEMENT

UNIVERSITY OF CALIFORNIA
LAWRENCE BERKELEY NATIONAL LABORATORY
FACILITIES DIVISION

DRAWN BY	AD	DATE 5/21/2004
CHECKED BY	AD	4/21/2005
APPROVED BY	MCG	
CAD FILE PATH		
SCALE	NONE	
DRAWING NO.	4B50BE258A	SHEET
PROJECT NO.	FA4010	1 OF 1