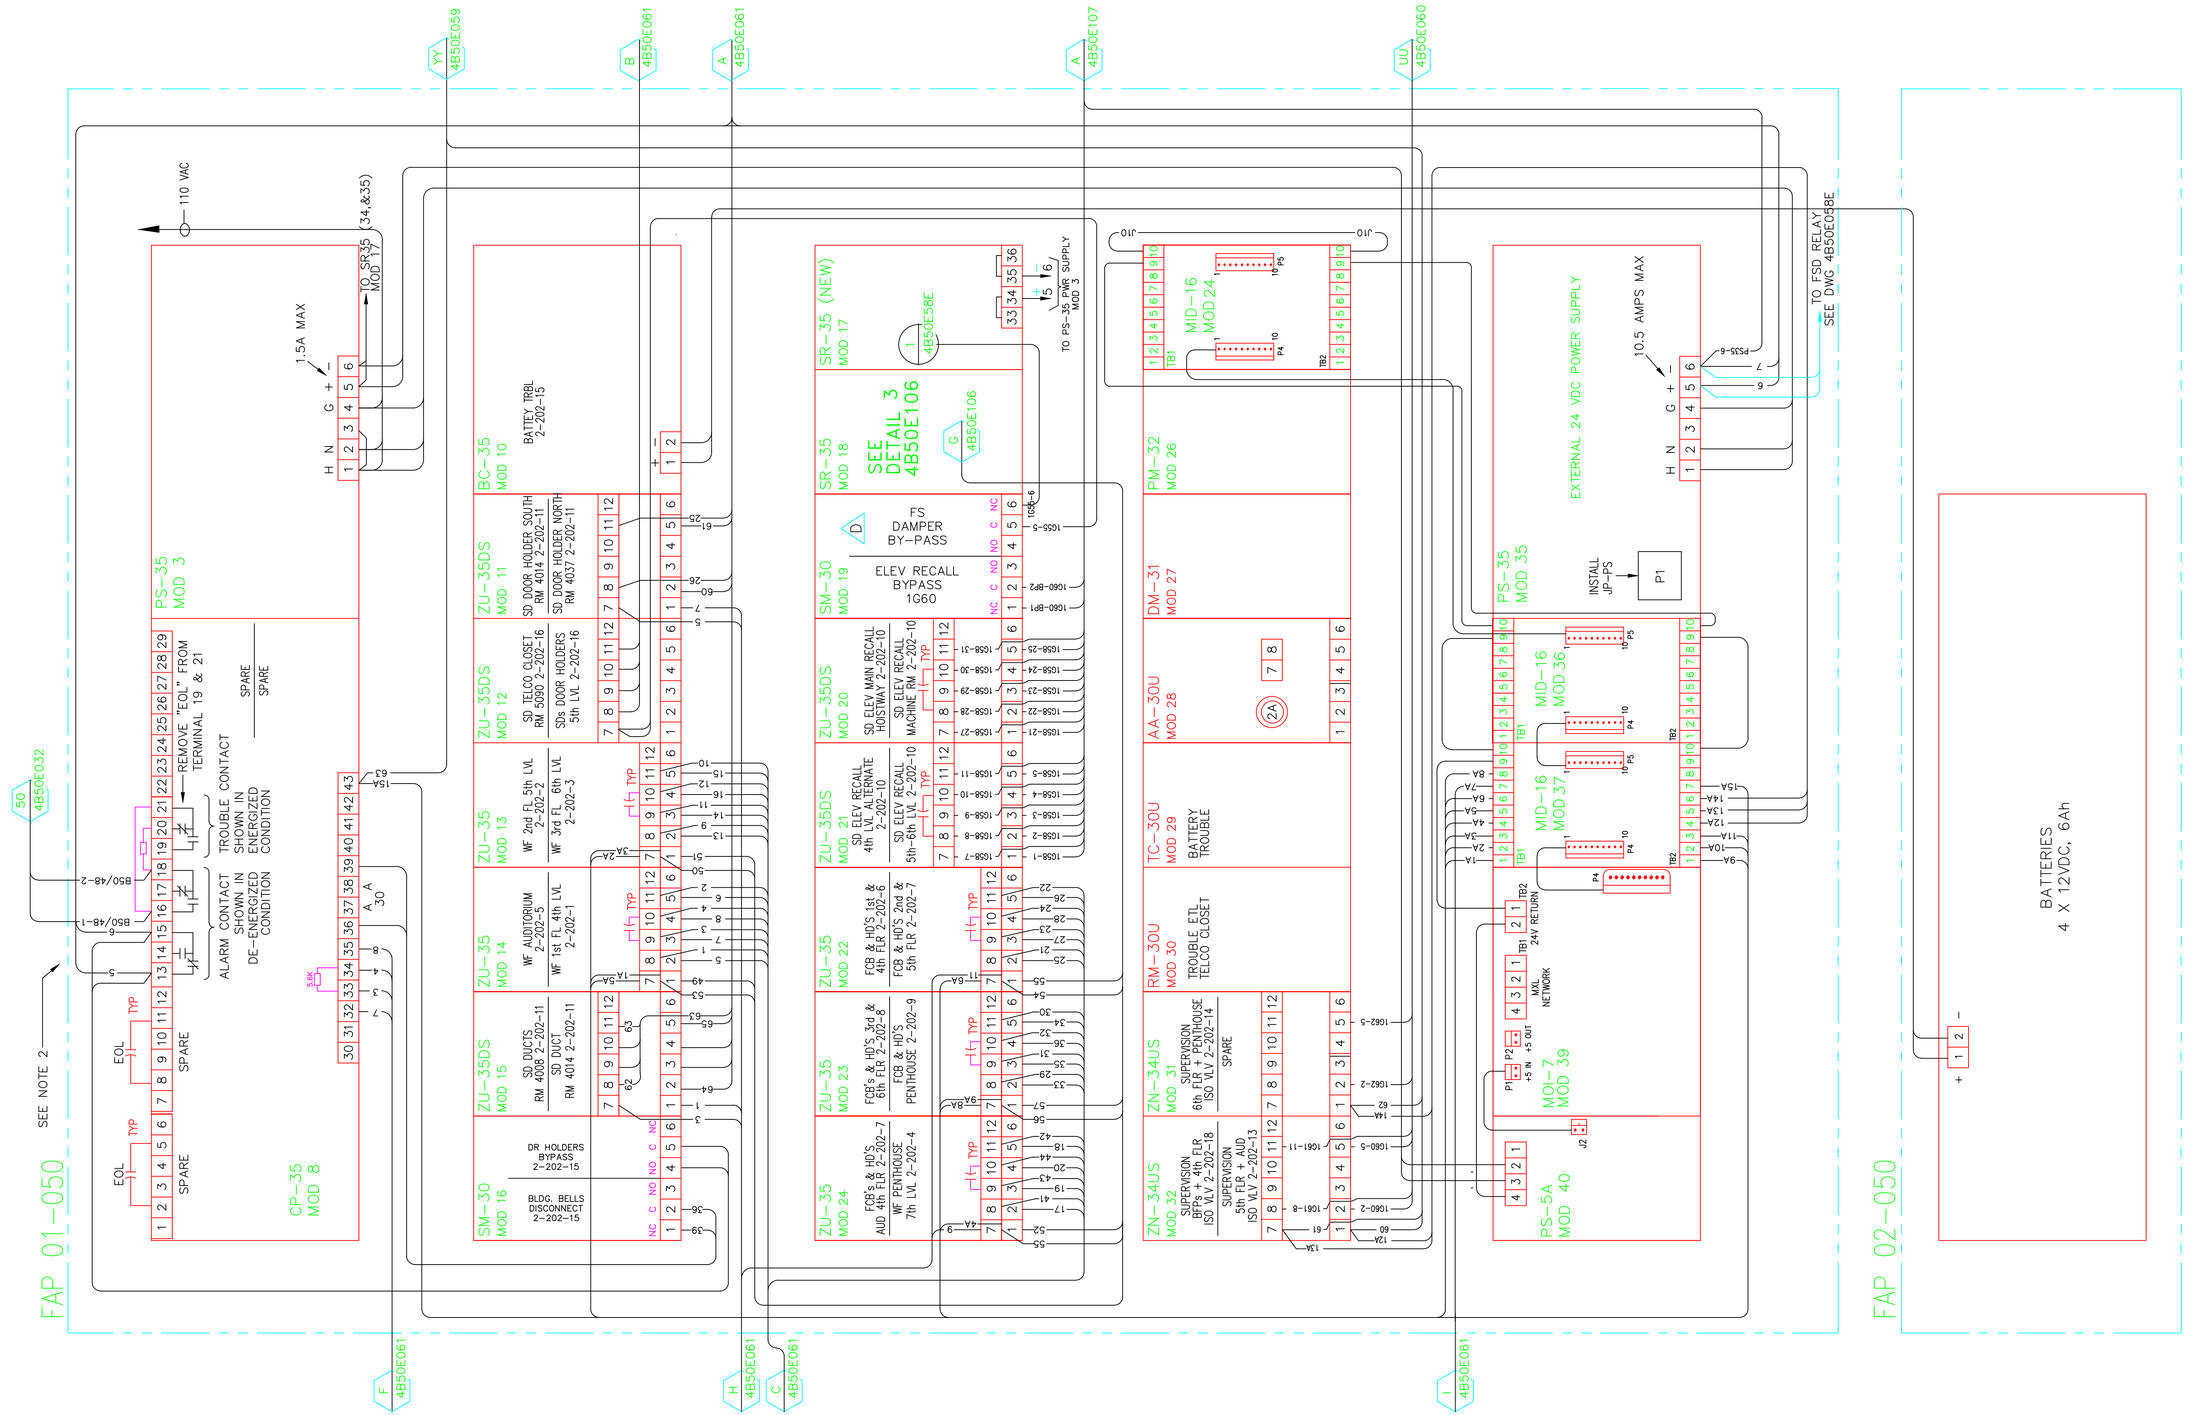

REFERENCE DWGS:

4B50E58	LOGIC DIAGRAM
4B50E59	SYSTEM 3 INTERCONNECTION DIAGRAM
4B50E60	TRANSMITTER 40 WIRING DIAGRAM
4B50E61	FIELD DEVICES INTERCONNECTION DIAGRAM
4B50E106	SYSTEM 3 MODULE WIRING SR33, PM32 & SR35
4B50E107	ELEVATOR RECALL SD & INTERFACE WIRING
4B50E108	RACEWAY, SD LOCATIONS AND ACCESS LOCATIONS

DISTRIBUTION LIST:

1-ELECTRIC SHOP 76 (FILE I)
1-STICK FILE (B90J)
ORIGINAL-FLAT FILE (B90F)

AS BUILT
E
5/7/2013

REVISION NUMBER	DRAWN BY	CHECKED BY	APPR'D BY	DATE	REMARKS
E	LDD	LDD	MCD	05/07/13	AS BUILT PER FIELD VERIFICATIONS
D	VDA	MCG	MCG	06/30/05	ADD SMOKE DETECTOR TO ZONE 1G55
C	AD	MCG	MCG	04/15/05	REVISED FOR MXL/DIGITIZE SYSTEMS
B	GMS	MCG	MCG	02/09/04	COMPLETE REWIRE. UPGRADE TO CP-35 & NEW MODULES
A			MCG		AUTOCAD CONVERSION OF DWG. 6B50E027 REV F

PROFESSIONAL SEAL (IF REVISION, APPLIES ONLY TO REVISED WORK)
ISSUE (PROGRESS, ESTIMATE, BID, CONSTRUCTION, CONFORMED, REVISION, RECORD)

50 FAP-01-050
FIRE ALARM SYSTEM
SYSTEM 3 INTERCONNECTION DIAGRAM

UNIVERSITY OF CALIFORNIA
LAWRENCE BERKELEY NATIONAL LABORATORY
FACILITIES DIVISION

DRAWN BY	LM
DATE	3/20/1997
CHECKED BY	
APPROVED BY	MCG
CAD FILE PATH	
SCALE	As Noted
DRAWING NO.	4B50E059E
SHEET	E1 1 OF 1
PROJECT NO.	WF4723