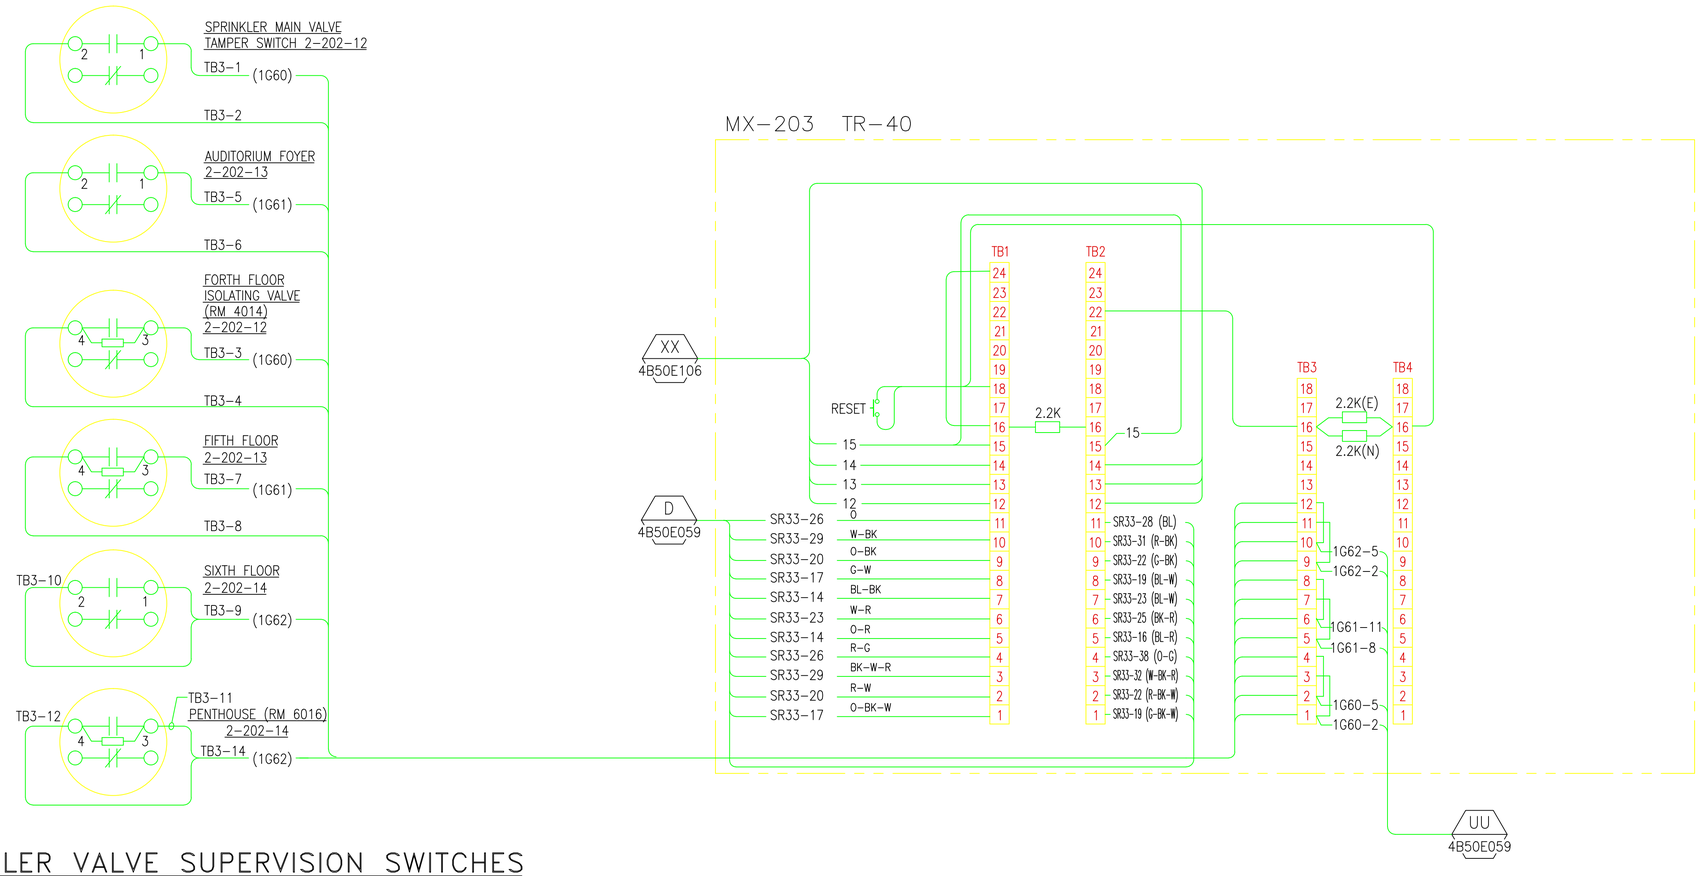

SPRINKLER VALVE SUPERVISION SWITCHES

COLOR ABBREVIATIONS:

BK	BLACK
BL	BLUE
G	GREEN
O	ORANGE
R	RED
W	WHITE

REFERENCE DWGS:

4B50E058 LOGIC DIAGRAM
4B50E059 SYSTEM 3 INTERCONNECTION DIAGRAM
4B50E060 TRANSMITTER 40 WIRING DIAGRAM
4B50E061 FIELD DEVICES INTERCONNECTION DIAGRAM
4B50E106 SYSTEM 3 MODULE WIRING SR33, PM32 & SR35
4B50E107 ELEVATOR RECALL SD & INTERFACE WIRING
4B50E108 RACEWAY, SD LOCATIONS AND ACCESS LOCATIONS
4B50E119 MID/MOI ARRANGEMENT & INTERCONNECTION DIAGRAM
4B50E097 SYSTEM 3 INTERCONNECTION DIAGRAM

AS BUILT
D
5/8/2013

REVISION NUMBER	DRAWN BY	CHECKED BY	APPR'D BY	DATE	REMARKS
D	LDD	LDD	MCD	05/08/13	AS BUILT PER FIELD VERIFICATIONS
C	AD	MCG	MCG	04/15/05	REVISED FOR MXL/DIGITIZE SYSTEMS
B	GMS	MCG	MCG	12/16/03	ADD ELEVATOR RECALL; COMBINED ZONES TO 1G61
A	LM		MG	3/27/97	AUTOCAD CONVERSION OF DWG. 6B50E027 REV F

PROFESSIONAL SEAL (IF REVISION, APPLIES ONLY TO REVISED WORK)
ISSUE (PROGRESS, ESTIMATE, BID, CONSTRUCTION, CONFORMED, REVISION, RECORD)

50 FAP 01-050 TR-40
FIRE ALARM SYSTEM
TRANSMITTER 40 WIRING DIAGRAM

UNIVERSITY OF CALIFORNIA
LAWRENCE BERKELEY NATIONAL LABORATORY
FACILITIES DIVISION

DRAWN BY LM DATE 3/18/1997
CHECKED BY
APPROVED BY MCG 3/27/1997
CAD FILE PATH
SCALE As Noted
DRAWING NO. 4B50E060D
SHEET E1 1 OF 1
PROJECT NO. WF4723