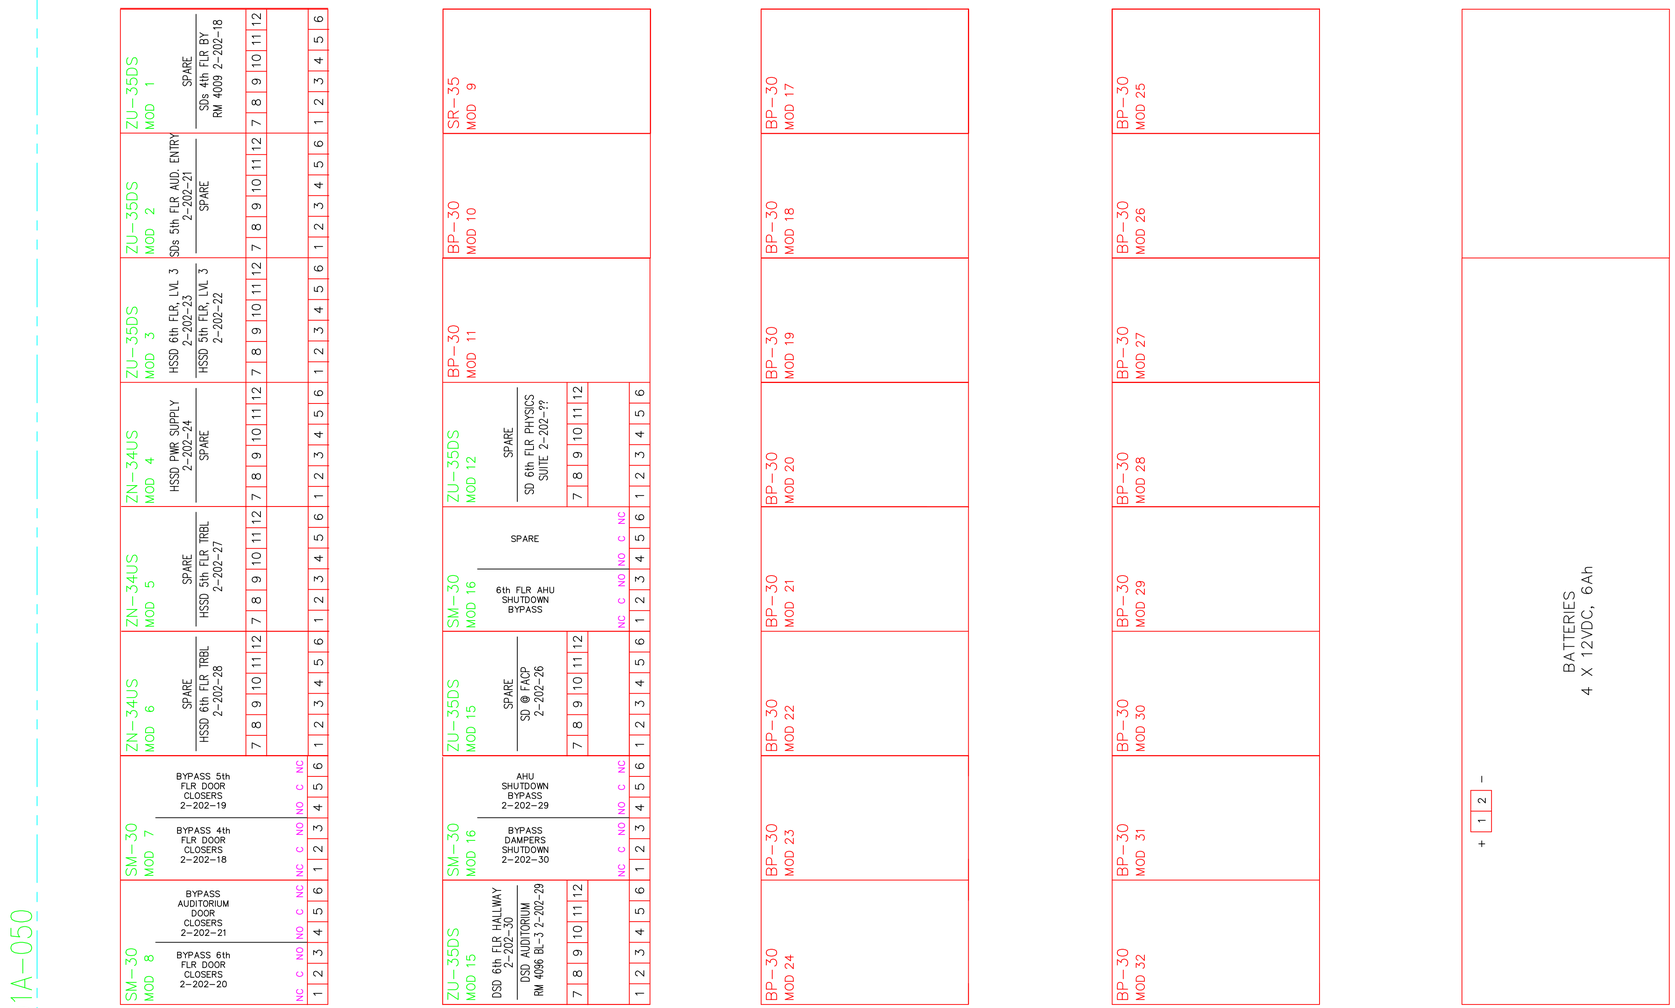

FIELD PROVIDE WIRING

REFERENCE DWGS:

4B50E58	LOGIC DIAGRAM
4B50E59	SYSTEM 3 INTERCONNECTION DIAGRAM
4B50E60	TRANSMITTER 40 WIRING DIAGRAM
4B50E61	FIELD DEVICES INTERCONNECTION DIAGRAM
4B50E106	SYSTEM 3 MODULE WIRING SR33, PM32 & SR35
4B50E107	ELEVATOR RECALL SD & INTERFACE WIRING
4B50E108	RACEWAY, SD LOCATIONS AND ACCESS LOCATIONS
4B50E119	MID/MOI ARRANGEMENT

AS BUILT

5/7/2013

PROFESSIONAL SEAL (IF REVISION, APPLIES ONLY TO REVISED WORK)

ISSUE (PROGRESS, ESTIMATE, BID, CONSTRUCTION, CONFORMED, REVISION, RECORD)

REVISION NUMBER	DRAWN BY	CHECKED BY	APPR'D BY	DATE	REMARKS
_	LDD	LDD	MCD	05/07/13	AS BUILT PER FIELD VERIFICATIONS

50 FAP-01-050

FIRE ALARM SYSTEM

SYSTEM 3 INTERCONNECTION DIAGRAM

UNIVERSITY OF CALIFORNIA
LAWRENCE BERKELEY NATIONAL LABORATORY
FACILITIES DIVISION

DRAWN BY	LDD	DATE 5/7/2013
CHECKED BY	LDD	5/7/2013
APPROVED BY	MCD	5/7/2013
CAD FILE PATH		
SCALE	As Noted	
DRAWING NO.	4B50E097_	SHEET E1
PROJECT NO.	00000	1 OF 1