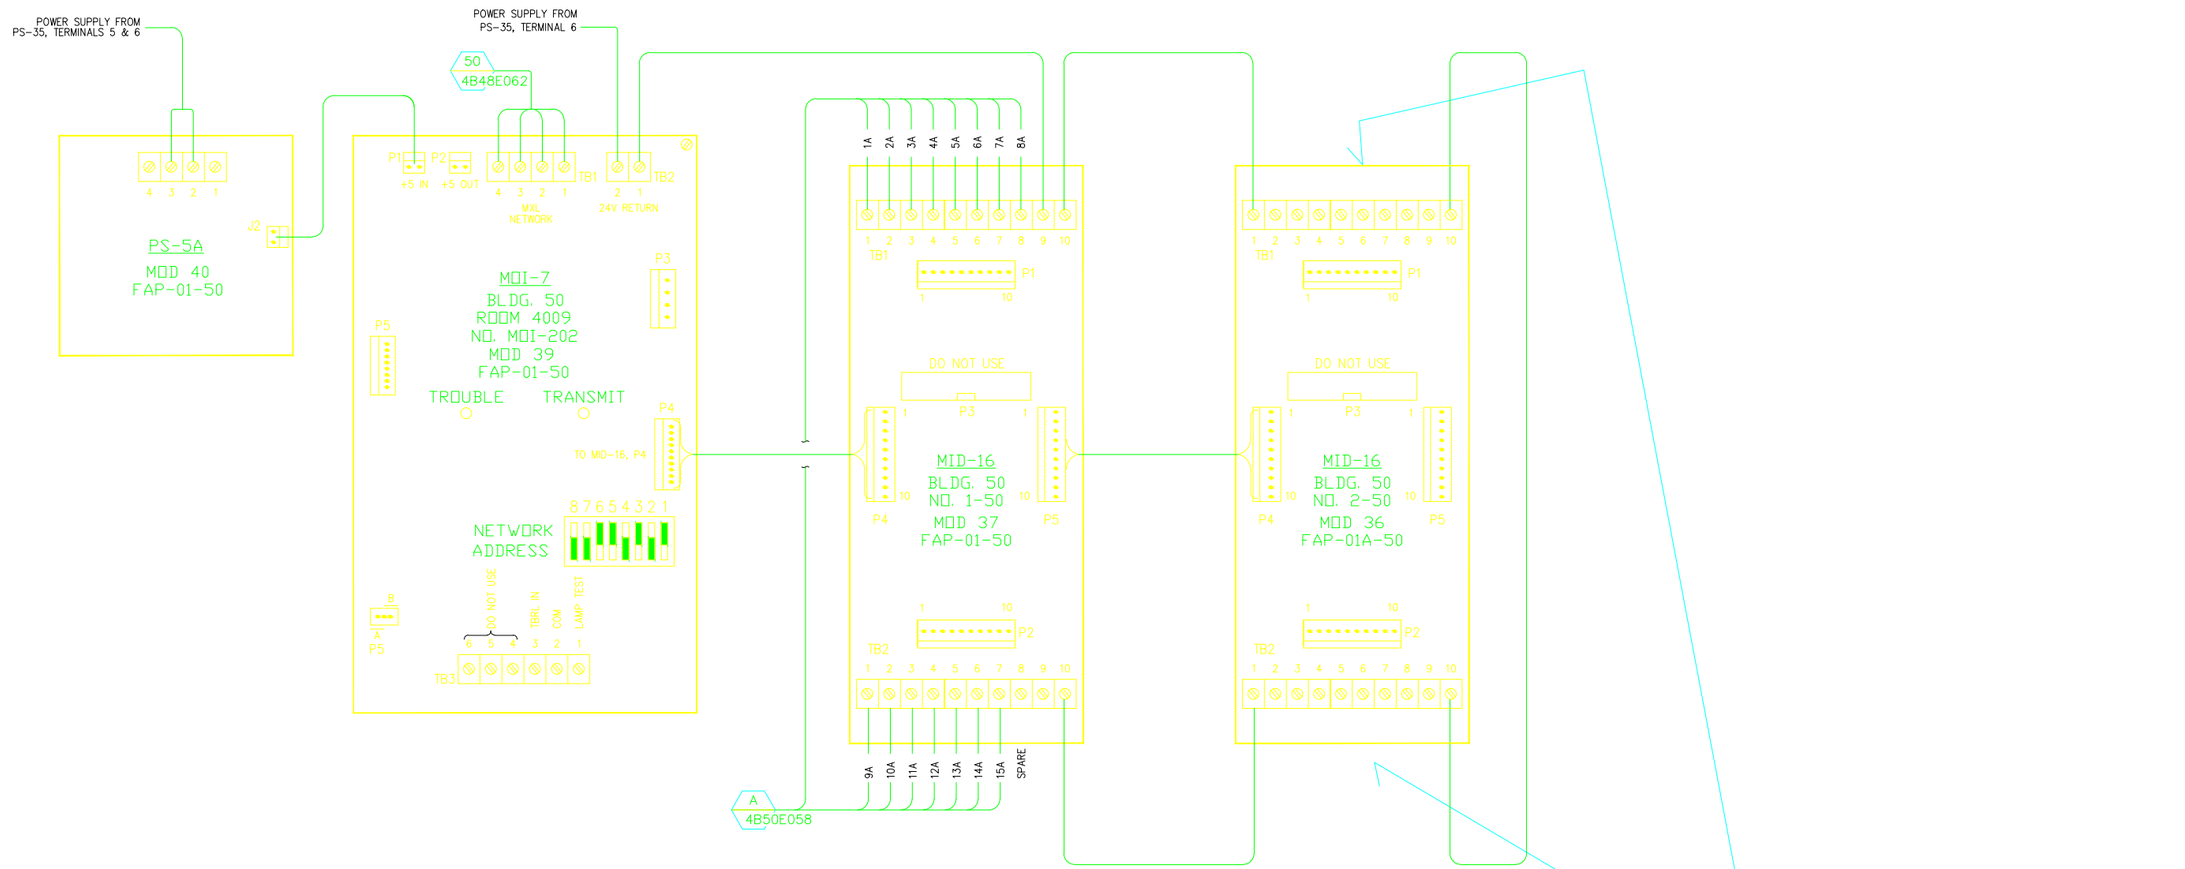

OLD ADDRESS	DESCRIPTION	MID-16 TERMINATION	MODULE TYPE & NO.	MXL NO. 02-50B ADDRESS
1G49	WATER FLOW 1ST-4TH LVL	TB. 1 NO. 1	MID-16 NO. 1-50	2-202-1
1G50	WATER FLOW 2ND-5TH LVL	TB. 1 NO. 2	MID-16 NO. 1-50	2-202-2
1G51	WATER FLOW 3RD & 6TH LVL	TB. 1 NO. 3	MID-16 NO. 1-50	2-202-3
1G52	WATER FLOW PENTHOUSE	TB. 1 NO. 4	MID-16 NO. 1-50	2-202-4
1G53	WATER FLOW AUDITORIUM	TB. 1 NO. 5	MID-16 NO. 1-50	2-202-5
1G54	FCB & HD'S 1ST-4TH LVL	TB. 1 NO. 6	MID-16 NO. 1-50	2-202-6
1G55	FCB & HD'S 2ND/5TH/AUDITORIUM	TB. 1 NO. 7	MID-16 NO. 1-50	2-202-7
1G56	FCB & HD'S 3RD & 6TH LVL	TB. 1 NO. 8	MID-16 NO. 1-50	2-202-8
1G57	FCB & HD'S ROOF/PENTHOUSE	TB. 2 NO. 1	MID-16 NO. 1-50	2-202-9
1G58	SD ELEVATOR RECALL	TB. 2 NO. 2	MID-16 NO. 1-50	2-202-10
1G59	SD-DUCTS	TB. 2 NO. 3	MID-16 NO. 1-50	2-202-11
1G60	VALVE SUPERVISION RISER VALVE & 4TH LVL	TB. 2 NO. 4	MID-16 NO. 1-50	2-202-12
1G61	VALVE SUPERVISION 2ND/5TH & AUDITORIUM	TB. 2 NO. 5	MID-16 NO. 1-50	2-202-13
1G62	VALVE SUPERVISION RISER/4TH/6TH & AUDITORIUM	TB. 2 NO. 6	MID-16 NO. 1-50	2-202-14
1G63	SYSTEM 3 TROUBLE	TB. 2 NO. 7	MID-16 NO. 1-50	2-202-15
1G64	MX-203 TROUBLE	TB. 2 NO. 8	N/A	N/A

OLD ADDRESS	DESCRIPTION	MID-16 TERMINATION	MODULE TYPE & NO.	MXL NO. 02-50B ADDRESS
	WATER FLOW 1ST-4TH LVL	TB. 1 NO. 1	MID-16 NO. 2-50	N/A
	BYPASS 4TH FLR DOOR CLOSER	TB. 1 NO. 2	MID-16 NO. 2-50	2-202-18
	BYPASS 5TH FLR DOOR CLOSER	TB. 1 NO. 3	MID-16 NO. 2-50	2-202-19
	BYPASS 6TH FLR DOOR CLOSER	TB. 1 NO. 4	MID-16 NO. 2-50	2-202-20
	BYPASS AUDITORIUM DOOR CLOSER	TB. 1 NO. 5	MID-16 NO. 2-50	2-202-21
	HSSD 5TH FLR LEVEL 3	TB. 1 NO. 6	MID-16 NO. 2-50	2-202-22
	HSSD 6TG FLR LEVEL 3	TB. 1 NO. 7	MID-16 NO. 2-50	2-202-23
	HSSD POWER SUPPLY	TB. 1 NO. 8	MID-16 NO. 2-50	2-202-24
		TB. 2 NO. 1	MID-16 NO. 2-50	N/A
	SD @ FACP	TB. 2 NO. 2	MID-16 NO. 2-50	2-202-26
	HSSD 5TH FLR TROUBLE	TB. 2 NO. 3	MID-16 NO. 2-50	2-202-27
	HSSD 6TH FLR TROUBLE	TB. 2 NO. 4	MID-16 NO. 2-50	2-202-28
	DSD AUD. RM 4096 BL-3	TB. 2 NO. 5	MID-16 NO. 2-50	2-202-29
	DSD 6TH FLR HALLWAY	TB. 2 NO. 6	MID-16 NO. 2-50	2-202-30
		TB. 2 NO. 7	MID-16 NO. 2-50	N/A
		TB. 2 NO. 8	MID-16 NO. 2-50	N/A

AS BUILT

C
5/7/2013

PROFESSIONAL SEAL (IF REVISION, APPLIES ONLY TO REVISED WORK)

ISSUE (PROGRESS, ESTIMATE, IBID, CONSTRUCTION, CONFORMED, REVISION, RECORD)

REVISION NUMBER	DRAWN BY	CHECKED BY	APPR'D BY	DATE	REMARKS
C	LDD	LDD	MCD	005/07/13	AS BUILT PER FIELD VEIFICATIONS
B	AD	LDD	MCD	03/06/06	REVISED FOR MXL COPPER LOOP
A	AD	MCG	MCG	04/13/05	REVISED FOR MXL/DIGITIZE SYSTEMS

50
REPLACEMENT FIRE ALARM SYSTEM
MOI/MID MODULE ARRANGEMENT

UNIVERSITY OF CALIFORNIA
LAWRENCE BERKELEY NATIONAL LABORATORY
FACILITIES DIVISION

DRAWN BY	AD	DATE 4/12/2005
CHECKED BY	MCG	4/12/2005
APPROVED BY	MCG	4/12/2005
CAD FILE PATH		
SCALE	Full	
DRAWING NO.	4B50E119C	SHEET
PROJECT NO.	FA8040	1 OF 1