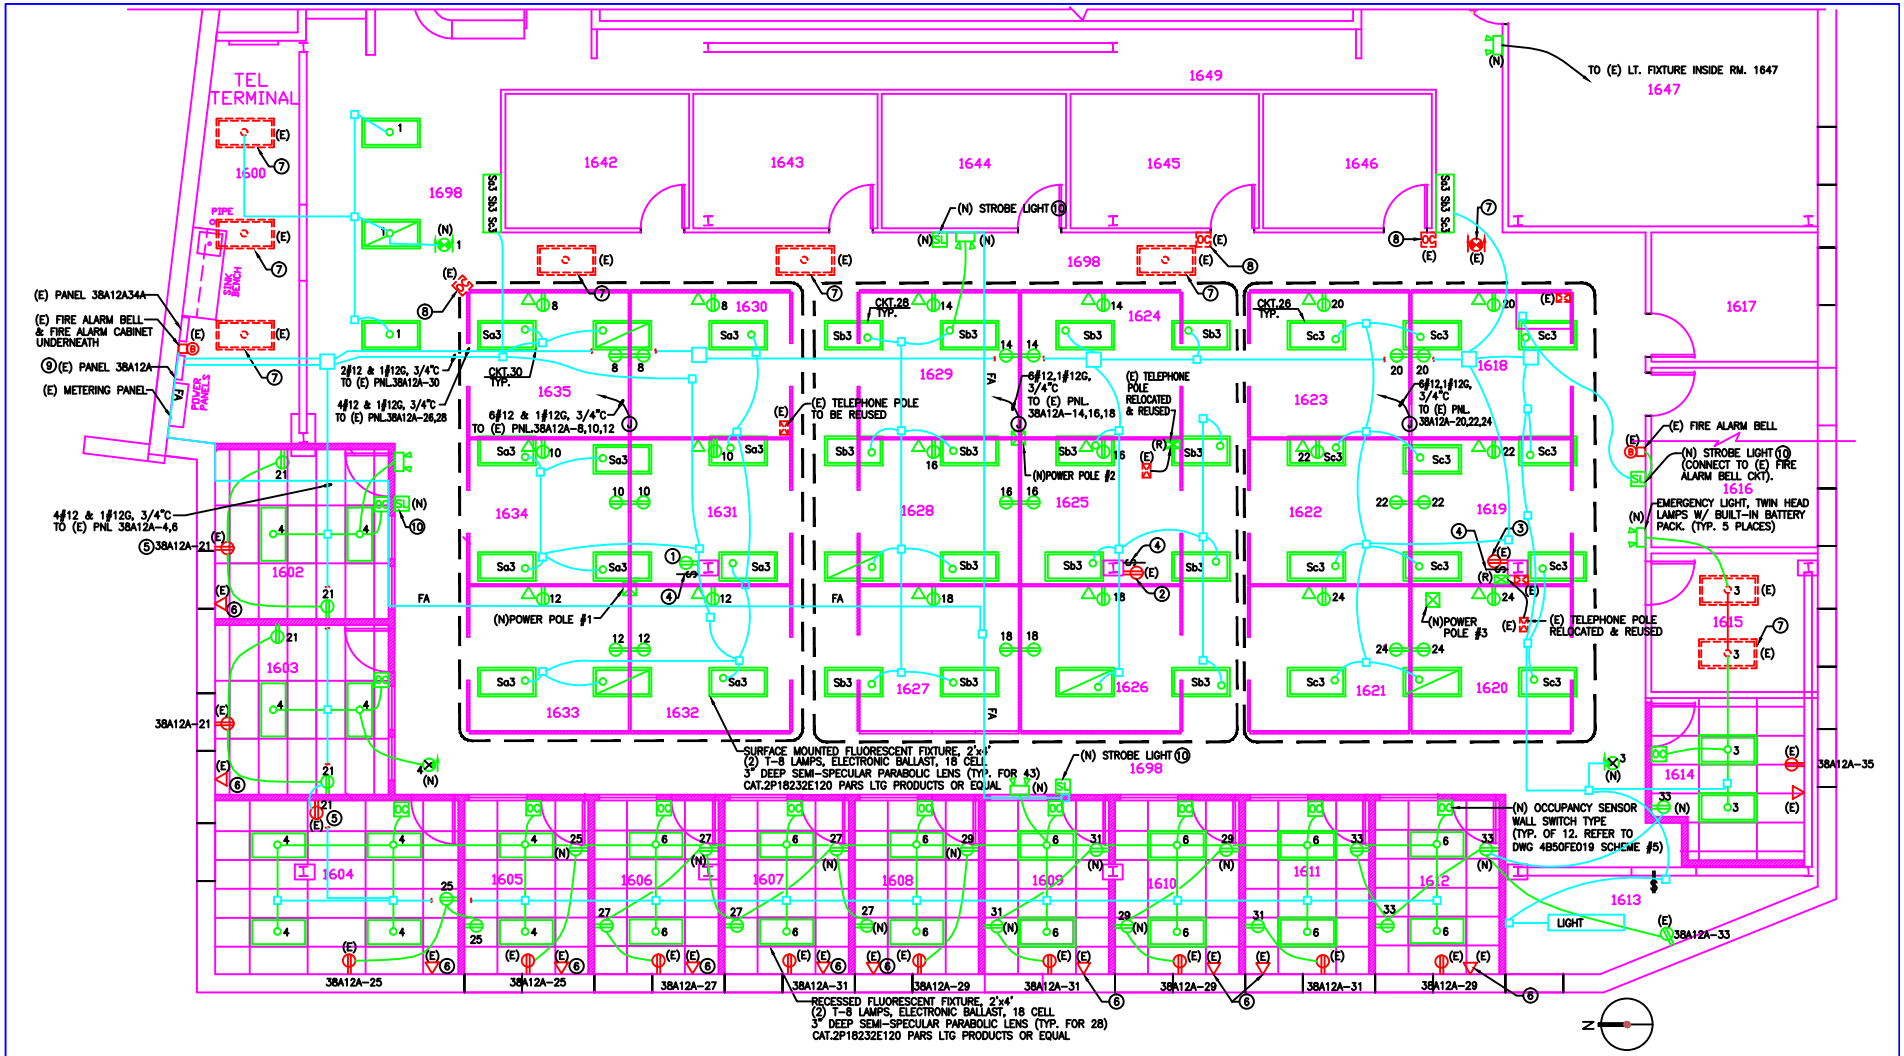

1 PARTIAL FLOOR PLAN–LIGHTING, POWER & SIGNAL

SCALE: 1/4"=1'-0"

A	FWD	MCG	MCG	9/27/97	AS BUILT
REVISION NUMBER	DRAWN BY	CHECKED BY	APPROVED BY	DATE	REMARKS

50F
FLOOR MODIFICATIONS
PARTIAL FLOOR PLAN–LIGHTING

UNIVERSITY OF CALIFORNIA LAWRENCE BERKELEY LABORATORY
FACILITIES DEPARTMENT

DRAWN BY	IPM	04/28/97
CHECKED BY	VA	04/28/97
APPROVED BY	ROB	04/30/97
CAD FILE PATH	00002896	
SCALE	1/4=1-0	
DRAWING NO.	4B50FE020A	
PROJECT NO.	028037	
SHEET	E-2	2 OF 2