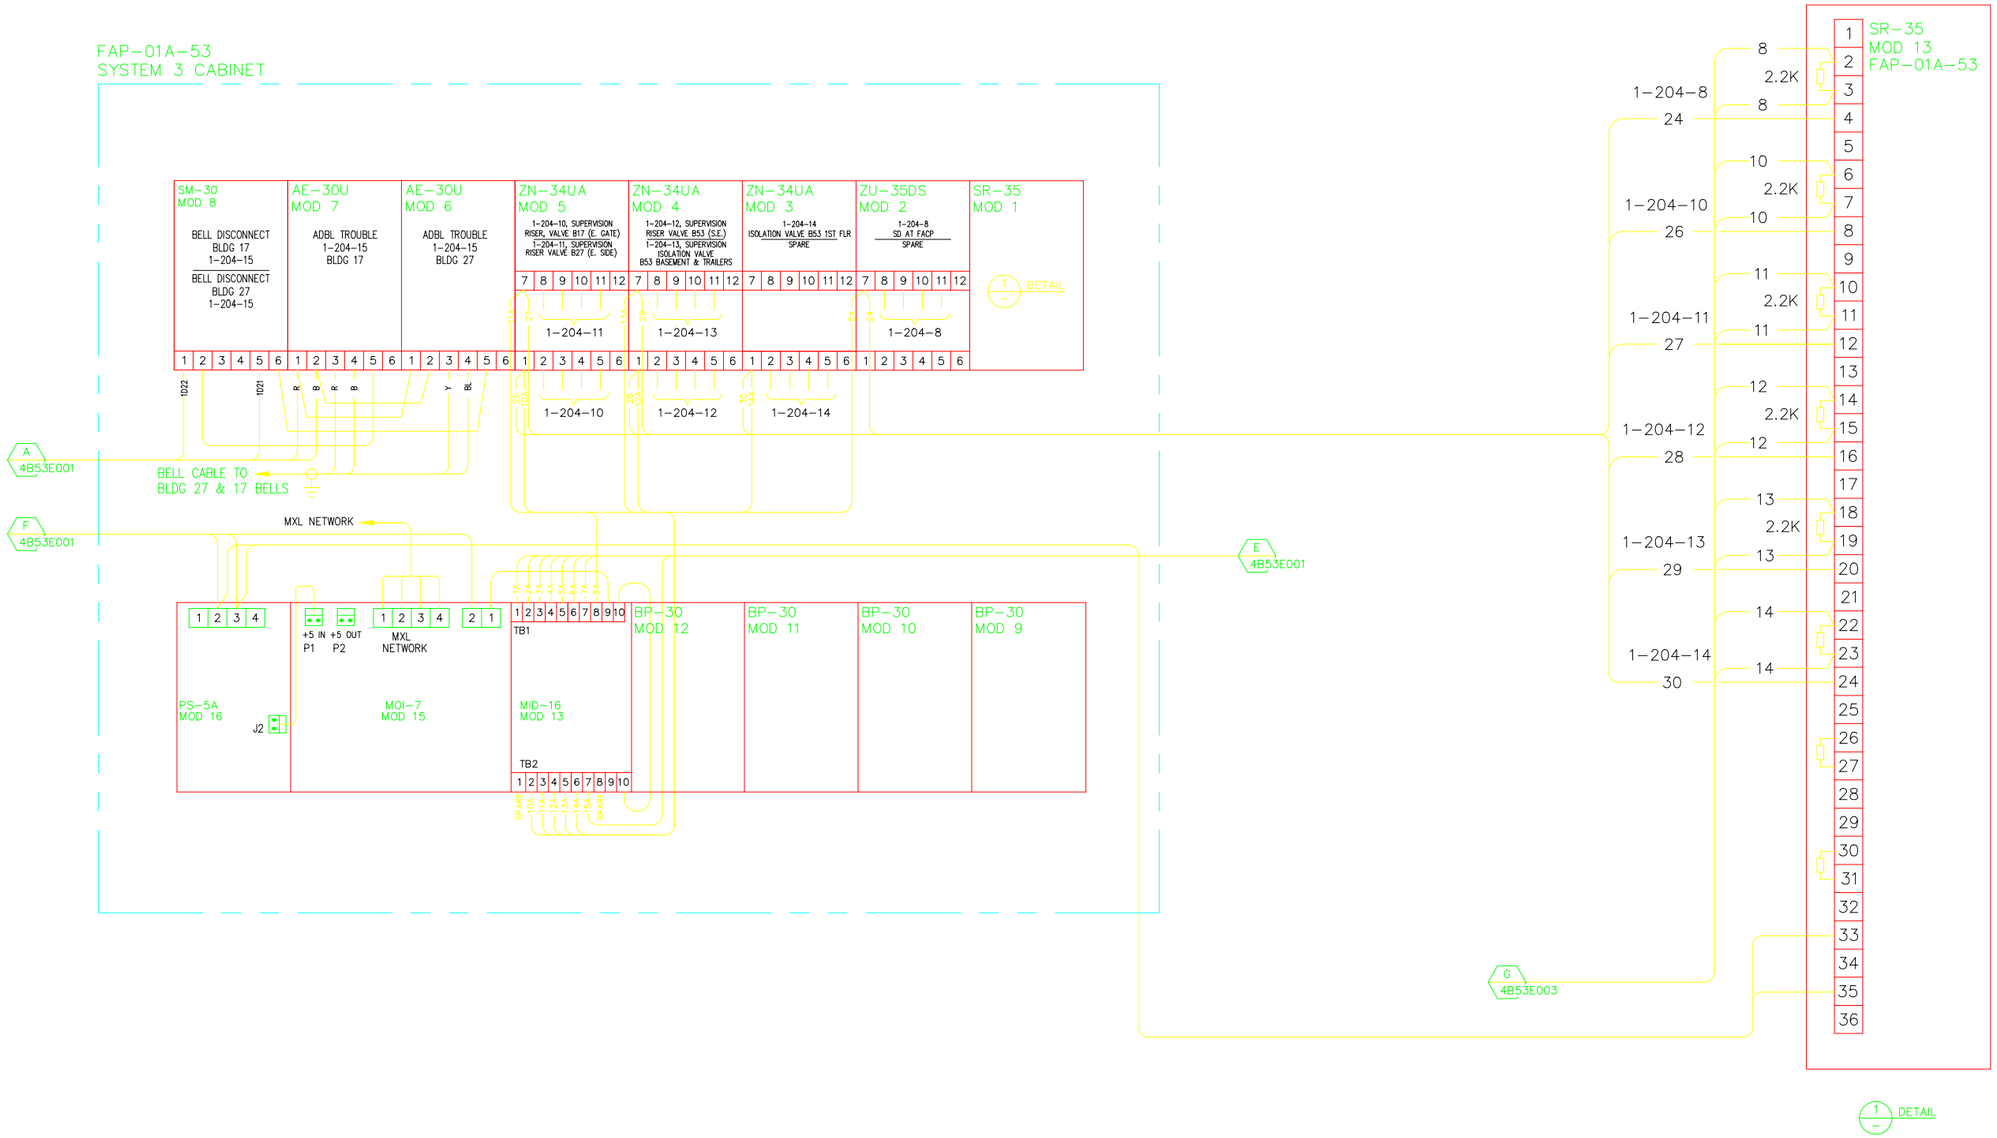

REFERENCE DRAWINGS:

FIRE ALARM CONNECTION DIAGRAM	4B53E001
LOGIC DIAGRAM MX-203, TR120	4B53E007
SYS 3+SR-35 CONNECTION DIGRAM	4B53E008
MOI + MID ARRANGEMENT	4B53E009
DIGITIZE NETWORK	4B48E032
MXL NETWORK	4B48E058

AS BUILT

B
5/14/2013

REVISION NUMBER	DRAWN BY	CHECKED BY	APPR'D BY	DATE	REMARKS
B	LDD	LDD	MCD	05/14/13	AS BUILT PER FIELD VERIFICATIONS
A				12/01/09	AS BUILT

PROFESSIONAL SEAL (IF REVISION, APPLIES ONLY TO REVISED WORK)

ISSUE (PROGRESS, ESTIMATE, BID, CONSTRUCTION, CONFORMED, REVISION, RECORD)

53 FIRE ALARM SYSTEM
SYSTEM 3 FAP-01A-53 & SR-35
CONNECTION DIAGRAM

UNIVERSITY OF CALIFORNIA
LAWRENCE BERKELEY NATIONAL LABORATORY
FACILITIES DIVISION

DRAWN BY MRC	DATE 9/3/2004	
CHECKED BY AD	9/3/2004	
APPROVED BY MCG	9/3/2004	
CAD FILE PATH		
SCALE Full		
DRAWING NO. 4B53E008B	SHEET FA	
PROJECT NO. FB4010	1 OF 1	