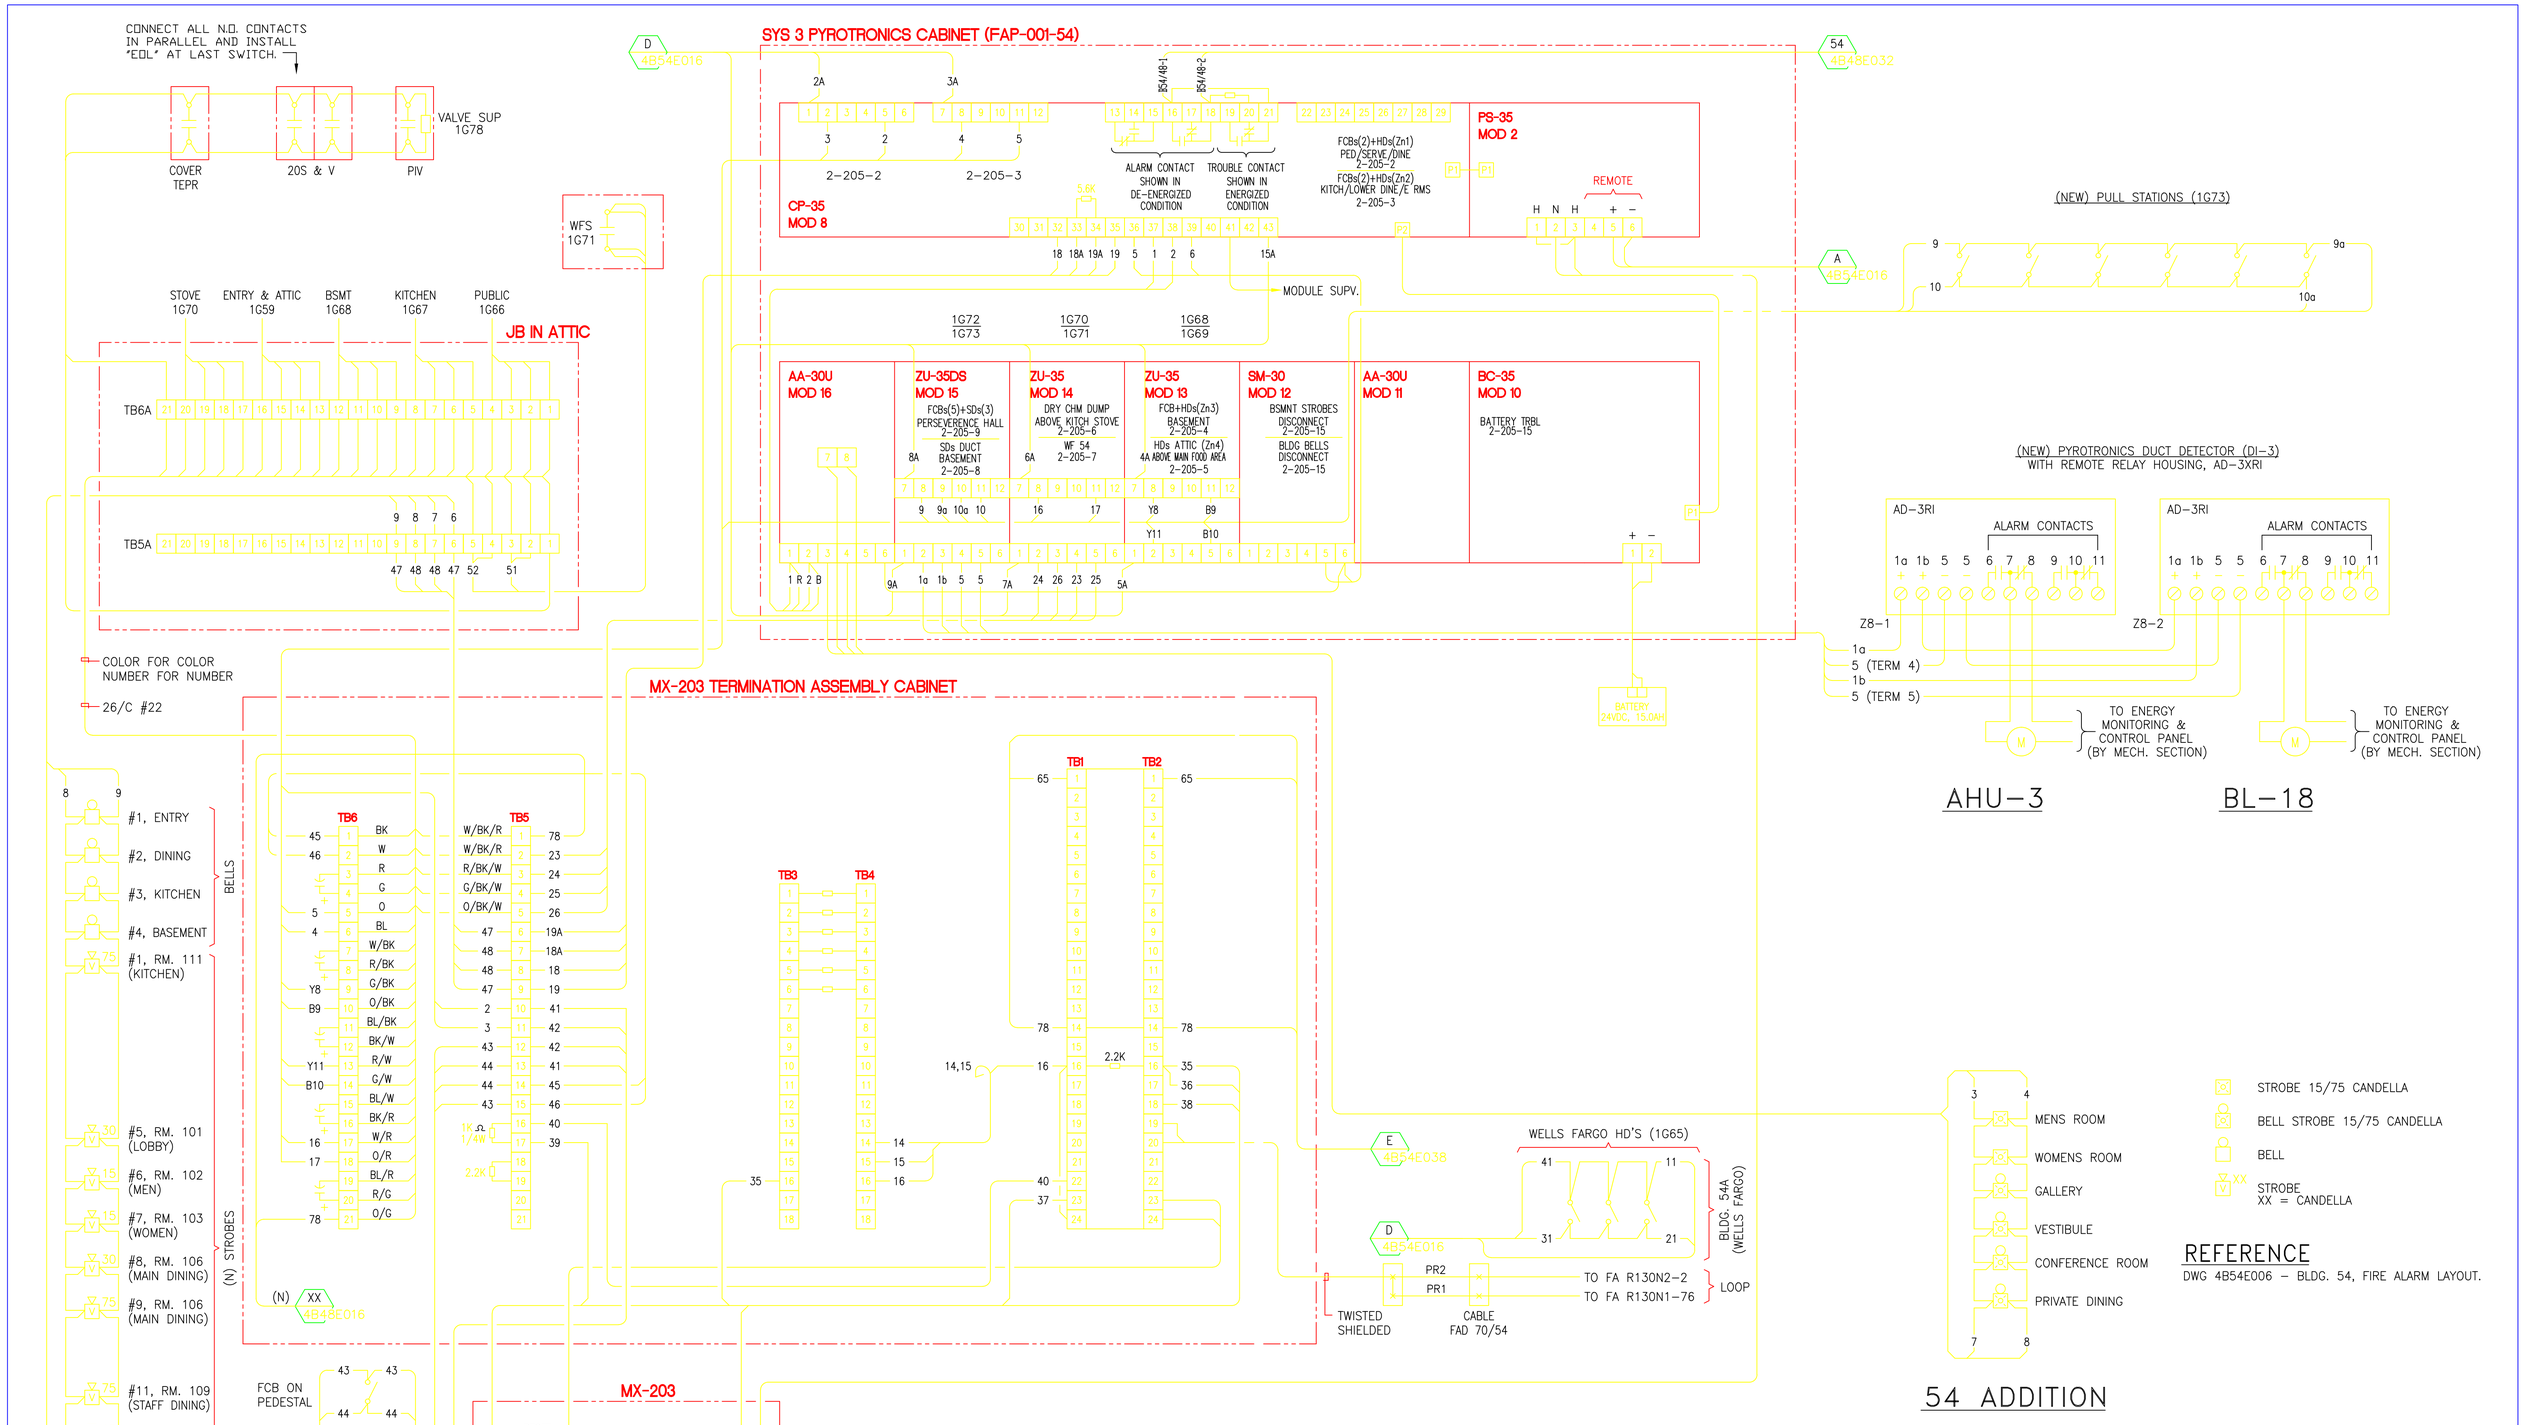

REVISION NUMBER	DRAWN BY	CHECKED BY	APPR'D BY	DATE	REMARKS
I	LDD	LDD	MCD	05/14/13	AS BUILT PER FIELD VERIFICATIONS
H	MRC	AD	MCG	7/1/04	PHASE III FIRE ALARM SYSTEM UPGRADE
G	ROB	MCG	MCG	9/25/97	AS-BUILT 54 ADDITION
F	LM	LM	M.G.	3/13/97	MOVED LOGIC DWG. TO DWG. 4B54E016
E	V.V.	G.W.	M.G.	3/29/96	REDRAWN IN CAD & ADDED STROBES.
D	R.G.			10/26/92	ADDED 1G71 & 1G78
C	L.S.R.			11/2/88	SR-32 MOD 10 CHANGED TO SR-33

54
FIRE ALARM SYSTEM PLAN

UNIVERSITY OF CALIFORNIA LAWRENCE BERKELEY LABORATORY
FACILITIES DEPARTMENT

DRAWN BY VV	DATE 3/29/1996	
CHECKED BY		
APPROVED BY MCG	3/29/1996	
CAD FILE PATH		
SCALE As Noted		
DRAWING NO. 4B54E007I		SHEET 1 OF 1
PROJECT NO. FB4010		