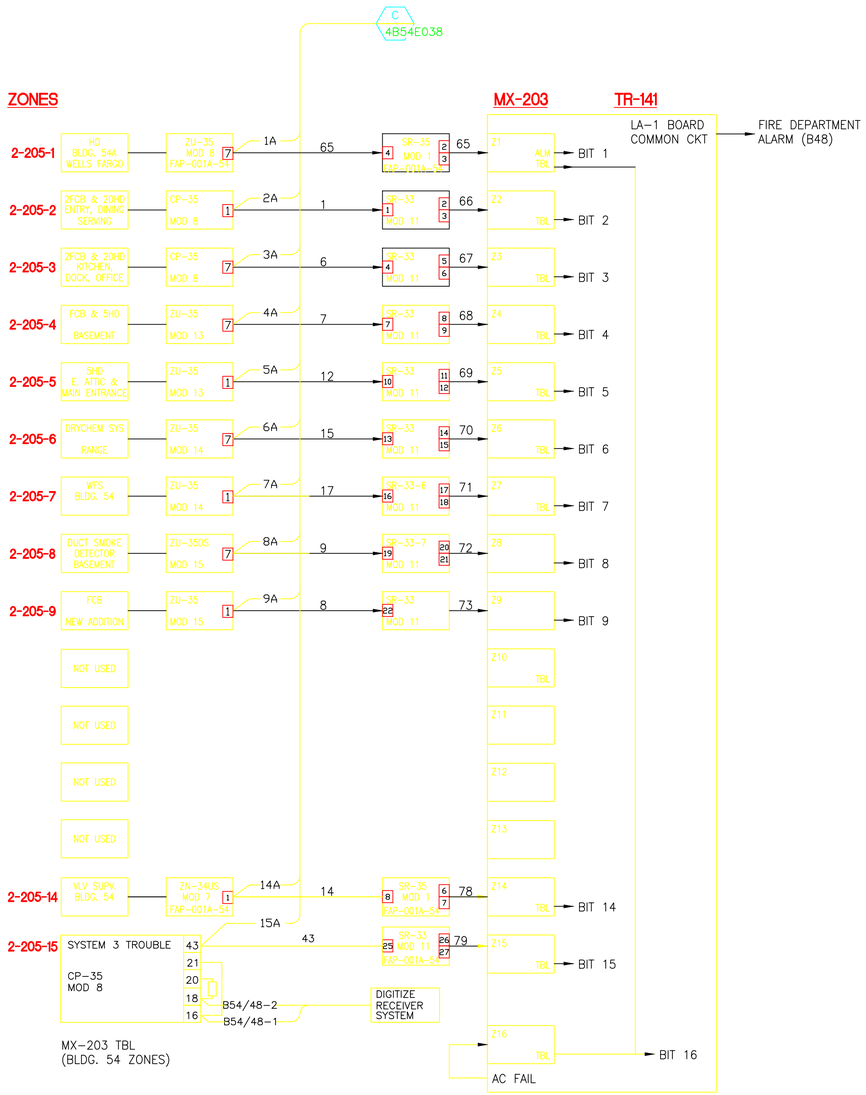

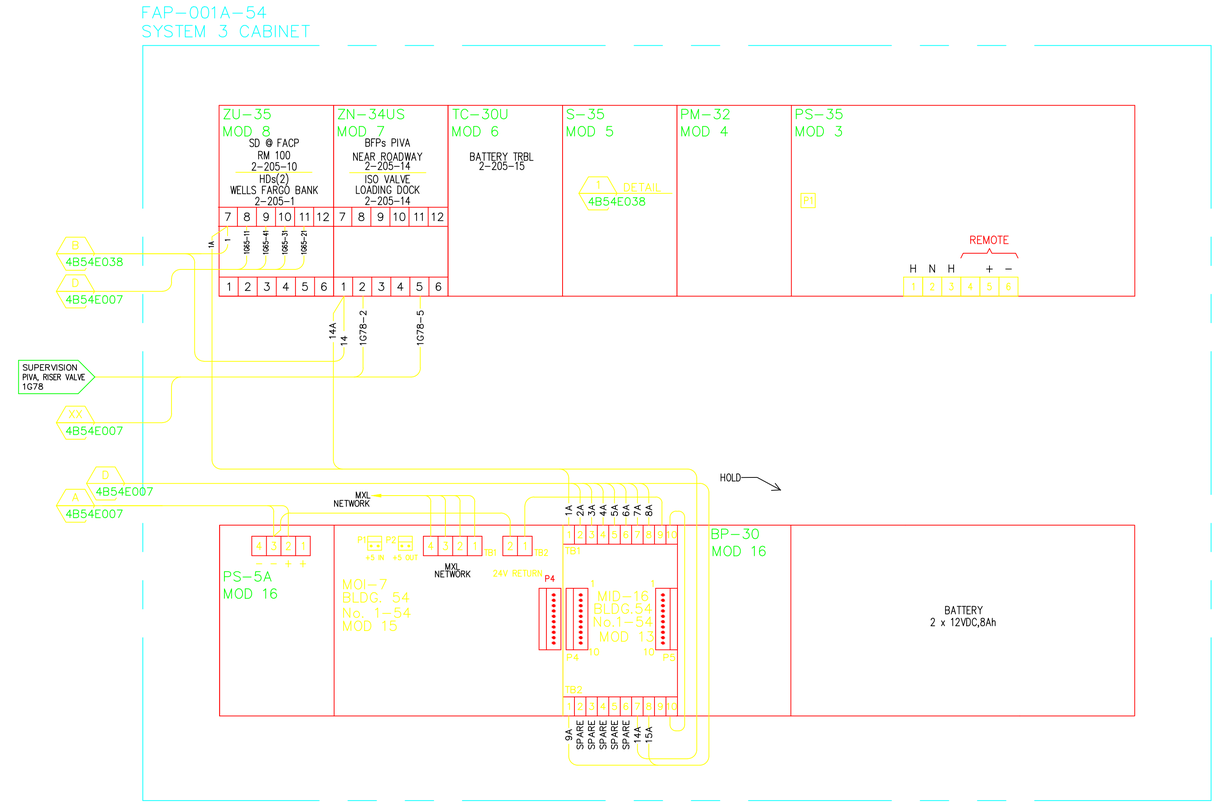

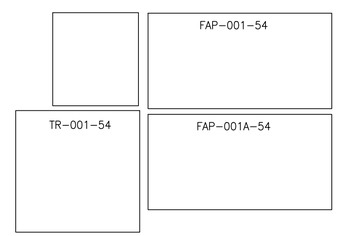

ELEVATION-ROOM 105

SCALE: NOT TO SCALE

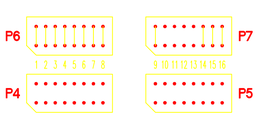

AUDIBLE ALARM LOGIC DIAGRAM

PROGRAM PLUGS
TRANSMITTER ID SWITCH
00101000 = (40+1) = 41 ON LOOP 1 = 141

AS BUILT

D
5/15/2013

REVISION NUMBER	DRAWN BY	CHECKED BY	APPR'D BY	DATE	REMARKS
D	LDD	LDD	MCD	05/15/13	AS BUILT PER FIELD VERIFICATIONS
C	MRC	AD	MCG	7/7/04	PHASE III FIRE ALARM SYSTEM UP-GRADE
B	ROB	MCG	MCG	9/25/97	AS-BUILT 54 ADDITION
A	LM		MCG	3/14/97	MOVED LOGIC DIAG FROM 4B54E007

PROFESSIONAL SEAL (IF REVISION, APPLIES ONLY TO REVISED WORK)

ISSUE (PROGRESS, ESTIMATE, BID, CONSTRUCTION, CONFORMED, REVISION, RECORD)

54 FIRE ALARM SYSTEM
LOGIC DIAGRAM AND SYSTEM 3 CABINET
FAP-001A-54 CONNECTION DIAGRAMS

UNIVERSITY OF CALIFORNIA
LAWRENCE BERKELEY NATIONAL LABORATORY
FACILITIES DIVISION

DRAWN BY VV — DATE 3/29/1996
CHECKED BY
APPROVED BY MCG — 3/29/1996
CAD FILE PATH
SCALE As Noted
DRAWING NO. 4B54E016D
SHEET 1 OF 1
PROJECT NO. FB4010