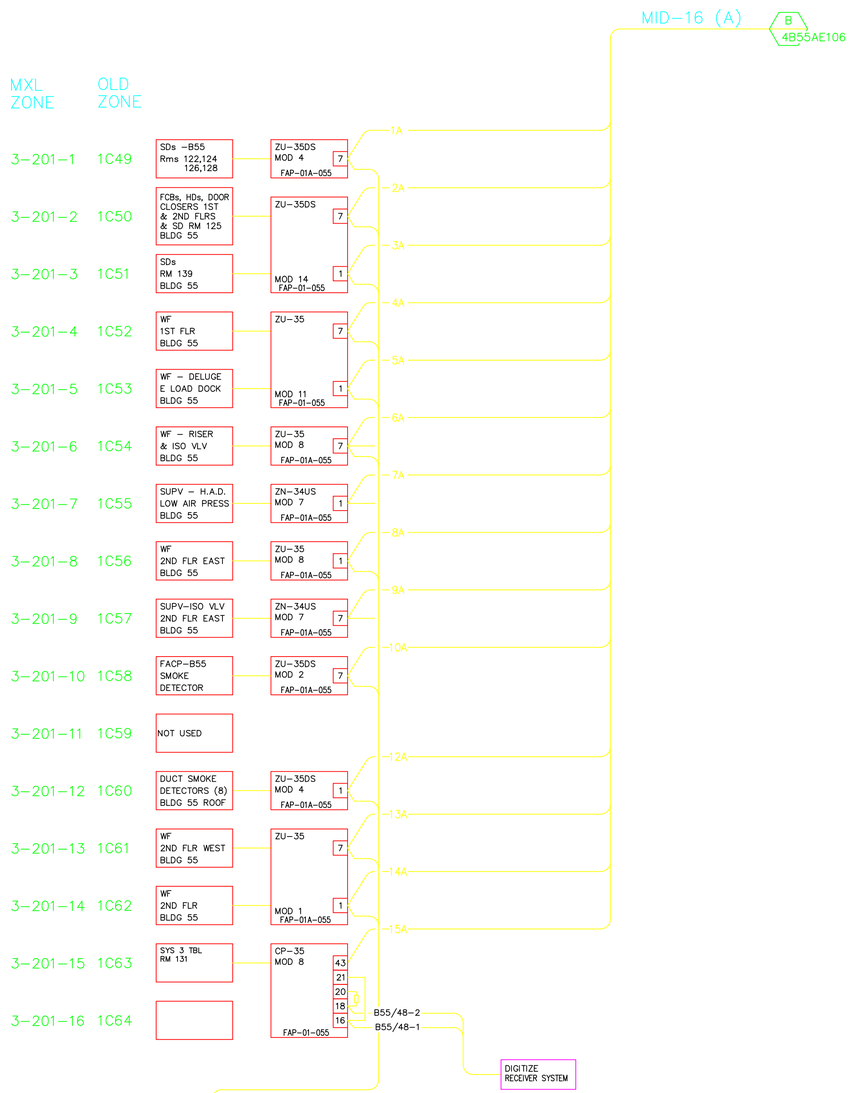

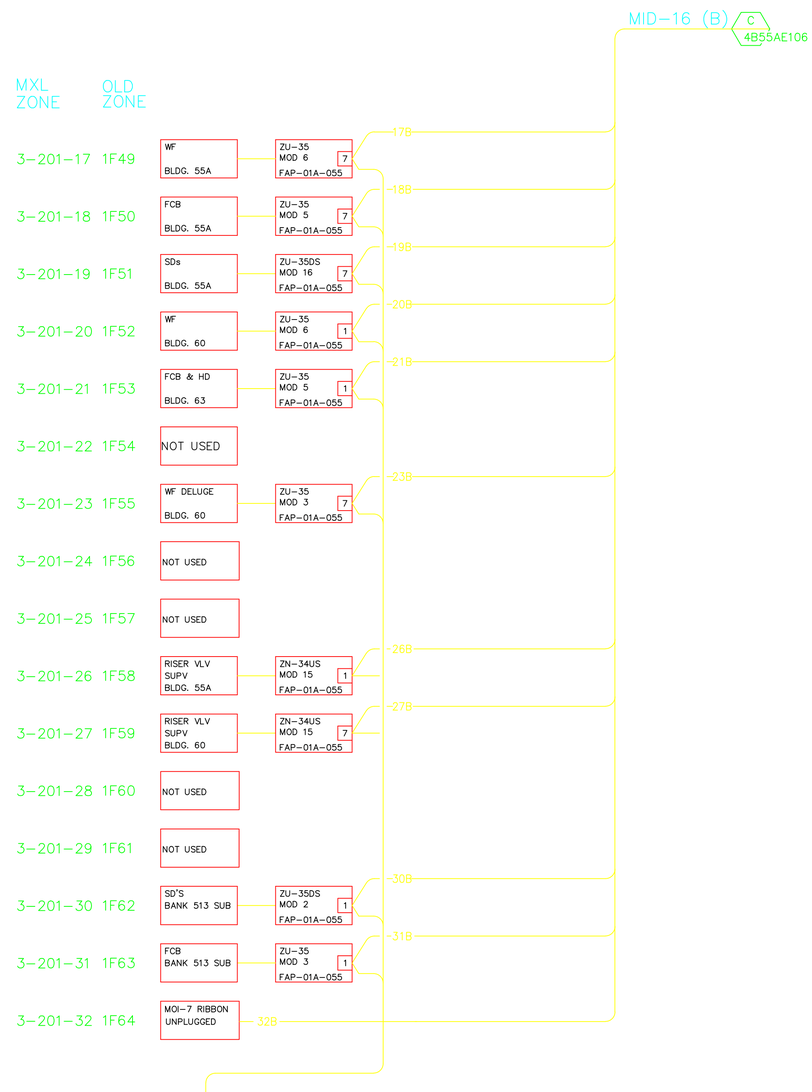

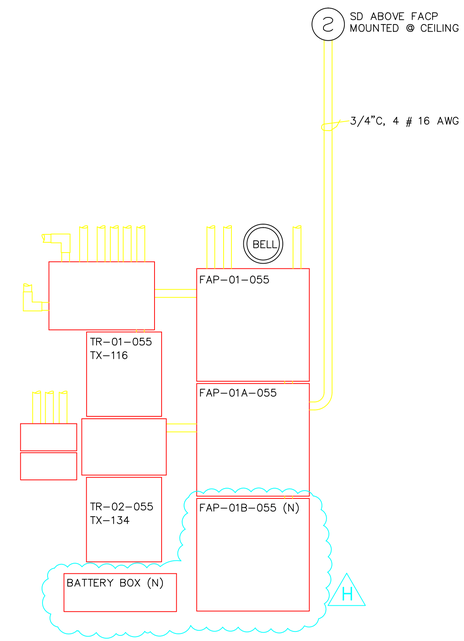

ELEVATION
SCALE: NTS

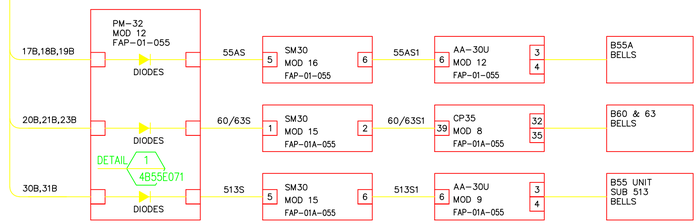

REFERENCE DRAWINGS

1. 4B55E070 BLDG. 55 FIRE ALARM SYSTEM SYS 3 INTERCONNECTION DIAGRAM
2. 4B55E071 BLDG. 55 FIRE ALARM SYSTEM MX-203 INTERCONNECTION DIAGRAM
3. 4B55E072 BLDG. 55 FIRE ALARM SYSTEM PLAN
4. 4B55E073 BLDG. 55 FIRE ALARM SYSTEM A/C DUCT SMOKE DETECTOR WIRING

PROFESSIONAL SEAL (IF REVISION, APPLIES ONLY TO REVISED WORK)

TITLE 2 CONSTRUCTION H 6/3/2004

ISSUE (PROGRESS, ESTIMATE, BID, CONSTRUCTION, CONFORMED, REVISION, RECORD)

REVISION NUMBER	DRAWN BY	CHECKED BY	APPR'D BY	DATE	REMARKS
H	MRC	AD	MCG	8/05/04	PHASE III FIRE ALARM SYSTEM UPGRADE
G	AD	MCG	MCG	8/27/01	ADDED ZONES 1F56 & 1F57, SD, BELL, FCB
E	FWD	MCG	MCG	10/23/98	AS BUILT
D	LDD	LDD	MCG	10/11/95	REV. FOR FIRE & LIFE SAFTY J#120257
C	LDD	LDD			AS-BUILT FOR J#120730
B		MLS		1/31/95	ADDED SMOKE DETECTORS ZONE 1C49
A	LSR	RB	BHS	9/12/94	ADDED DUCT DETECTORS ZONE 1C59

55 55A, 60 & 63
TR-116 AND TR-134
ELEVATION AND DIAGRAM

UNIVERSITY OF CALIFORNIA
LAWRENCE BERKELEY NATIONAL LABORATORY
FACILITIES DIVISION

DRAWN BY LDD
DATE 6/11/1996
CHECKED BY
APPROVED BY
CAD FILE PATH 00017873
SCALE As Noted
DRAWING NO. 4B55E069H
SHEET 1 OF 1
PROJECT NO. FB4010