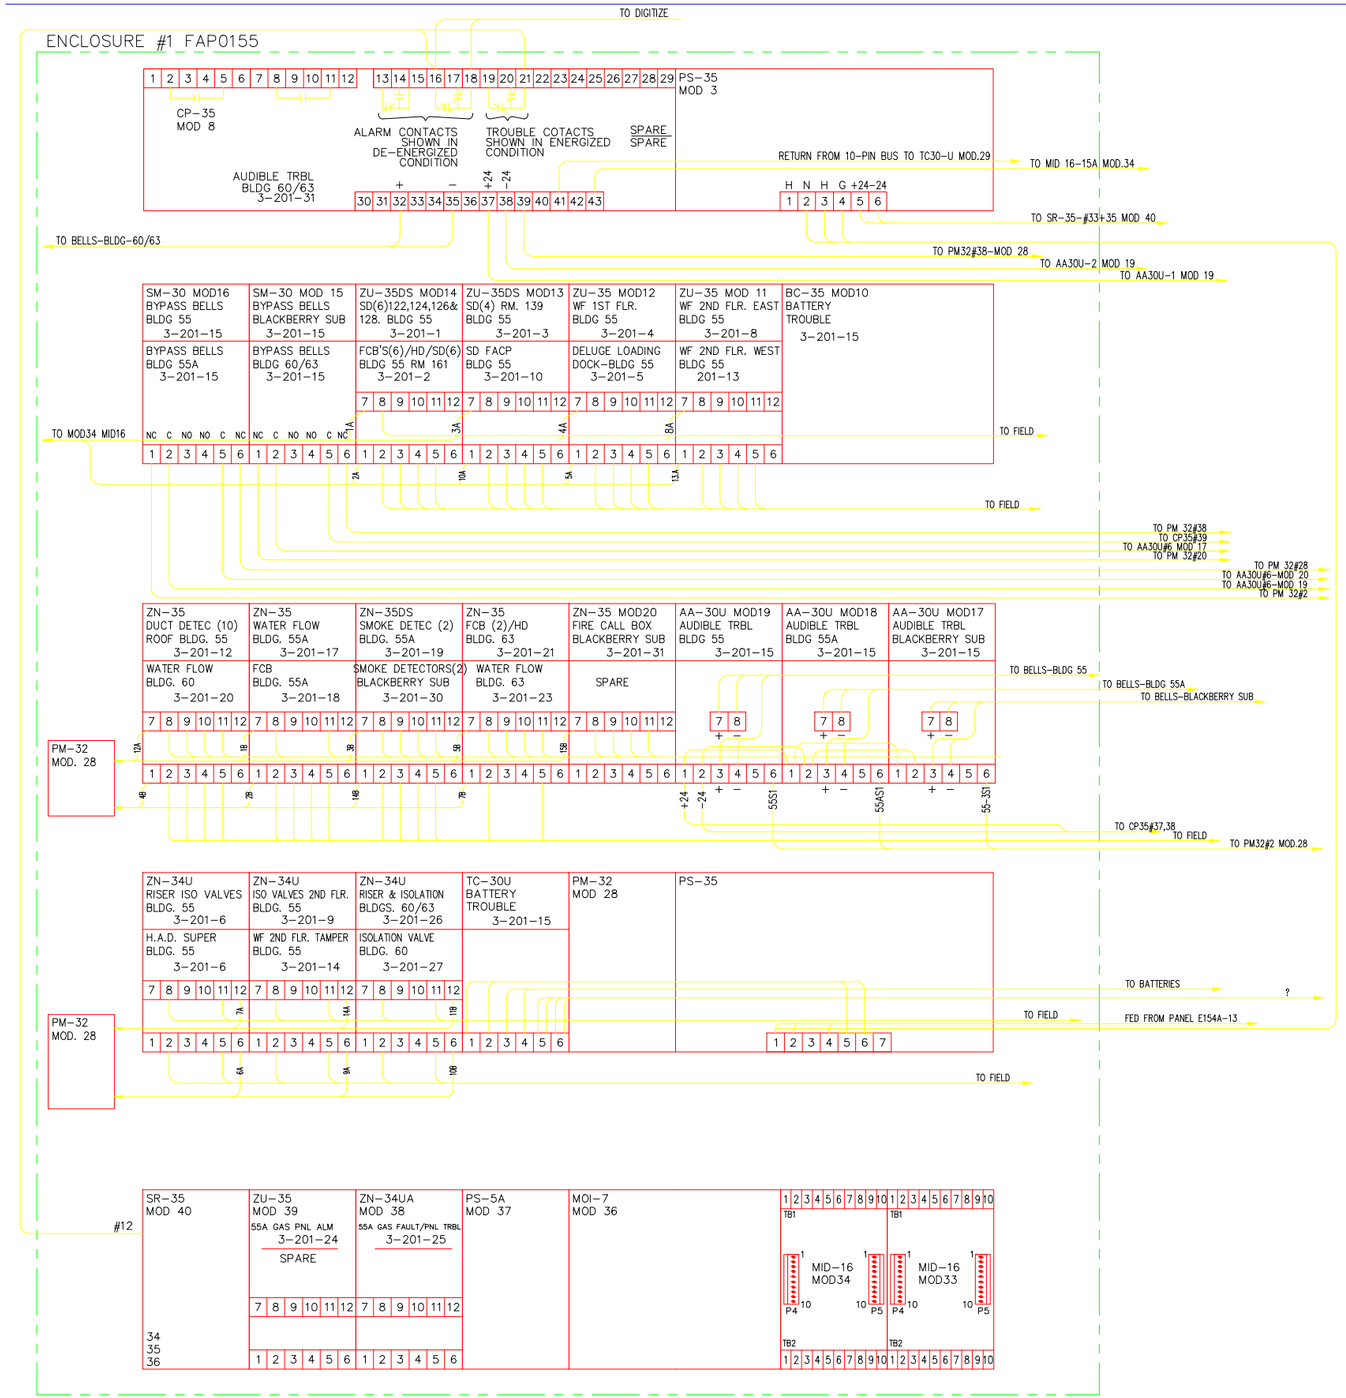

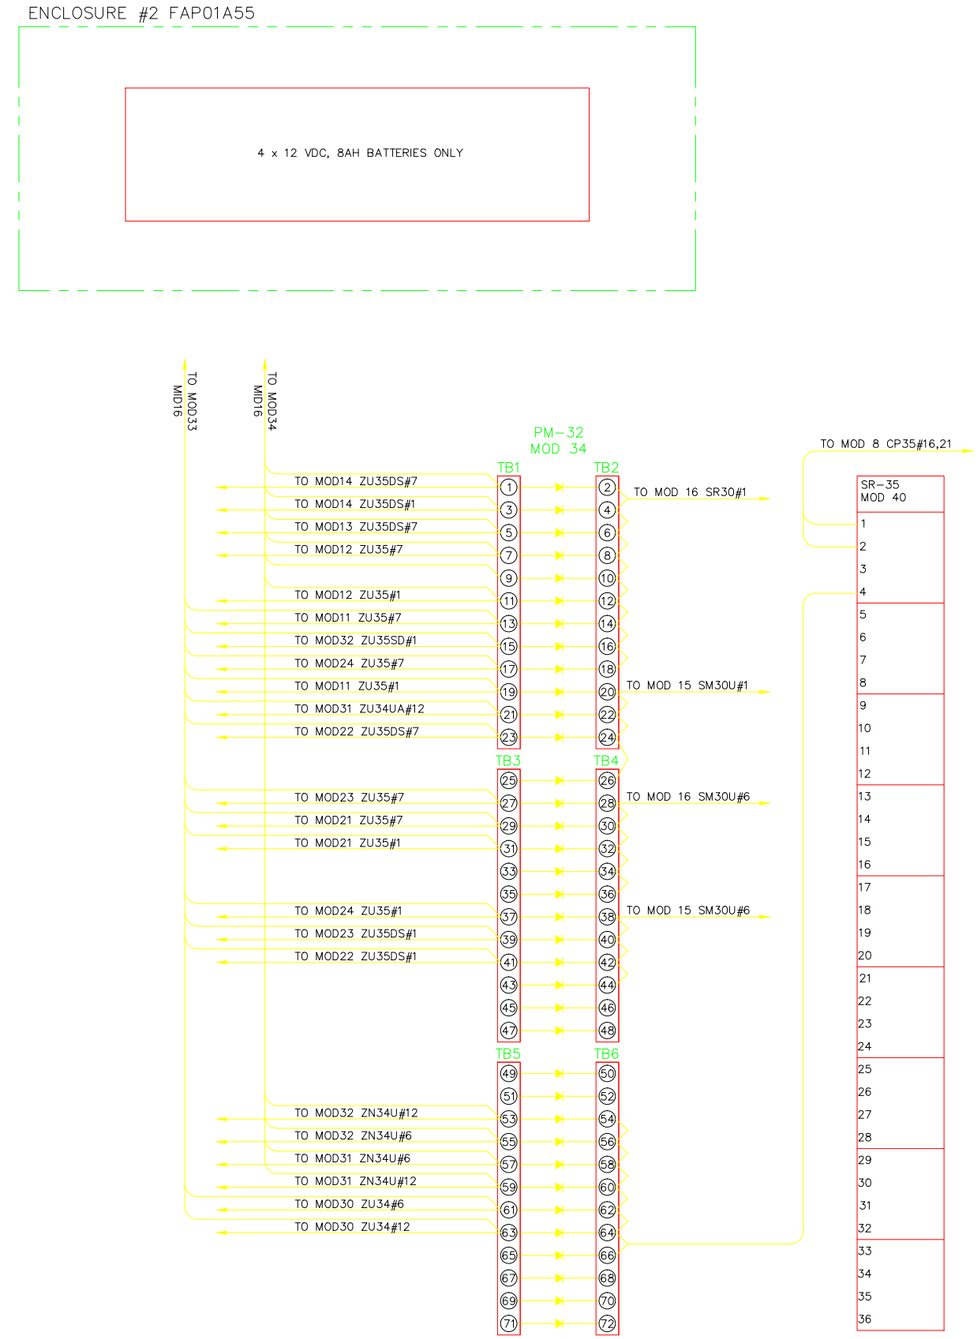

PROFESSIONAL SEAL (IF REVISION, APPLIES ONLY TO REVISED WORK)	AS BUILT C 05/21/2013	C	DSV	LDD	MCD	5/21/13	AS BUILT PER FIELD VERIFICATION	
		B				5/15/09	AS BUILT	
		A				9/30/08	AS BUILT	
	ISSUE (PROGRESS, ESTIMATE, BID, CONSTRUCTION, CONFORMED, REVISION, RECORD)	REVISION NUMBER	DRAWN BY	CHECKED BY	APPR'D BY	DATE	REMARKS	

55 FIRE ALARM FAP-01-55

B55,B60,63,55A

UNIVERSITY OF CALIFORNIA
LAWRENCE BERKELEY NATIONAL LABORATORY
FACILITIES DIVISION

DRAWN BY	DSV	DATE 5/21/13
CHECKED BY	LDD	5/21/13
APPROVED BY	MCD	5/21/13
CAD FILE PATH		
SCALE		
DRAWING NO.	4B55E113C	SHEET FA-'
PROJECT NO.	FA4010	