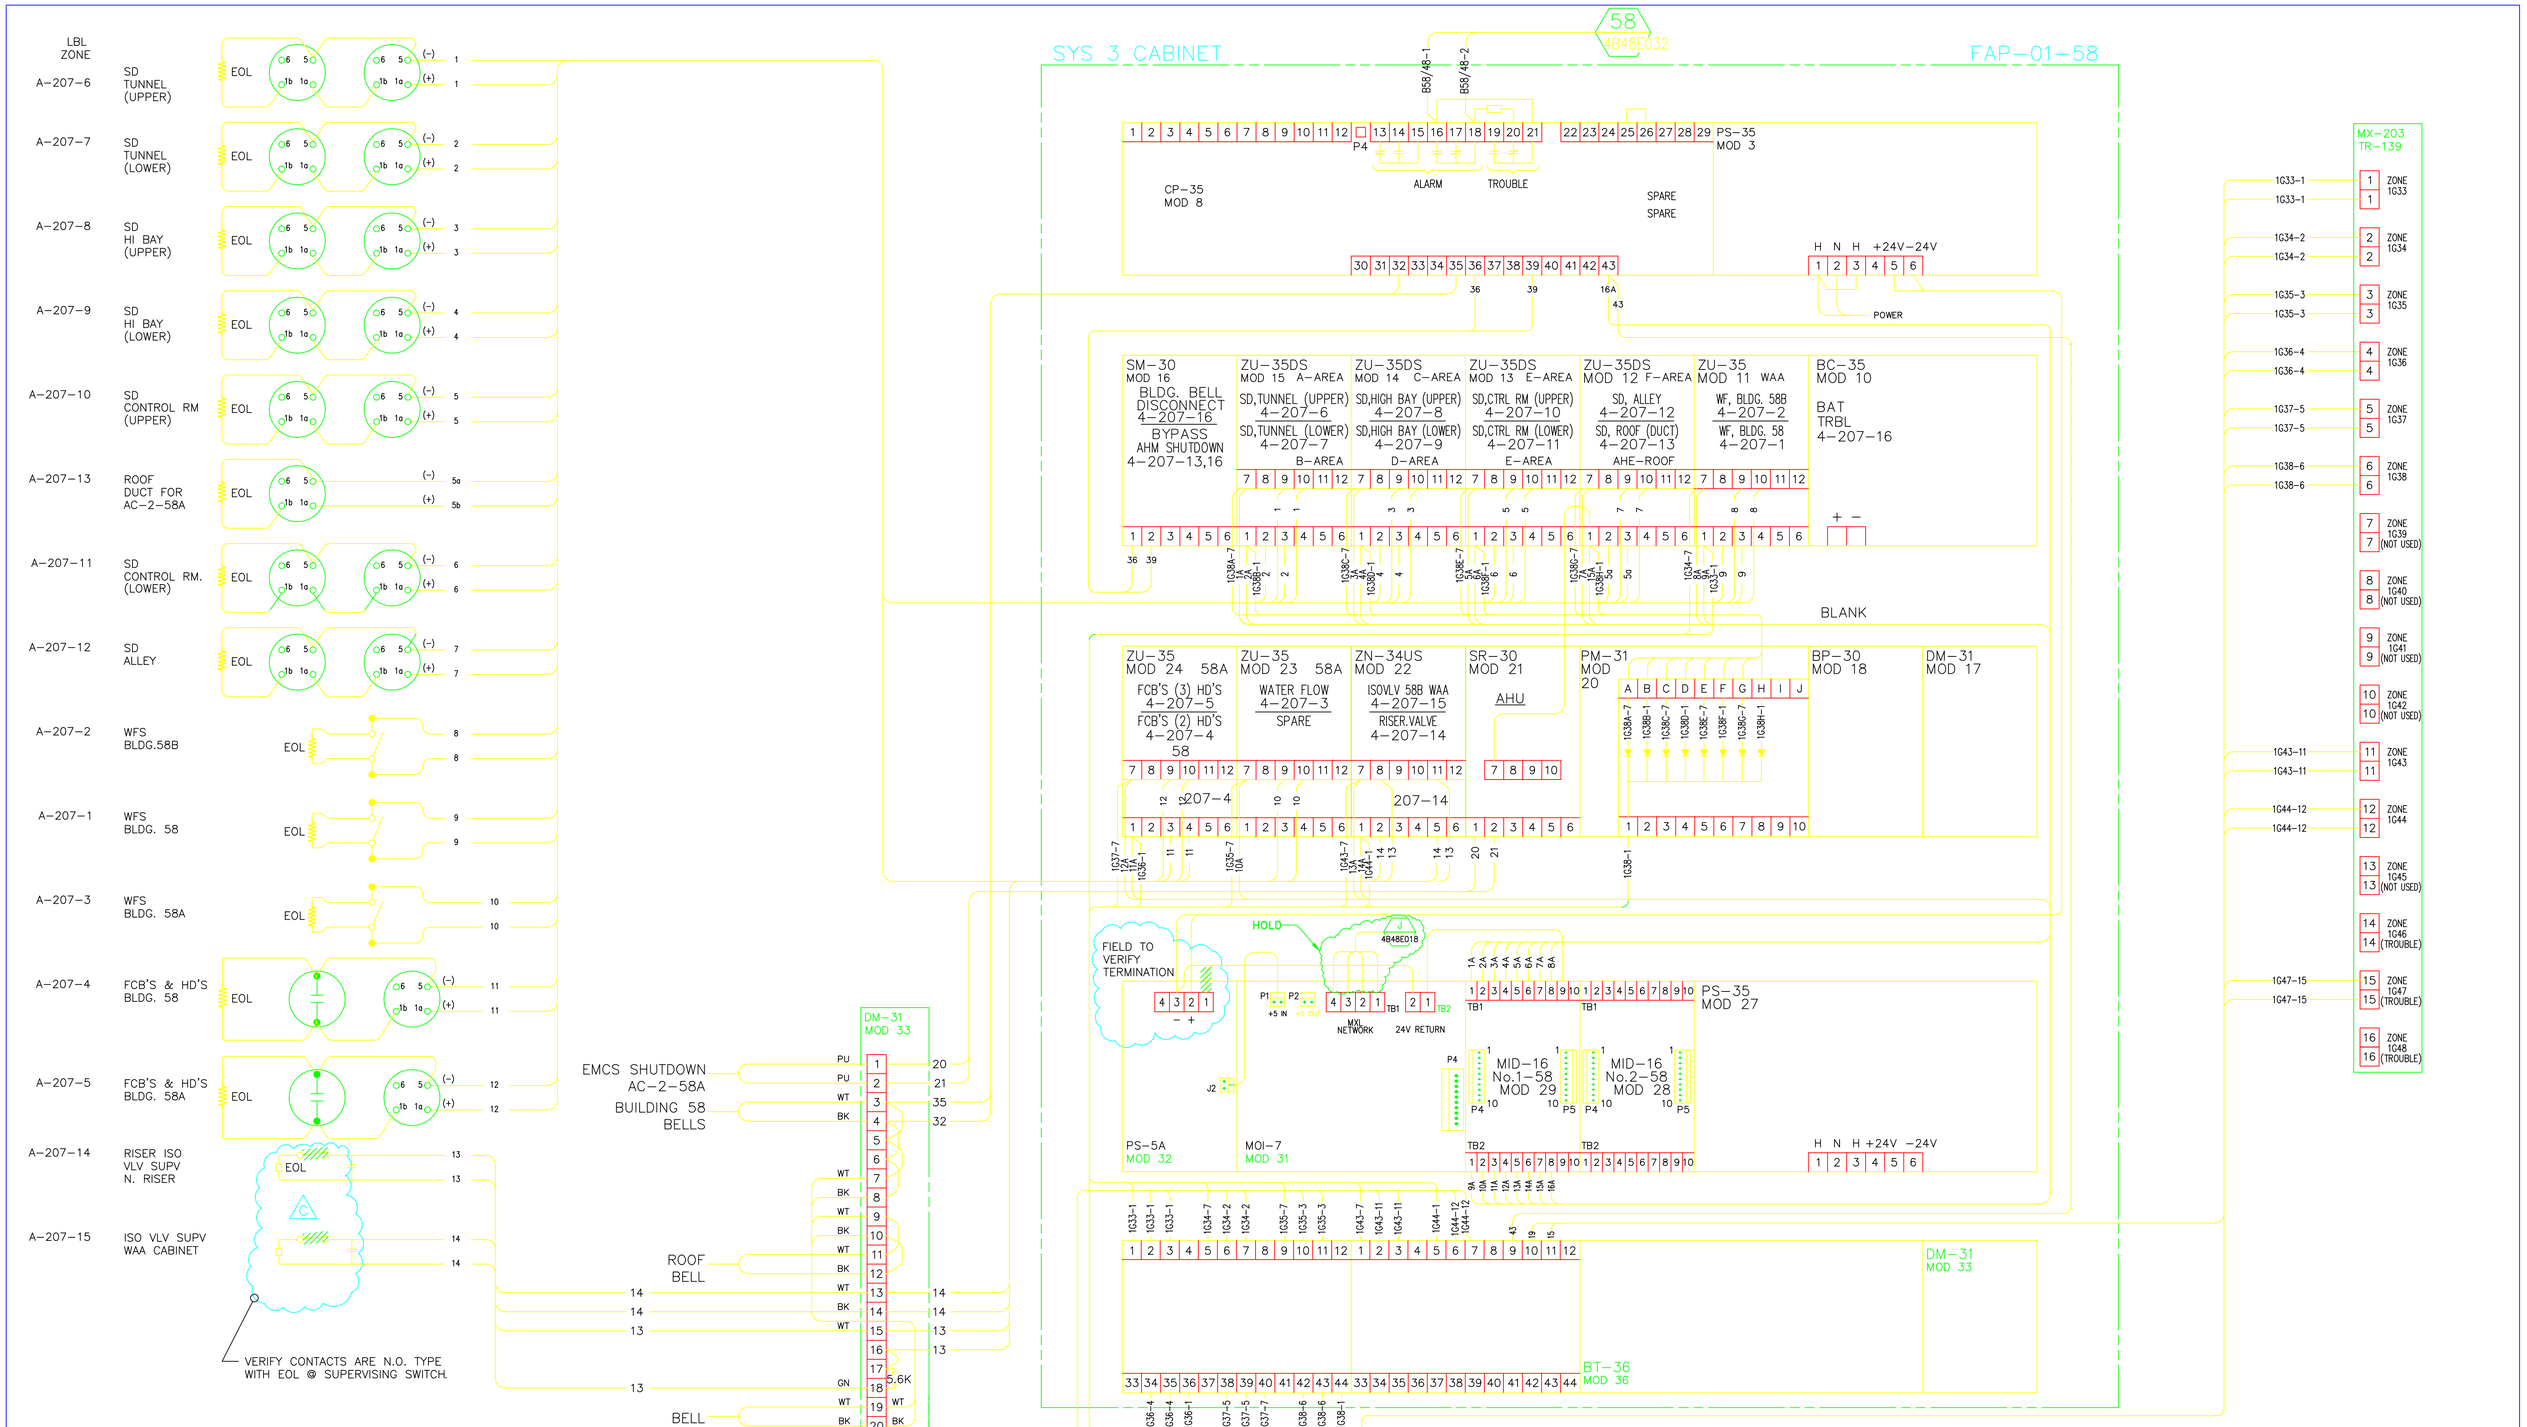

REVISION NUMBER	DRAWN BY	CHECKED BY	APPR'D BY	DATE	REMARKS
D	DSV	LDD	MCD	5/21/13	AS BUILT PER FIELD VERIFICATION
C	RZT	MCG	MCG	4/15/05	REVISED FOR DIGITIZE SYSTEM.
B	MRC	AD	MCG	12/11/03	AS-BUILT, PHASE II FA UPGRADE
A	HYT	HYT	–	-	REPLACE SYSTEM 3; FA REPLACEMENT PROJECT

58 BLDG 58

FIRE ALARM SYSTEM

SYSTEM 3 WIRING DIAGRAM

UNIVERSITY OF CALIFORNIA
LAWRENCE BERKELEY NATIONAL LABORATORY
FACILITIES DEPARTMENT

DRAWN BY	HYT	DATE 5/3/2001
CHECKED BY	HYT	5/3/2001
APPROVED BY		
CAD FILE PATH		
SCALE	Full	
DRAWING NO.	4B58E055D	SHEET 1
PROJECT NO.	FA8040	1 OF 1