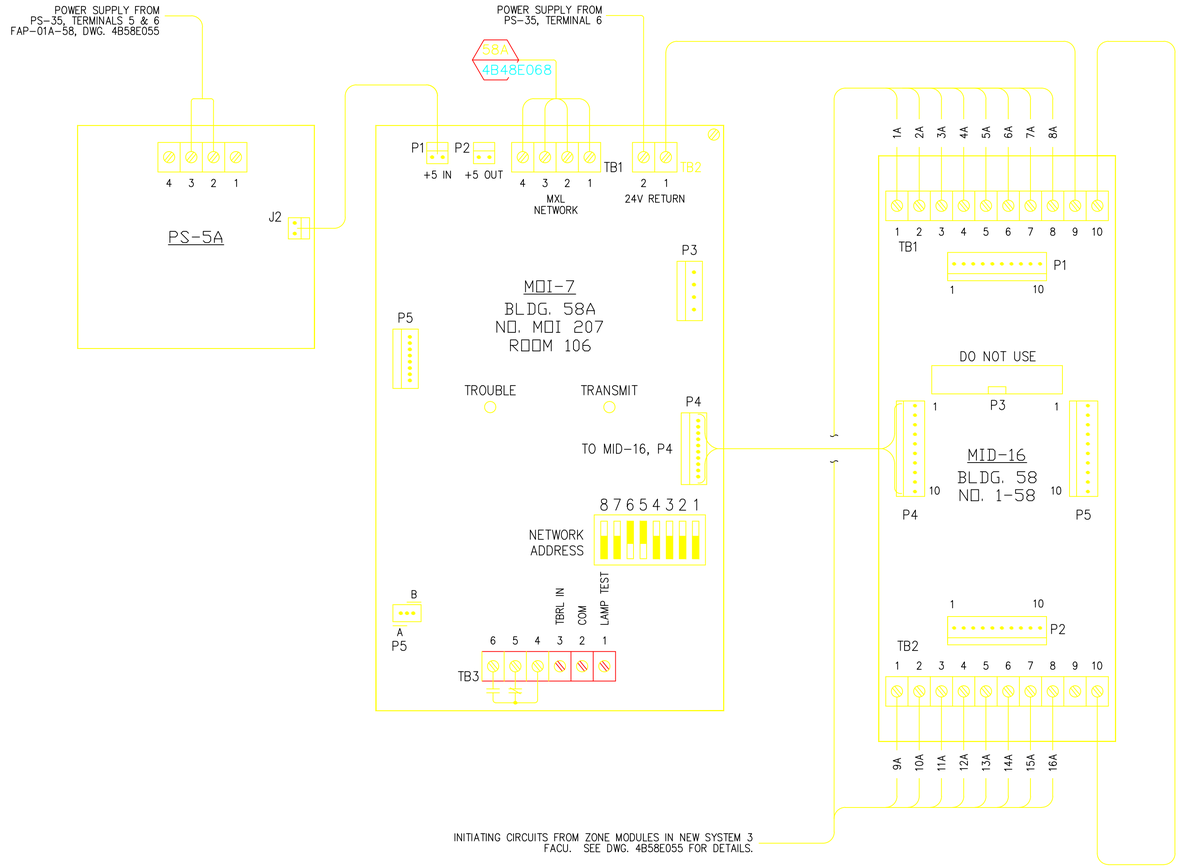

OLD ADDRESS	DESCRIPTION	MID-16 TERMINATION	MODULE TYPE & NO.	MXL NO. 04-02 ADDRESS
1G38A	SD TUNNEL (UPPER)	TB. 1 NO. 1	MID-16 NO. 1-58	4-207-6
1G38B	SD TUNNEL (LOWER)	TB. 1 NO. 2	MID-16 NO. 1-58	4-207-7
1G38C	SD HI-BAY (UPPER)	TB. 1 NO. 3	MID-16 NO. 1-58	4-207-8
1G38D	SD HI-BAY (LOWER)	TB. 1 NO. 4	MID-16 NO. 1-58	4-207-9
1G38E	SD & ROOF DUCT AC-2-58A	TB. 1 NO. 5	MID-16 NO. 1-58	4-207-10
1G38F	SD CONTROL ROOM (LOWER)	TB. 1 NO. 6	MID-16 NO. 1-58	4-207-11
1G38G	SD ALLEY	TB. 1 NO. 7	MID-16 NO. 1-58	4-207-12
1G34	WATERFLOW BLDG. 58B	TB. 1 NO. 8	MID-16 NO. 1-58	4-207-2
1G33	WATERFLOW BLDG 58	TB. 2 NO. 1	MID-16 NO. 1-58	4-207-1
1G35	WATERFLOW BLDG 58A	TB. 2 NO. 2	MID-16 NO. 1-58	4-207-3
1G36	FCB & HD BLDG 58	TB. 2 NO. 3	MID-16 NO. 1-58	4-207-4
1G37	FCB & HD BLDG 58A	TB. 2 NO. 4	MID-16 NO. 1-58	4-207-5
1G43	RISER VLV SUPV N RISER	TB. 2 NO. 5	MID-16 NO. 1-58	4-207-14
1G44	ISO VLV SUPV WAA CABINET	TB. 2 NO. 6	MID-16 NO. 1-58	4-207-15
1G38H	SD, ROOF DUCT	TB. 2 NO. 7	MID-16 NO. 1-58	4-207-13
N/A	SYSTEM 3 TROUBLE	TB. 2 NO. 8	MID-16 NO. 1-58	

PROFESSIONAL SEAL (IF REVISION, APPLIES ONLY TO REVISED WORK)

ISSUE (PROGRESS, ESTIMATE, BID, CONSTRUCTION, CONFORMED, REVISION, RECORD)

AS BUILT

C
5/24/2013

REVISION NUMBER	DRAWN BY	CHECKED BY	APPR'D BY	DATE	REMARKS
C	DSV	LDD	MCD	5/24/13	AS BUILT PER FIELD VERIFICATION
B	AD	LDD	MCD	03/20/05	REVISED FOR MXL COPPER LOOP
A	MRC	AD	MCG	12/11/03	AS-BUILT PHASE II FA UPGRADE

58 BLDG 58A
REPLACEMENT FIRE ALARM SYSTEM
MOI/MID MODULE ARRANGEMENT

UNIVERSITY OF CALIFORNIA
LAWRENCE BERKELEY NATIONAL LABORATORY
FACILITIES DIVISION

DRAWN BY HYT DATE 3/30/2001
CHECKED BY HYT 3/30/2001
APPROVED BY
CAD FILE PATH
SCALE Full
DRAWING NO. 4B58E057C
SHEET 1
PROJECT NO. FA8040
1 OF 1