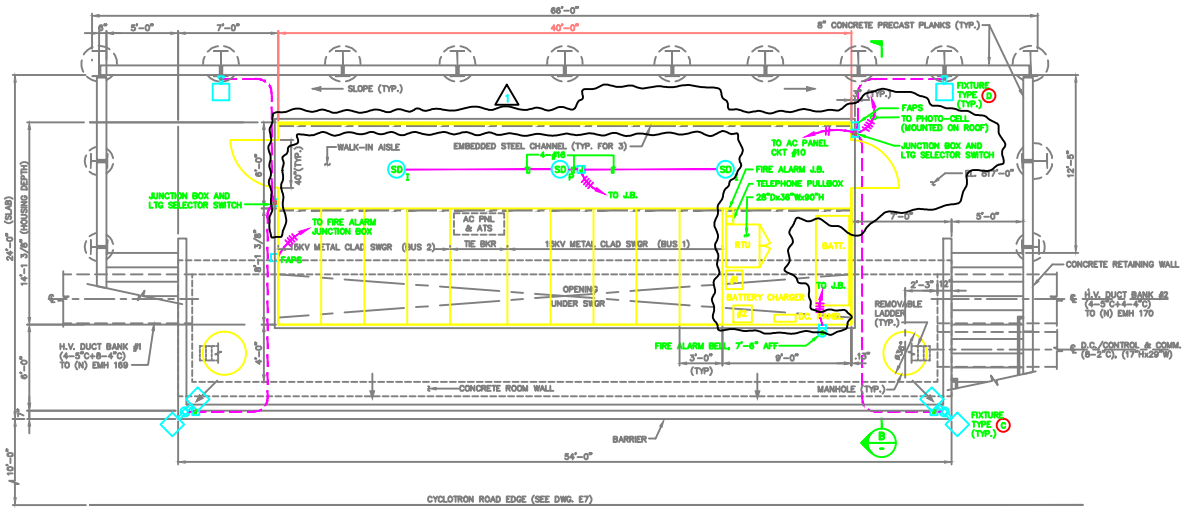

SECOND LEVEL PLAN

SCALE : 1/4"=1'-0"

NOTE

FOR FIXTURE TYPES AND SINGLE LINE DIAGRAMS OF LIGHTING CONTROL, RECEPTACLE AND FIRE ALARM DEVICE, SEE DWG. E13.

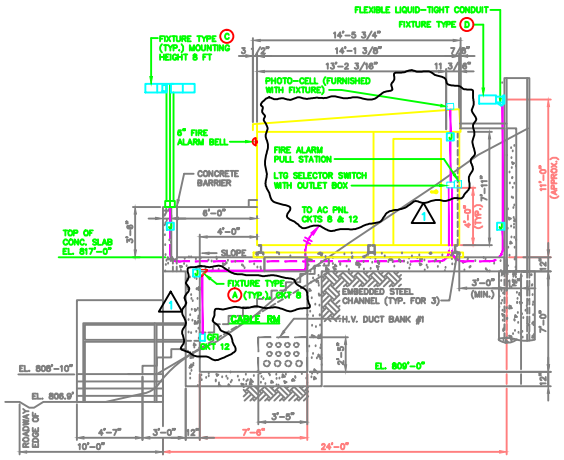

SECTION B

SCALE : 1/4"=1'-0"

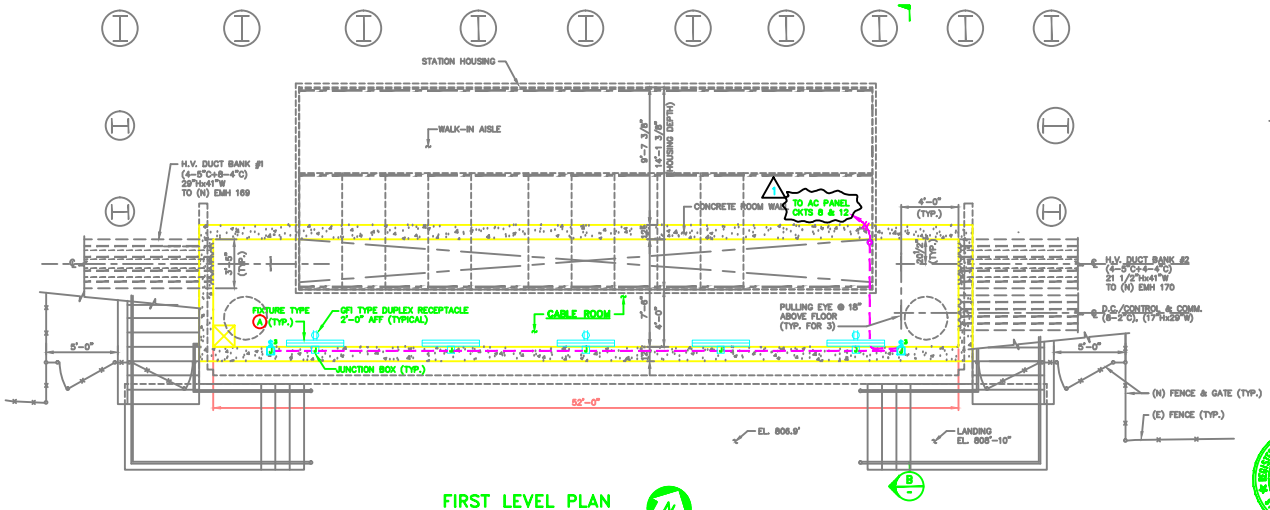

FIRST LEVEL PLAN

SCALE: 1/4"=1'-0"

V.V.	B.F.			MM/DD	AS-BUILT PER CONTRACTOR'S MARK-UP
DRAWN BY	CHECKED BY	APPROVED BY		DATE	REVISIONS

SC 730

YEI ENGINEERS, INC.
2906 Hyde Street, Berkeley, CA 94705
(510) 867-4200

EAST CANYON ELECTRICAL SAFETY PROJECT
SWITCHING STATION SW-A5
LIGHTING, FIRE ALARM & COMMUNICATION
PLANS AND SECTION

UNIVERSITY OF CALIFORNIA LAWRENCE BERKELEY LABORATORY
PLANT ENGINEERING

DRAWN BY	UNA T.	DATE 10/31/94
CHECKED BY	K.H./B.F.	10/31/94
APPR. BY		
APP. 131102 CAD FILE: C0002108		
SCALE 1/4"=1'-0"		SHEET NO.
DRAWING NO. 4N00E362		E11

9223 (LBL-E11) 3/31/97