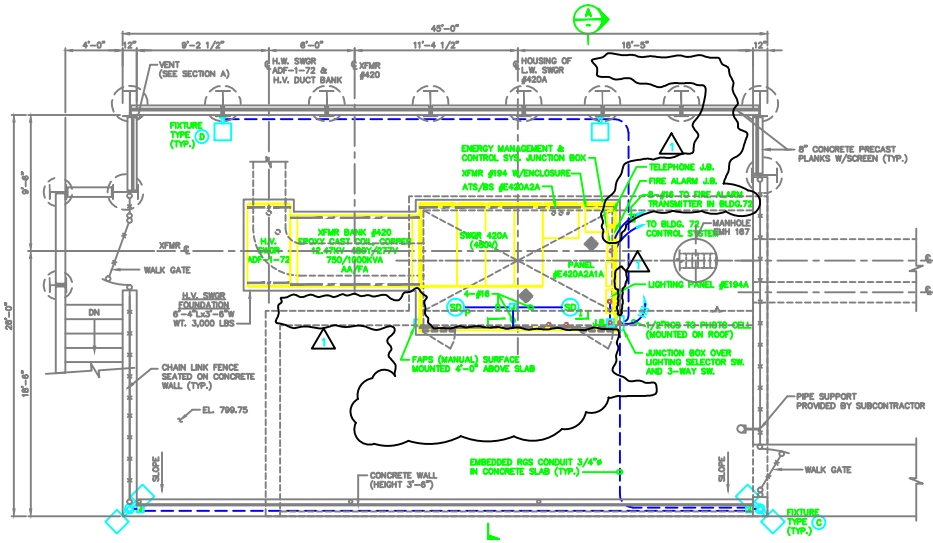

SECOND LEVEL PLAN

SCALE : 1/4"=1'-0"

NOTE

SEE DRAWING E13 FOR :
1. EXTERIOR LIGHTING CONTROL (SCHEME 1, ONLY 1 SELECTOR SWITCH),
2. VAULT LIGHTING CONTROL (SCHEME 2),
3. RECEPTACLE CONNECTION (SCHEME 3), AND
4. FIXTURE TYPES ("FIXTURE SCHEDULE").

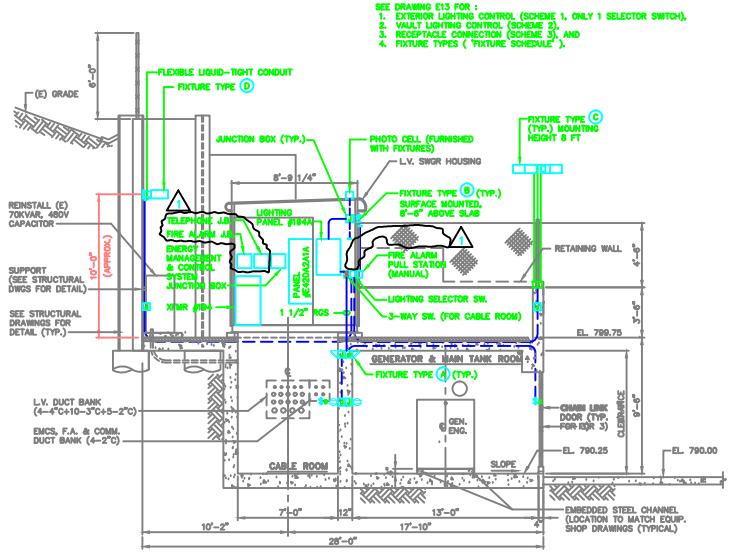

SECTION A

SCALE : 1/4"=1'-0"

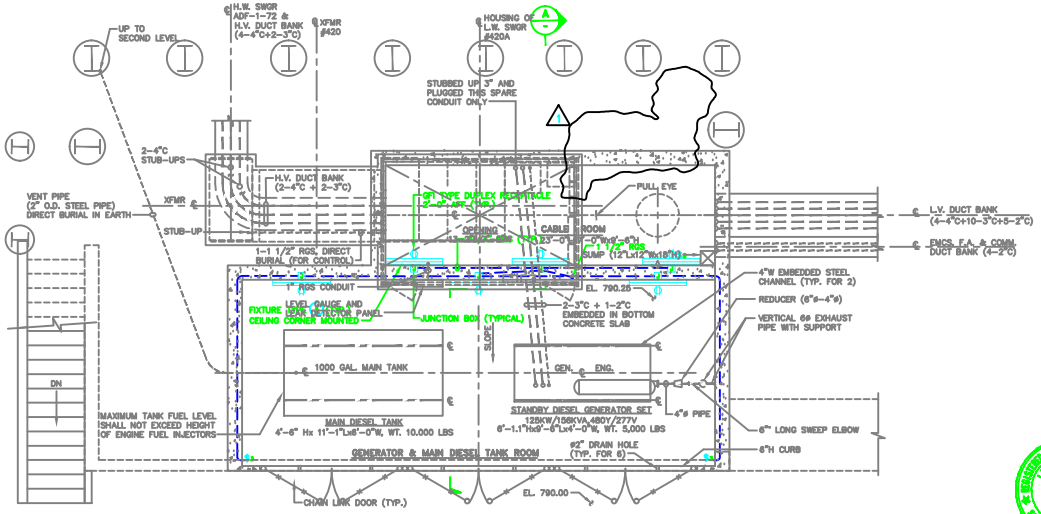

FIRST LEVEL PLAN

SCALE: 1/4"=1'-0"

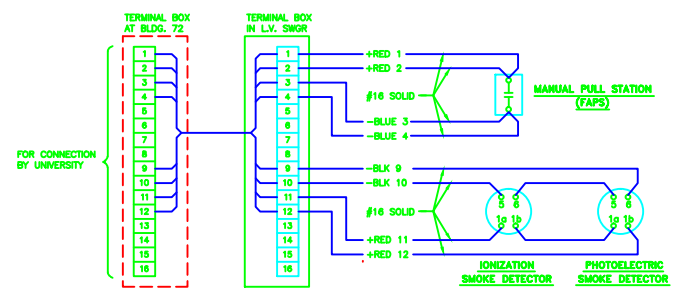

FIRE ALARM DEVICE WIRING

SC 730

REGISTERED PROFESSIONAL ENGINEER LAWRENCE T. LAMBERT EE 5258 EXP. 6/30/95 ELECTRICAL STATE OF CALIFORNIA

YEI ENGINEERS, INC. 2305 Hayline Street, Ingwood, CA 90405 (310) 697-4200

LETTER	DRAWN BY	CHECKED BY	APPROVED BY	DATE	DESCRIPTION
A	V.V.	B.F.		MM/DD/YY	AS-BUILT PER CONTRACTOR'S MARK-UP

EAST CANYON ELECTRICAL SAFETY PROJECT
BLDG. 72 SUBSTATION
LIGHTING, FIRE ALARM & COMMUNICATION PLANS AND SECTION

UNIVERSITY OF CALIFORNIA LAWRENCE BERKELEY LABORATORY
PLANT ENGINEERING

		DATE
DRAWN BY	UNA T.	10/31/94
CHECKED BY	B.F.	10/31/94
APPR. BY		
APP. 120102 CAD FILE: C0002019		
SCALE 1/4"=1'-0"		SHEET NO. E26
DRAWING NO. 4N00E376		OF

9223 (LBL-E26) 3/31/97