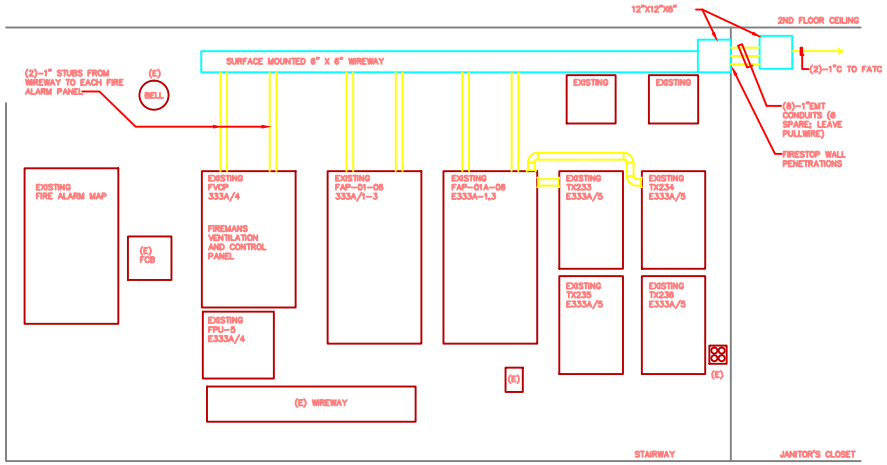

SEE SITE PLAN SHEET E2 FOR LOCATION OF EQUIPMENT

ELEVATION 1ST FLOOR

SCALE: NONE

1 / E7F

1 FIRE ALARM SYSTEM – LOGIC DIAGRAM ANNUNCIATING DEVICES
N.T.S.

GLUMAC INTERNATIONAL
CONSULTING ENGINEERS
ENGINEERING CENTER WEST TOWER / 275 GATEWAY STREET SUITE 220
SAN FRANCISCO CA 94111 / TEL 415-398-7667 FAX 415-398-0806
PORTLAND SACRAMENTO SEATTLE LOS ANGELES MADRID
MECHANICAL ELECTRICAL ACOUSTICAL ENERGY TELECOMMUNICATIONS
JOB No. 43W96.12A Contacts

REVISION NUMBER	DRAWN BY	CHECKED BY	APPR'D BY	DATE	REMARKS
	PUV	PAT	MLS	7/15/99	RECORD DRAWINGS

BUILDING 6
SECOND FLOOR CONVERSION
DETAILS

UNIVERSITY OF CALIFORNIA LAWRENCE BERKELEY LABORATORY
FACILITIES DEPARTMENT

DRAWN BY	ZLM	DATE 6/20/97
CHECKED BY	PAT	6/20/97
APPROVED BY	MLS	6/20/97
CAD FILE PATH	00010647	
SCALE	N.T.S.	
DRAWING NO.	4B06E213A	SHEET E7F
PROJECT NO.	–	