BUILDING NO. 6

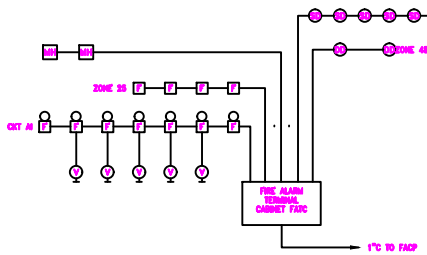

FIRE ALARM RISER DIAGRAM
NOT TO SCALE

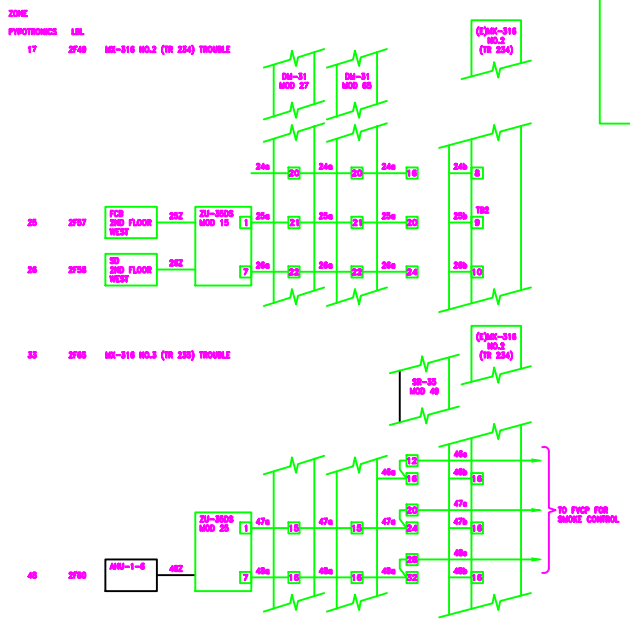

LOGIC DIAGRAM
NOT TO SCALE

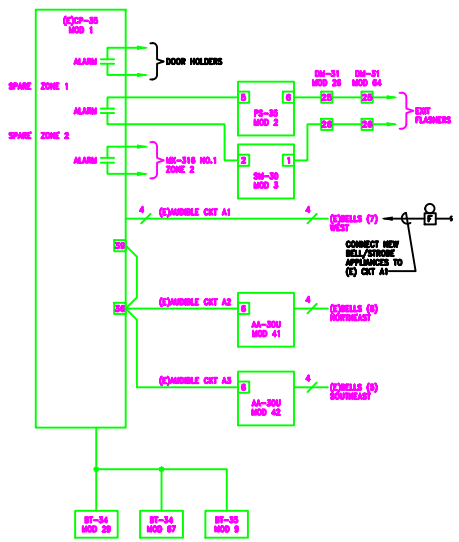

AUDIBLE AND VISUAL CIRCUITS
NOT TO SCALE

NOTES:

1. NOT USED.
2. PROVIDE SIGNAL TO ELEVATOR CONTROLLER UPON ACTIVATION OF BLDG 6 OR BLDG 80 ELEV. LOBBY SMOKE DETECTOR.
3. PROVIDE RELAY MODULE AT FACP PANEL & WIRING TO CLOSE FIRE & SMOKE DAMPERS UPON ACTIVATION OF CORRIDOR SMOKE DETECTORS.

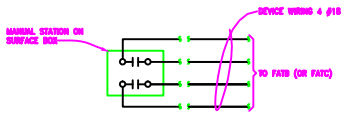

MANUAL STATION DIAGRAM
NOT TO SCALE

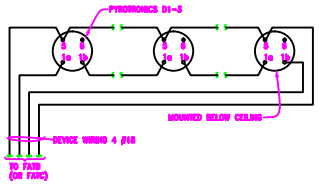

SMOKE DETECTOR DIAGRAM
NOT TO SCALE

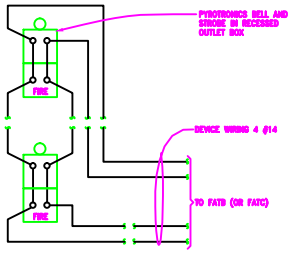

BELL AND STROBE DIAGRAM
NOT TO SCALE

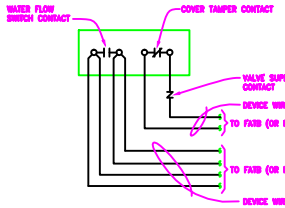

WATERFLOW SWITCH DIAGRAM
NOT TO SCALE

Architects
Planners
Interior Designers

38 New Montgomery St.
Suite 600
San Francisco, CA 94105
Telephone: 415.777.5444
Fax: 415.777.5044

PROJECT TITLE

ALS STRUCTURAL BIOLOGY SUPPORT FACILITIES

LAWRENCE BERKELEY LABORATORY

University of California
Berkeley, CA

CONSULTANT

GAYNER ENGINEERS & ASSOCIATES

ISSUE	DESCRIPTION	DATE
1	BIDS 2 SET	9/13/94
2	BIDS 3 SET	11/28/94
3	FINAL ISSUE	2/6/95
A	OWNER REQ. REVISION	9/26/96
4	RECORD DWGS.	2/14/97

OWNERSHIP OF DOCUMENTS
THIS PLAN AND SPECIFICATION IS THE PROPERTY AND COPYRIGHT PROPERTY OF ARCHITECTS
© COPYRIGHT 1995

DRAWN BY TW
CHECKED BY ARM
SCALE NOT TO SCALE

SHEET TITLE

FIRE ALARM DIAGRAMS

SHEET NO.:

E5.5

PROJECT NO.: 93036

CAD DWG NO. & PLOT DATE: LIL-22-5 2/14/97

Date: 2-14-97
File: P:\PROJECT\4943-01\ELL.DWG
Xref Files: 1
Xref Plan: - TRX
Drawn By: JK

03.5.DWG
4943.01 (ALS); 2-23-95; TW