NOTES:

1. FOR SYMBOLS AND LEGEND SEE DWG 259-E0
2. EXCAVATE AREA OF EXISTING DUCT BANK BY HAND
3. CONTRACTOR TO VERIFY EXACT CONDUIT STUB-UP LOCATIONS FROM LBL PRIOR TO ROUGH-IN
4. MAKE ALL CONDUIT PENETRATIONS TO RM 101 MIN 9' AFF CONSEAL IN WALL OR ABOVE CEILING INSULATION
5. INSTALL SPEAKER OUTLET BOX WITH 3/4"C & PULL WIRE BACK TO PA/INTERCOM SHELF IN RM 103.
6. MOUNT ALL CEILING MOUNTED DEVICES BELOW 7" THICK CEILING INSULATION IN THIS AREA.

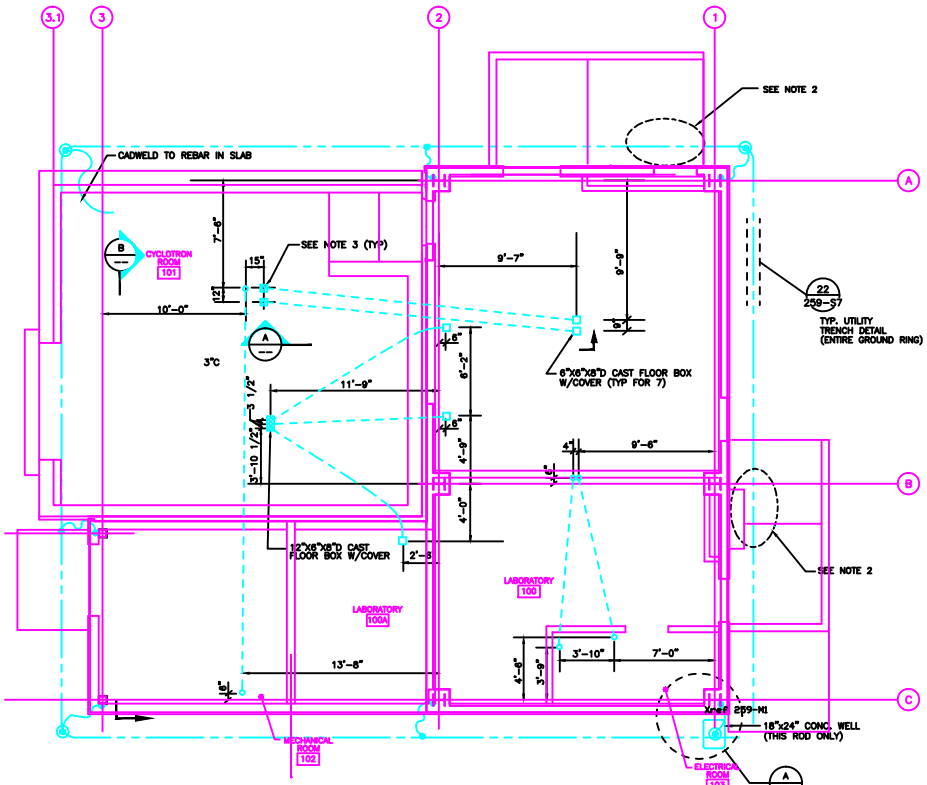

UNDERGROUND PLAN

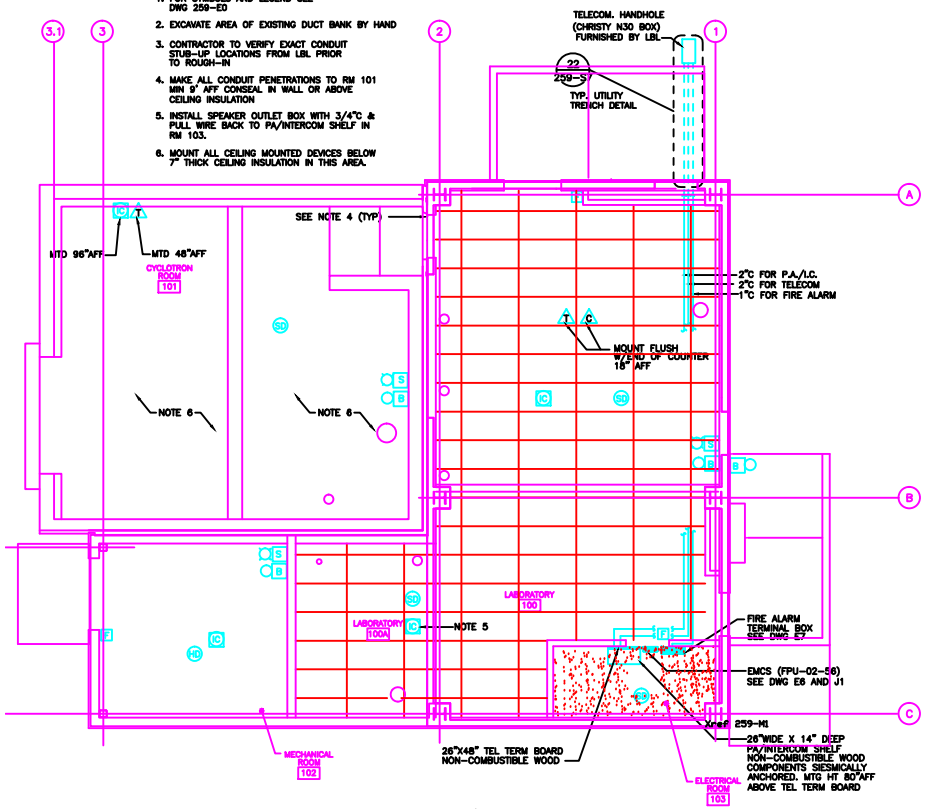

FIRE ALARM + COMMUNICATIONS PLAN

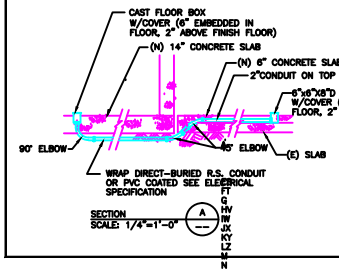

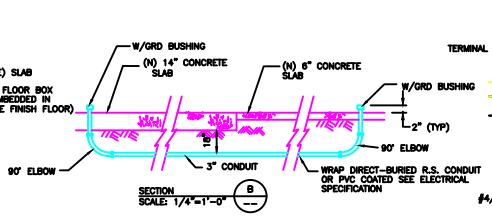

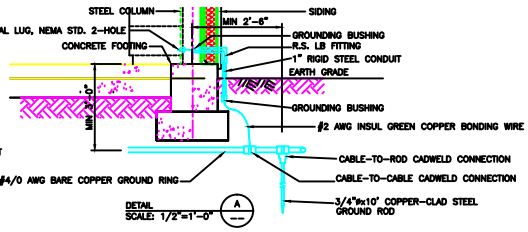

SCALE: 1/4"=1'-0"

CAD FILE: 00002610

PROJECT NORTH

Rev	Revisions/Submissions	Date
A	AS-BUILT	9/25/97
0	ISSUED FOR CONSTRUCTION	5/6/94

Quasar

120213	4N56E006A

BLDG. 56 BIO-MED. ISOTOPE FACILITY
ELECTRICAL
UNDERGROUND/FIRE/COMM PLANS

J. BAZZELL	5/13/93
W. HELFRICH	5/5/94
S. DEASON	5/5/94
1/4"=1'-0"	

UNIVERSITY OF CALIFORNIA, LAWRENCE BERKELEY LABORATORY
FACILITIES DEPT. – ARCHITECTURE & ENGINEERING

259-E3