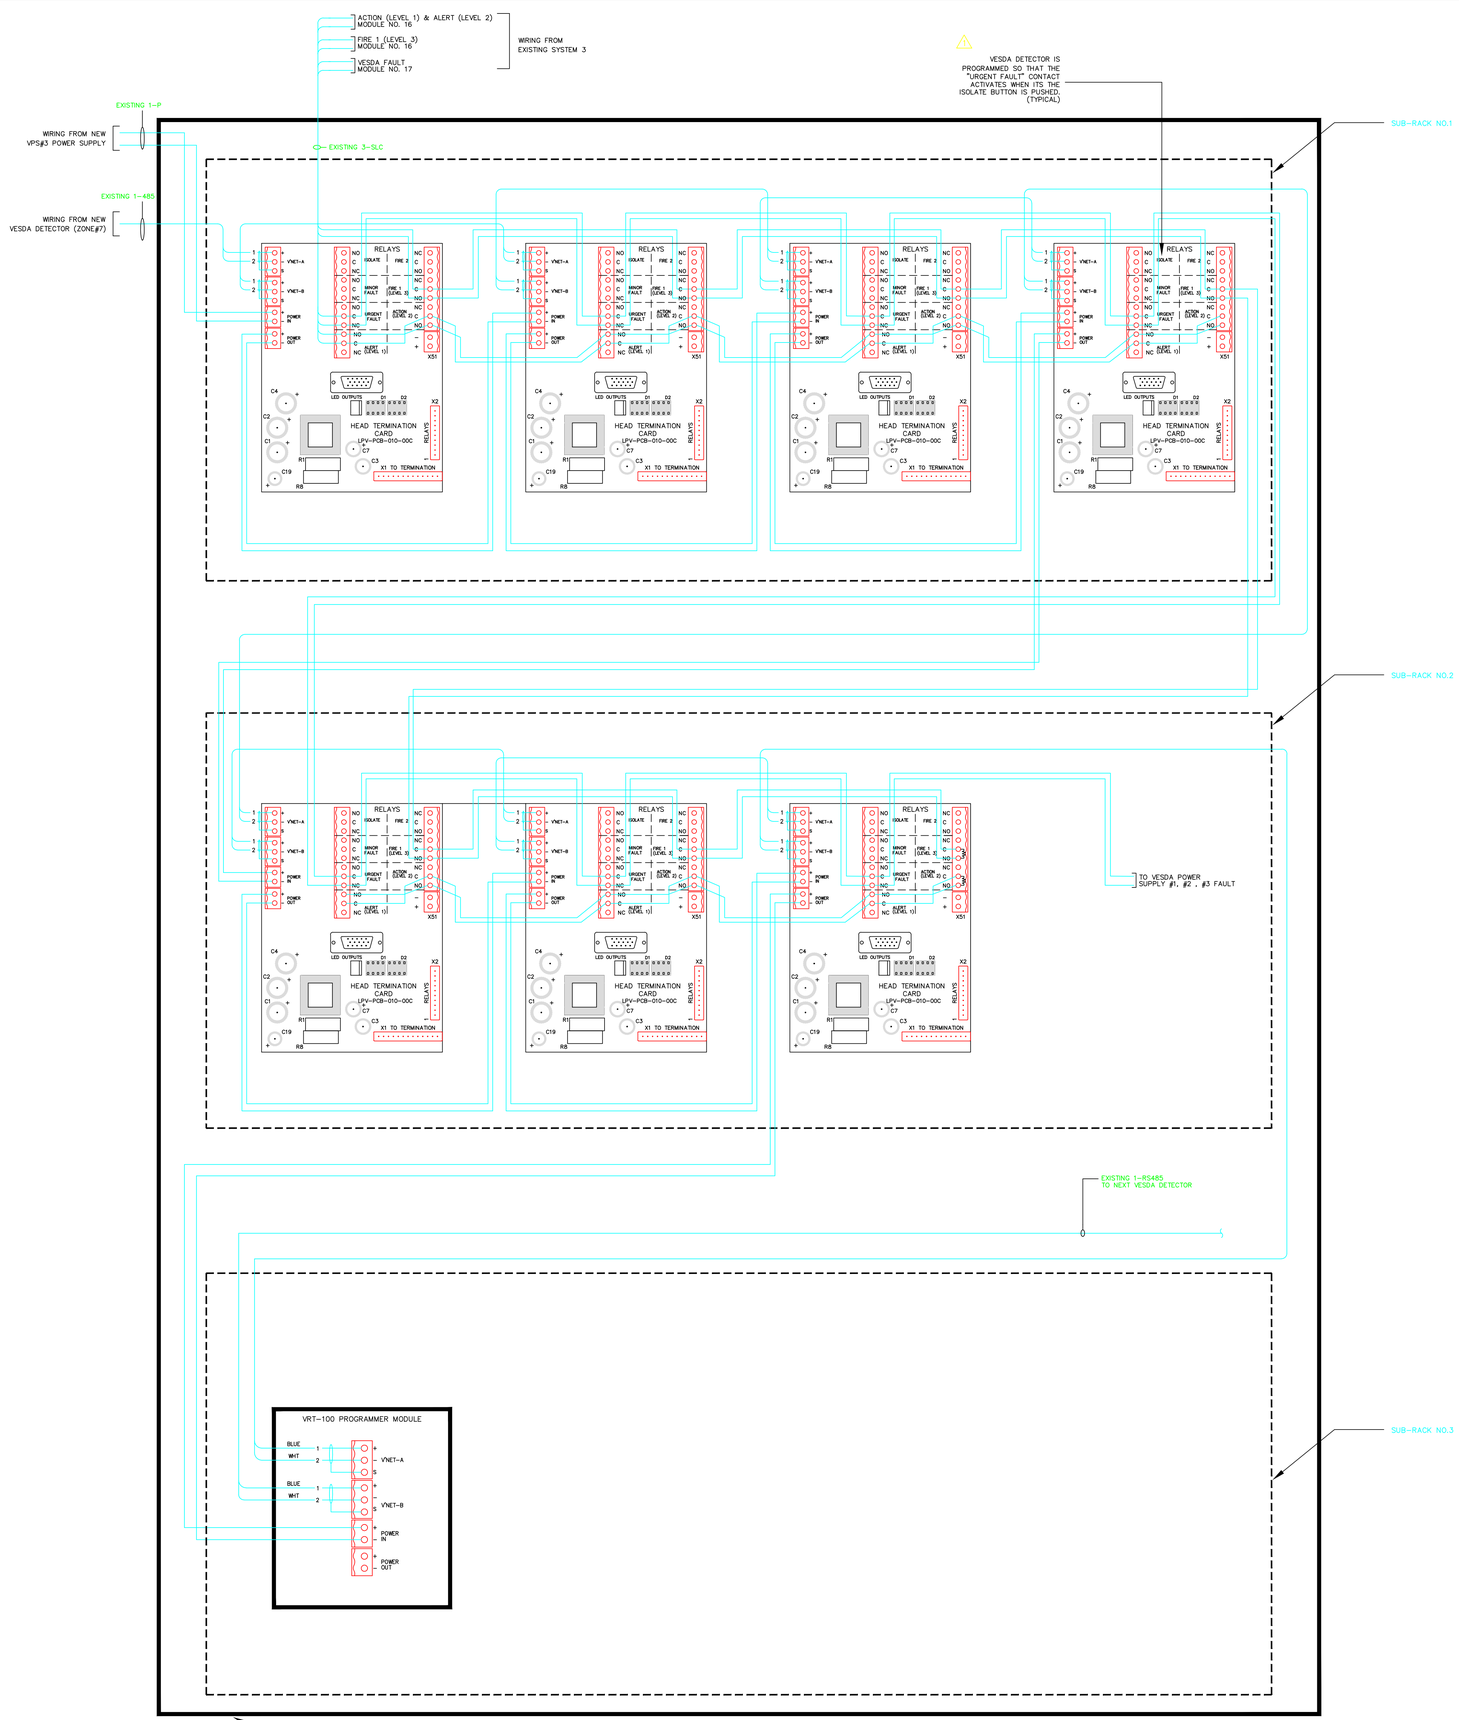

'VESDA' SYSTEM REMOTE DISPLAY/RELAY TERMINATION CABINET-VRE 100

(DISPLAY CABINET IS LOCATED ADJACENT TO THE EXISTING FIRE ALARM CONTROL PANEL)

SYSTEM 3 PANEL FAP-01-06

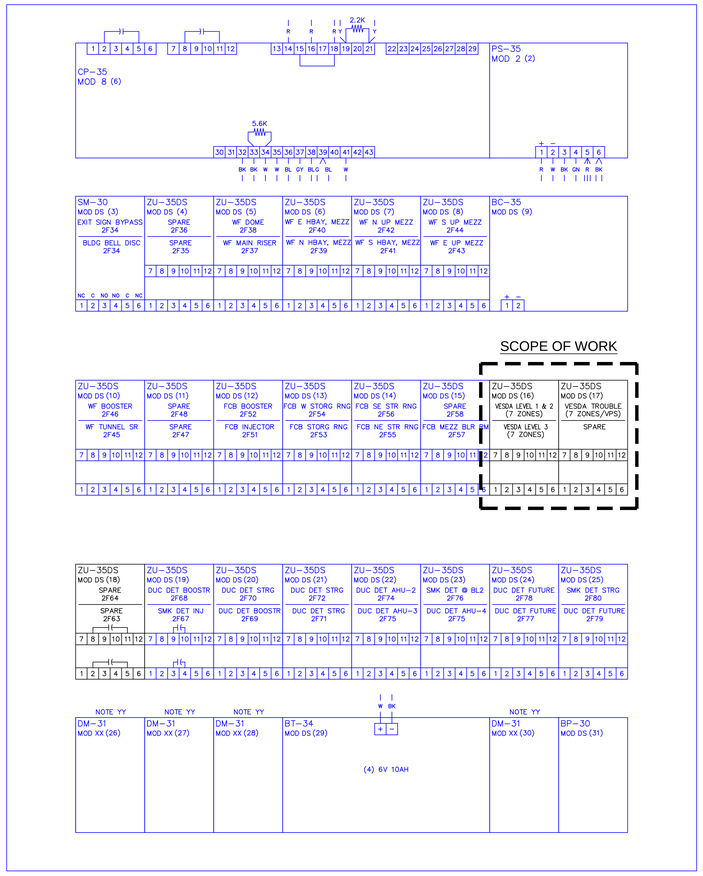

SCOPE OF WORK

EXISTING SYSTEM 3 PANEL FAP-01-06

- NO SCALE -

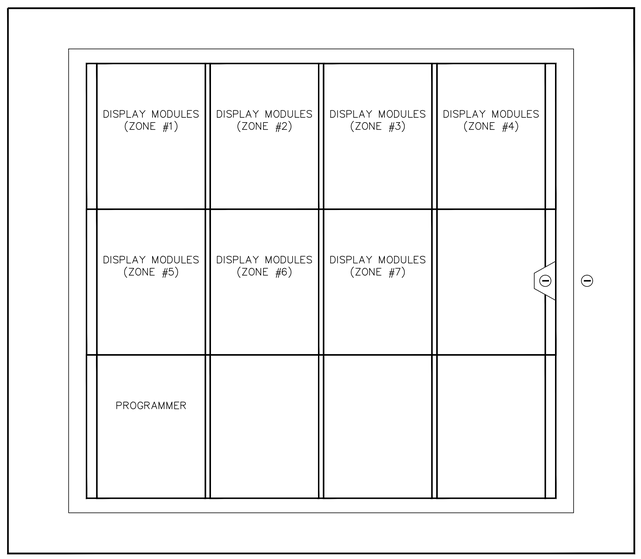

NEW 19" SUBRACK ENCLOSURE (FRONT VIEW)

- NO SCALE -

THE DRAWING AND DESIGN HEREIN SHALL NOT BE DUPLICATED, USED OR DISCLOSED TO OTHERS FOR PROCUREMENT OR OTHER PURPOSES EXCEPT AS OTHERWISE AUTHORIZED BY CONTRACT WITHOUT WRITTEN PERMISSION OF SIEMENS BUILDING TECHNOLOGIES, INC. FIRE SAFETY DIVISION. ALL OTHER REPRODUCTIONS SHALL BEAR THIS NOTICE.

REVISIONS

No.	Revision	By	Date	Appr.
1	REVISED PER LBNL FM REVIEW COMMENTS 6-4-12	JPM	6/5/12	KW
	AS-BUILT	JPM	9/19/12	KW

AS-BUILT

INSTALLATION CONTRACTORS NAME & ADDRESS:

M & M ELECTRIC

1009 Gettysburg Way,
Modesto, CA 95355

Tel (209) 204-2798

PRODUCT MANUFACTURER:

Siemens Industry, Inc.
Fire Safety Division

25821 Industrial Boulevard, Suite 300
Hayward, California 94545-2991
Tel (510) 783-6000 Fax (510) 293-2100

California State C10 License No. 758796
U.L. Certificate ID No. 324787-001

SITE NAME & LOCATION (STREET, BUILDING):

UNIVERSITY OF CALIFORNIA
LAWRENCE BERKELEY NATIONAL LABORATORY
FACILITIES DIVISION

BUILDING 6
VESDA

One Cyclotron Road,
Berkeley, California 94720

SHEET CONTENTS:

(E) SYSTEM 3 FIRE ALARM PANEL & DETAILS

INSTALLATION TYPE:

- ☐ NEW INSTALLATION
- ☐ DESIGN/BUILD
- ☐ PER CONTRACT DOCUMENT
- ☐ EXISTING BASE JOB # N/A
- ☐ OTHERS

SYSTEM SALES REP.: Kevin Waxman

PROJECT MANAGER: Karen Davis

DRAWN BY: JPM

CAD FILENAME: FA-03

SCALE: Not Applicable

DATE DRAWN: May 29, 2010

PLOT DATE: March 19, 2014

DRAWING NO.: 5B06E348

SHEET: FA-03

JOB NUMBER: 44OP-109114

IF DRAWING IS SMALLER THAN 30" X 42" IS A REDUCED COPY