GENERAL NOTES:

1. REFER TO ASPIRE CALCULATIONS SUBMITTAL BOOK FOR COMPLETE VESDA CALCULATION DETAILS.
2. ENSURE THAT THE VESDA PANELS ARE INSTALLED OUTSIDE OF RADIATION AREAS.
3. THE VESDA PANELS ARE TO BE LOCATED IN AREAS ACCESSIBLE TO THE LBNL FIRE ALARM CREW, EVEN WHEN THE EXPERIMENTS ARE RUNNING IN BUILDING 6.

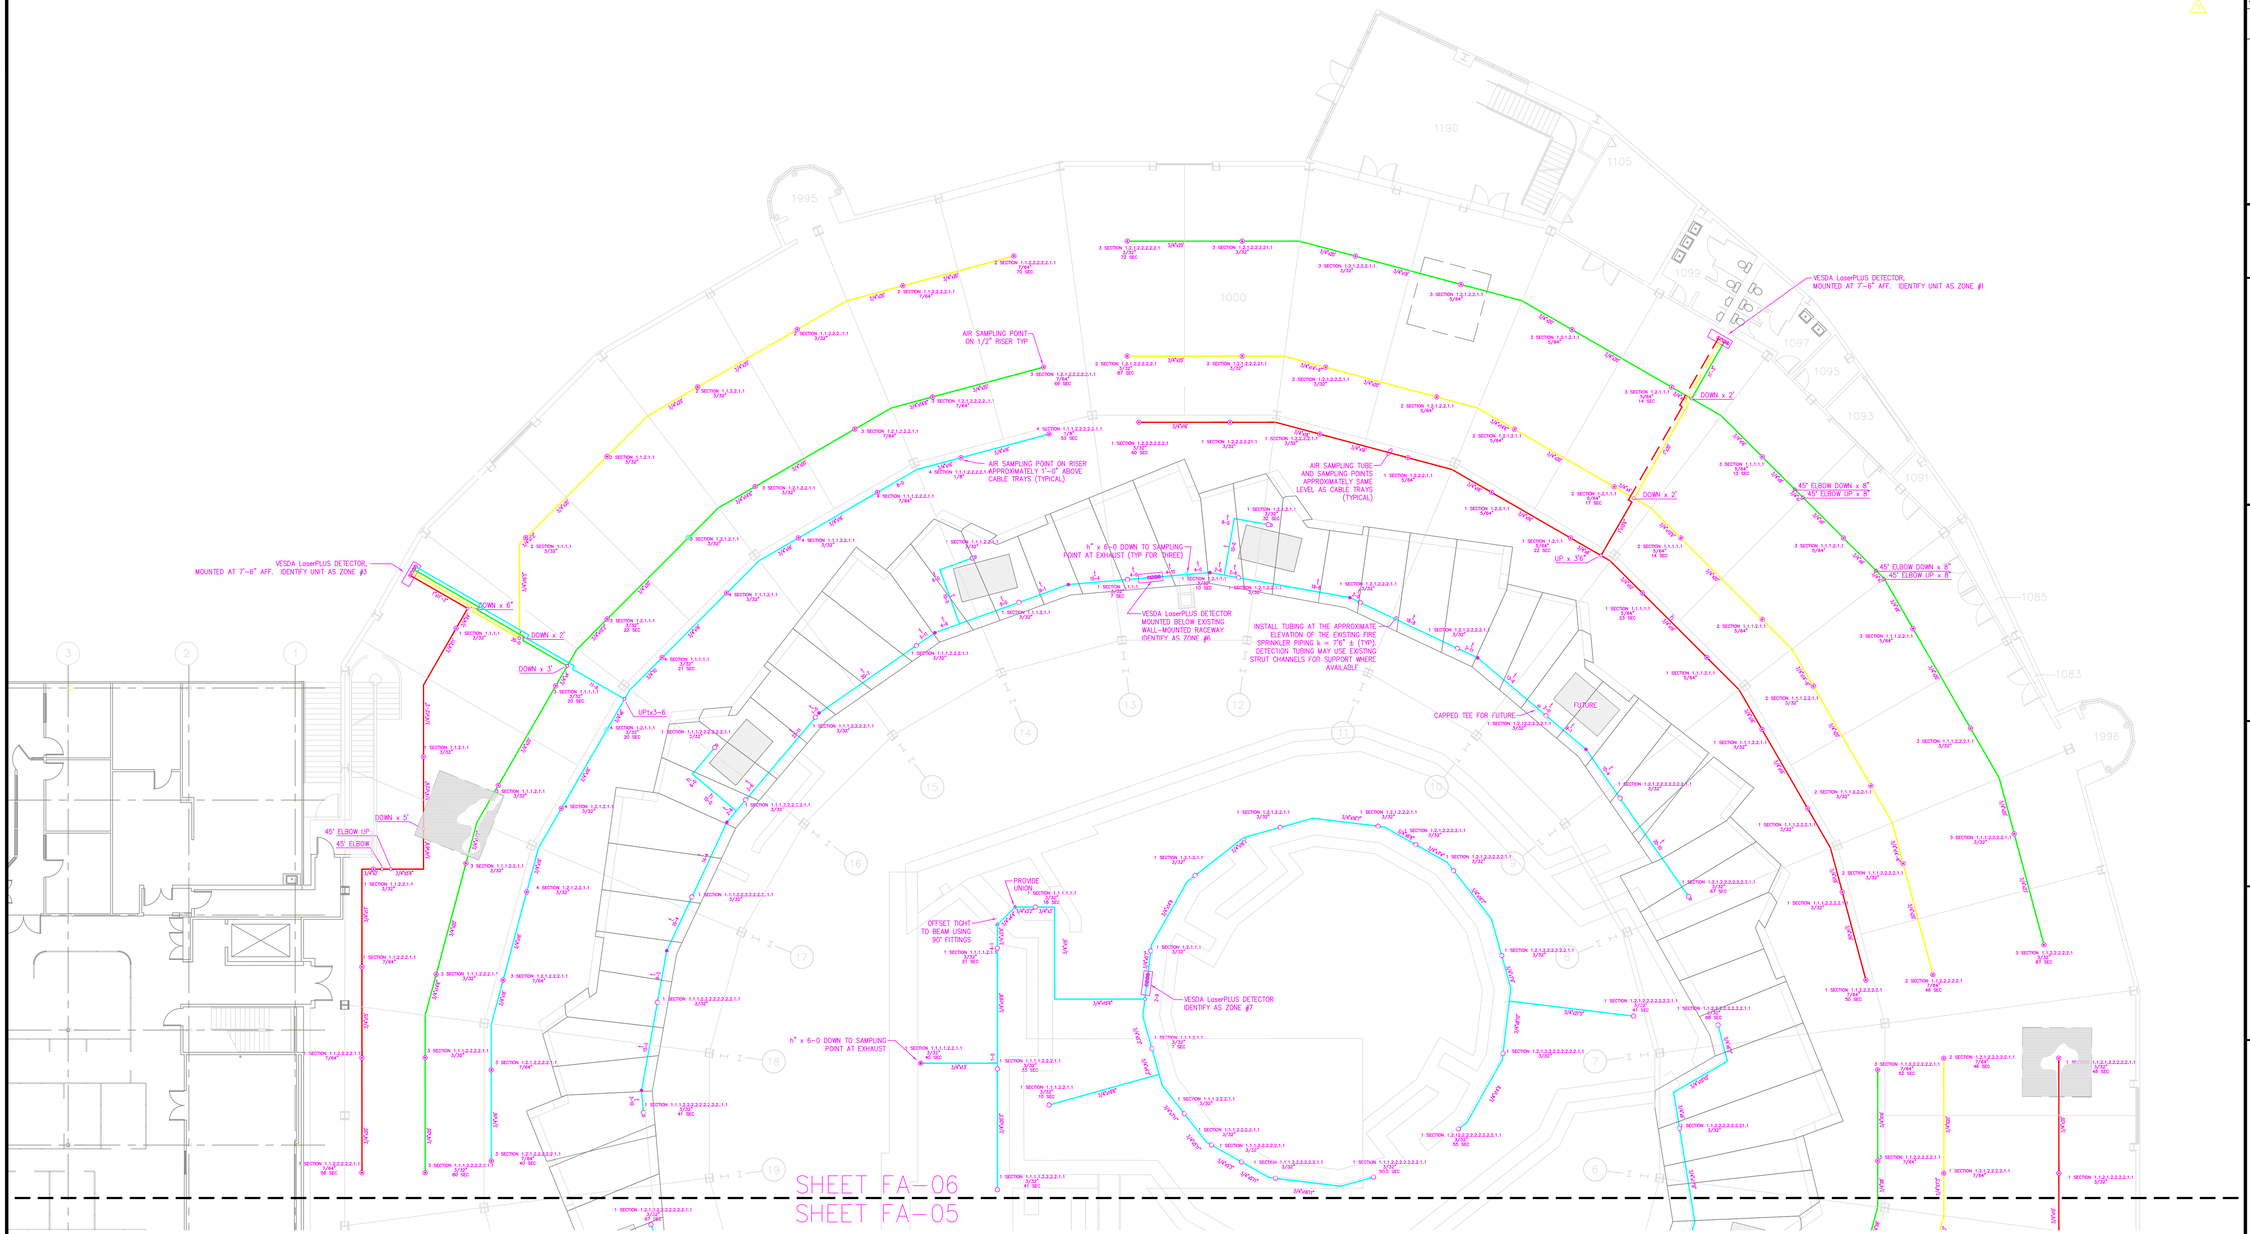

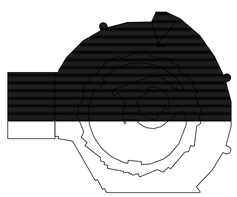

KEY PLAN

THE DRAWING AND DESIGN HEREON SHALL NOT BE REPRODUCED, USED OR DISCLOSED TO OTHERS FOR PROCUREMENT OR OTHER PURPOSE EXCEPT AS OTHERWISE AUTHORIZED BY CONTRACT WITHOUT WRITTEN PERMISSION OF SIEMENS BUILDING TECHNOLOGIES, INC., FIRE SAFETY DIVISION. ALL OTHER REPRODUCTIONS SHALL BEAR THIS NOTICE.

REVISIONS

No.	Revision	By	Date	Appr.
1	REVISED PER LBNL FM REVIEW COMMENTS 6-4-12	JPM	6/5/12	KW
	AS-BUILT	JPM	9/19/12	KW

AS-BUILT

PRIOR TO APPROVAL STAMP

INSTALLATION CONTRACTORS NAME & ADDRESS:

M & M ELECTRIC

1009 Gettysburg Way,
Modesto, CA 95355

Tel (209) 204-2798

PRODUCT MANUFACTURER:

Siemens Industry, Inc.
Fire Safety Division

25821 Industrial Boulevard, Suite 300
Hayward, California 94545-2991
Tel (510) 783-6000 Fax (510) 293-2100

California State C10 License No. 758796
U.L. Certificate ID No. 324787-001

JOB NAME & LOCATION (STREET ADDRESS):

UNIVERSITY OF CALIFORNIA
LAWRENCE BERKELEY NATIONAL LABORATORY
FACILITIES DIVISION

BUILDING 6
VESDA

One Cyclotron Road,
Berkeley, California 94720

SHEET CONTENTS:

VESDA PIPING
LAYOUT - FIRST FLOOR

INSTALLATION TYPE:

- ☐ NEW INSTALLATION
- ☐ DESIGN/BUILD
- ☐ PER CONTRACT DOCUMENT
- ☐ EXISTING BASE JOB # N/A
- ☐ OTHERS

SYSTEM SALES REP.:	Kevin Waxman
PROJECT MANAGER:	Karen Davis
DRAWN BY:	JPM
CAD FILENAME:	FA-06
SCALE:	3/32" = 1'-0"
DATE DRAWN: May 29, 2010	PLOT DATE: March 19, 2014
SHEET: FA-06	JOB NUMBER: 44OP-109114

DRAWING NO. 5B06E351

THIS DRAWING IS SMALLER THAN 24" X 42" IS A REDUCED COPY