


1 FAO.1 FIRE ALARM CONTROL UNIT DETAIL
SCALE: NONE

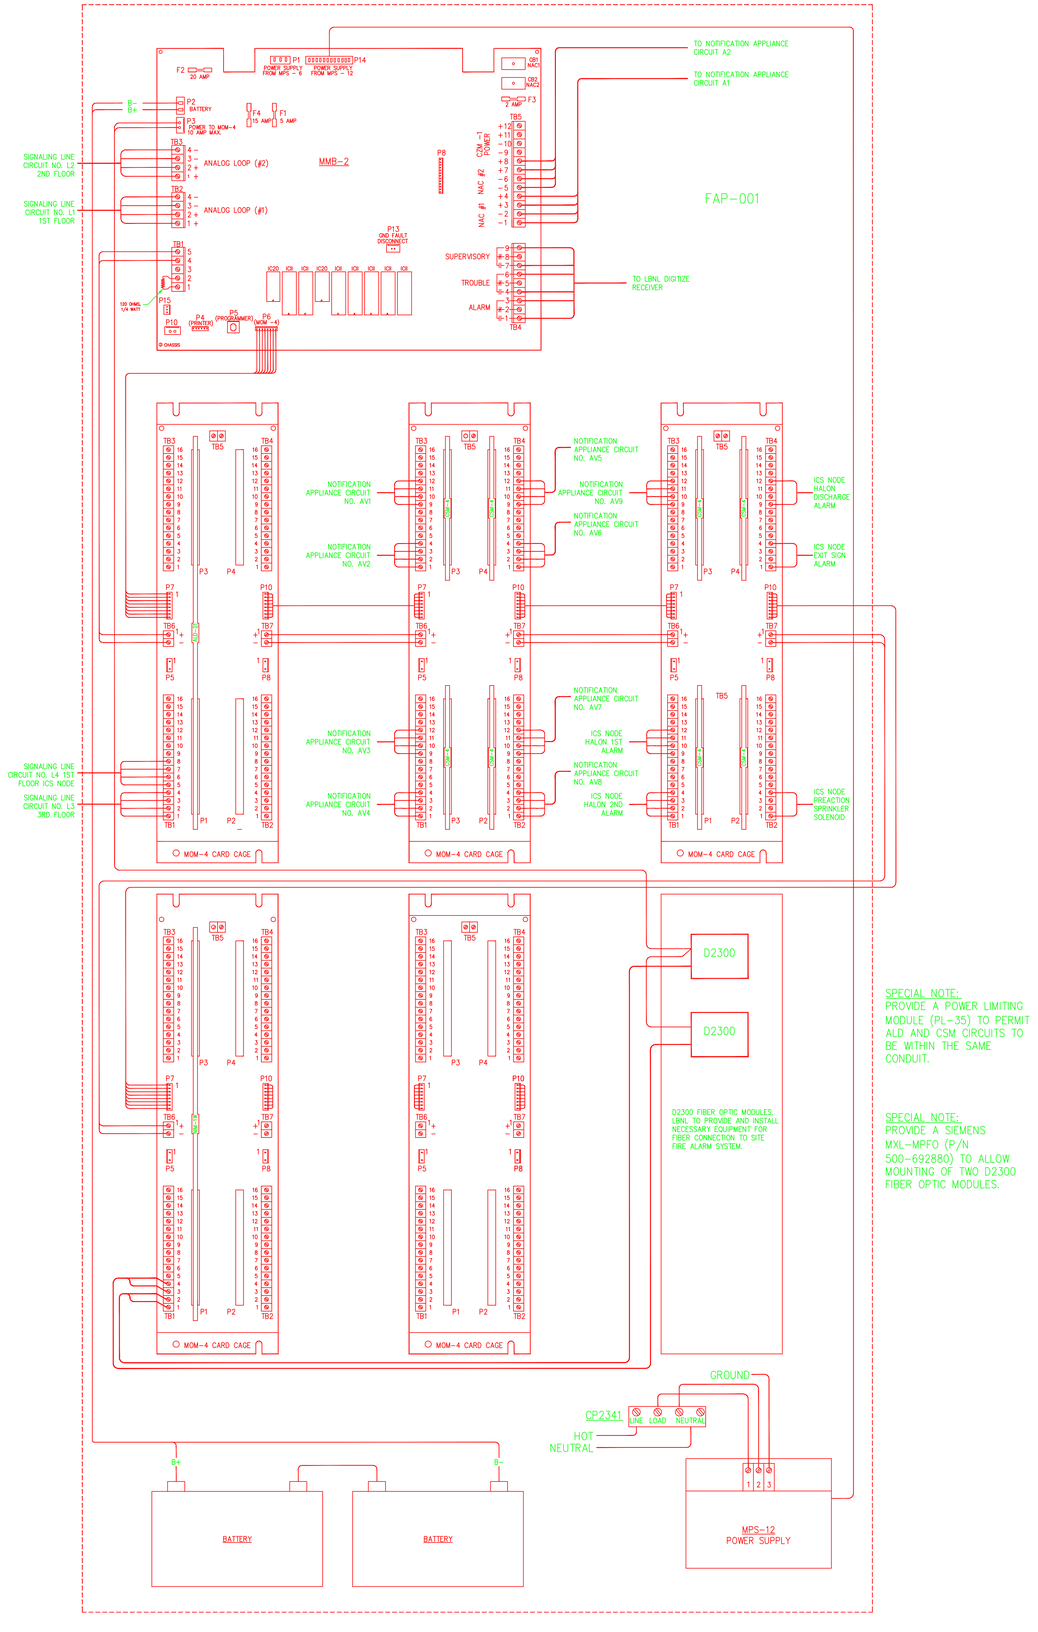


2 FAO.1 NOTIFICATION APPLIANCE RISER DIAGRAM
SCALE: NONE

3 FAO.1 SIGNALING LINE CIRCUIT RISER DIAGRAM
SCALE: NONE


WRNS STUDIO LLP
501 SECOND STREET
4TH FLOOR, STE. 402
SAN FRANCISCO
CALIFORNIA 94107
415.489.2224 TEL
415.358.9100 FAX
WWW.WRNSSTUDIO.COM


Missing or invalid reference
File: .\Tresidder 2012 PE Stamp
Sheet: 1

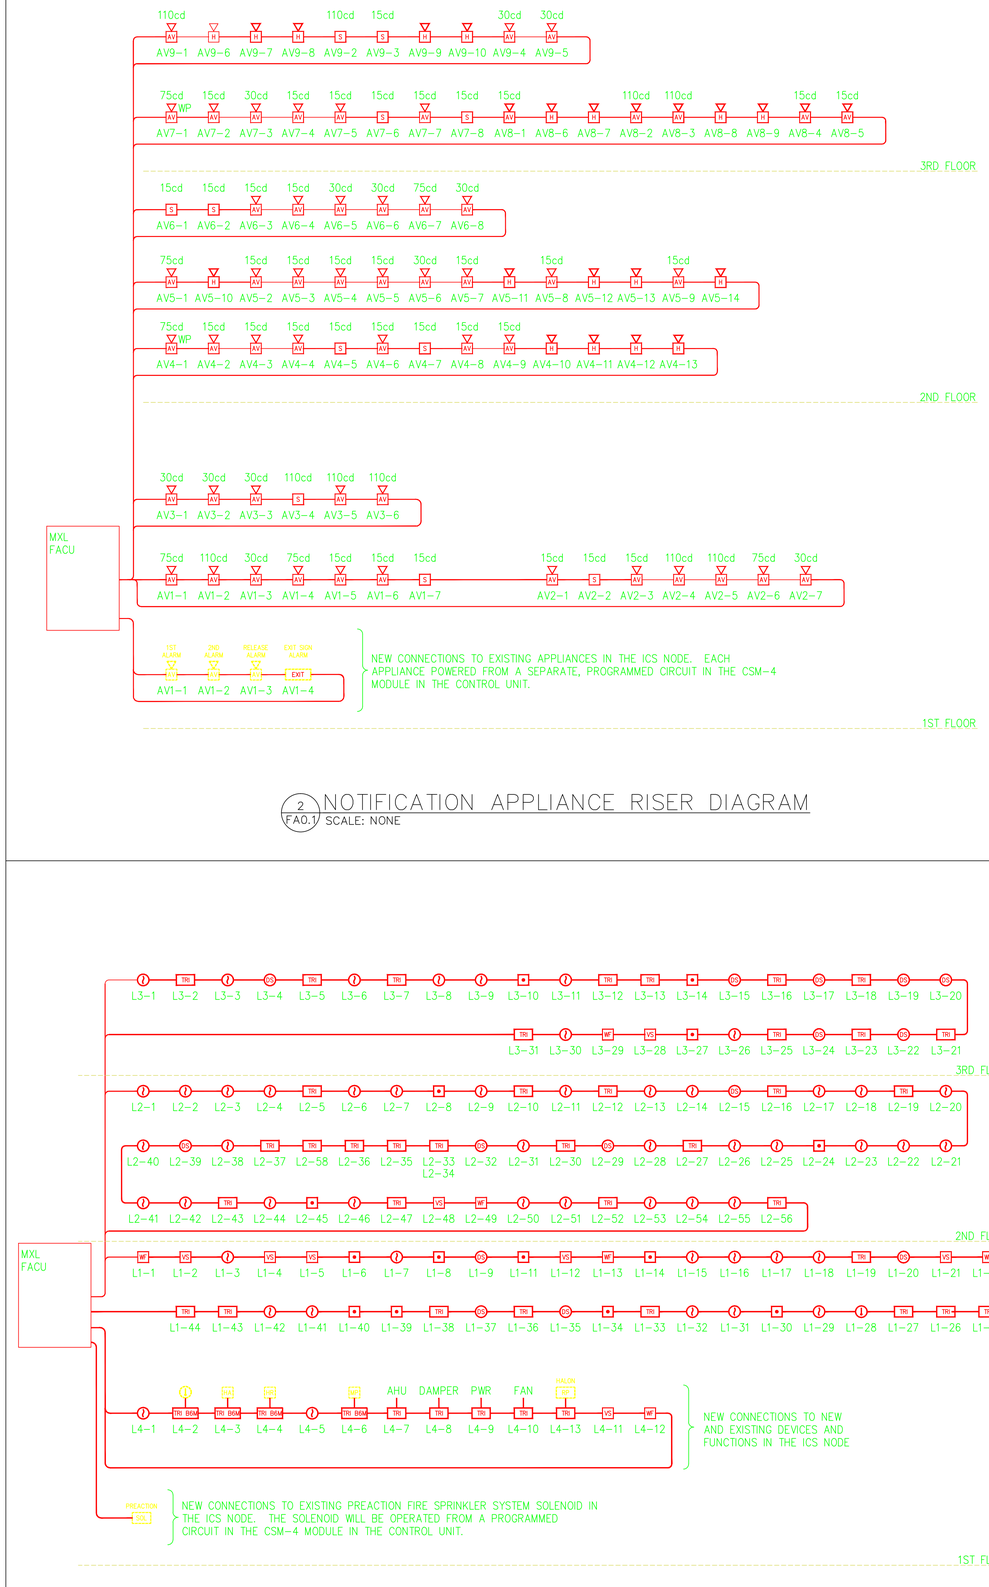
HYT Corporation
Fire Protection Engineers
and Consultants
3498 Clayton Road - Suite 101
Concord, California 94519
Phone: (925) 681-2731
FAX: (925) 681-2733


| NO. | ISSUES/REVISONS | DATE |
|---|---|---|
| | FINAL AS-BUILTS RECORD DRAWINGS | 02-18-11 |

RECORD DRAWING NOTE: SEE ALSO SIEMENS INDUSTRY, INC. "AS BUILT" PLANS (JOB 440P-065295) FOR ADDITIONAL INFORMATION AND CONTRACTOR DETAILS.

LBNL ADVANCED LIGHT SOURCE USER SUPPORT BUILDING 15
BERKELEY, CA

KEY PLAN

| | | | |
|---|---|---|---|
| PROJECT NO.: | 07004.00 | DRAWN BY: | DWH |
| DATE: | 2/18/2011 | CHECKED BY: | BBT |
| SCALE: | AS NOTED | | |

SHEET TITLE:

FIRE ALARM RISER SCHEMATICS AND DETAILS

5N15E041

SHEET NO:

FN1421 FA-0.1


All drawings and written material appearing herein constitute original and unpublished work of the Architect/Engineer and may not be duplicated, used or disclosed without consent of Architect/Engineer.


If this drawing is not 30"x42", then the drawing has been revised from its original size. Noted scales must be adjusted. This line should be equal to one inch