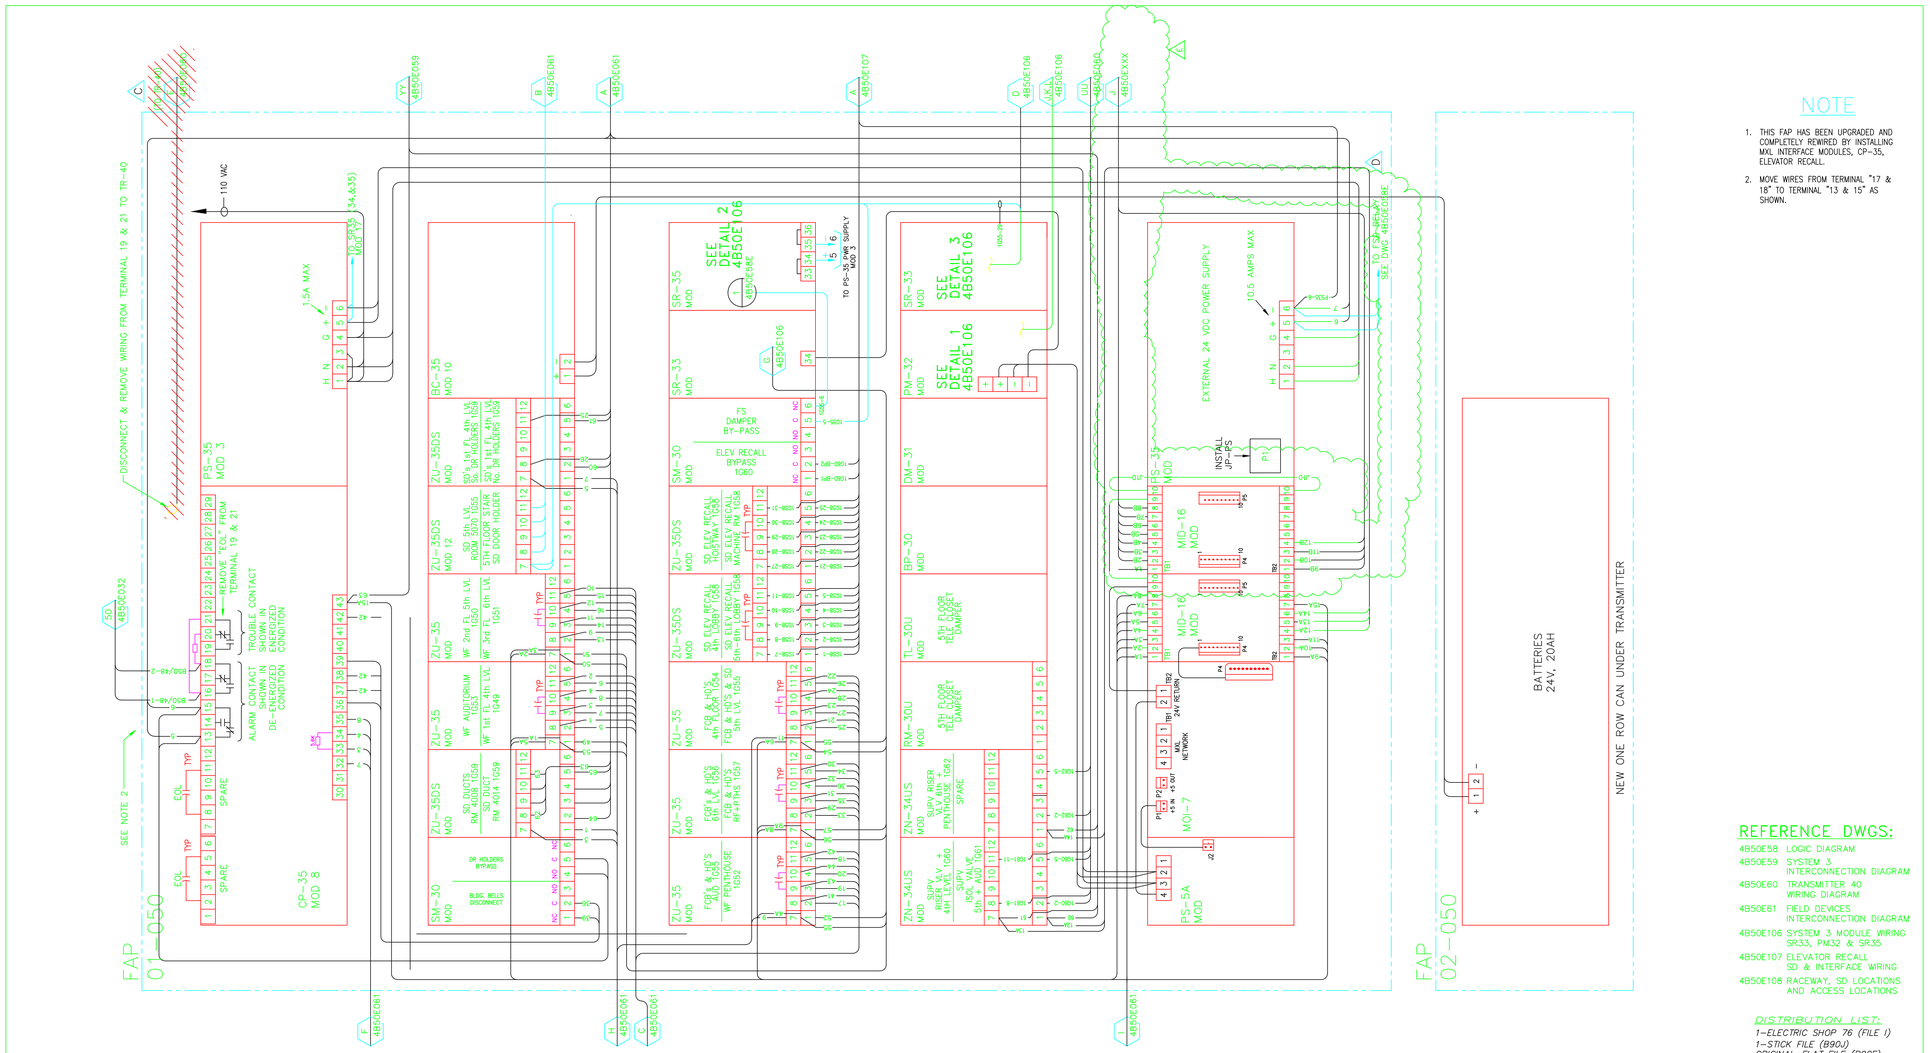

NOTE

1. THIS FAP HAS BEEN UPGRADED AND COMPLETELY REWIRED BY INSTALLING MXL INTERFACE MODULES, CP-35, ELEVATOR RECALL.
2. MOVE WIRES FROM TERMINAL "17 & 18" TO TERMINAL "13 & 15" AS SHOWN.

REFERENCE DWGS:

4B50E58 LOGIC DIAGRAM
4B50E59 SYSTEM 3 INTERCONNECTION DIAGRAM
4B50E60 TRANSMITTER 40 WIRING DIAGRAM
4B50E61 FIELD DEVICES INTERCONNECTION DIAGRAM
4B50E106 SYSTEM 3 MODULE WIRING SR33, PM32 & SR35
4B50E107 ELEVATOR RECALL SD & INTERFACE WIRING
4B50E108 RACEWAY, SD LOCATIONS AND ACCESS LOCATIONS

DISTRIBUTION LIST:
1-ELECTRIC SHOP 76 (FILE I)
1-STICK FILE (B90J)
ORIGINAL-FLAT FILE (B90F)

REVISION NUMBER	DRAWN BY	CHECKED BY	APPR'D BY	DATE	REMARKS
E	HYT	HYT	–	06/30/05	SEISMIC UPGRADE PROJECT PHASE 1
D	VDA	MCG	MCG	06/30/05	ADD SMOKE DETECTOR TO ZONE 1G55
C	AD	MCG	MCG	04/15/05	REVISED FOR MXL/DIGITIZE SYSTEMS
B	GMS	MCG	MCG	02/09/04	COMPLETE REWIRE, UPGRADE TO CP-35 & NEW MODULES
A			MCG		AUTOCAD CONVERSION OF DWG. 6B50E027 REV F

PROFESSIONAL SEAL (IF REVISION, APPLIES ONLY TO REVISED WORK)
ISSUE (PROGRESS, ESTIMATE, BID, CONSTRUCTION, CONFORMED, REVISION, RECORD)

50 FAP-01-050
FIRE ALARM SYSTEM
SYSTEM 3 INTERCONNECTION DIAGRAM

UNIVERSITY OF CALIFORNIA
LAWRENCE BERKELEY NATIONAL LABORATORY
FACILITIES DIVISION

DRAWN BY LM	DATE 3/20/1997
CHECKED BY	
APPROVED BY MCG	
CAD FILE PATH 00019780	
SCALE As Noted	
DRAWING NO. 4B50E059E	SHEET FA0.2 1 OF 1
PROJECT NO. TBD	

UNIVERSITY OF CALIFORNIA
LAWRENCE BERKELEY NATIONAL LABORATORY
FACILITIES DIVISION
BERKELEY LAB
OWNER

160 Pine Street
San Francisco, CA 94111

Tel 415.781.9800
Fax 415.788.5216
www.rttw.com

CONSULTING FIRM

HYT Corporation
Fire Protection Engineers and Consultants
3498 Clayton Road - Suite 101 Concord, California 94519
Phone: (925) 681-2731 FAX: (925) 681-2733

CONSULTING A/E FIRM

PROFESSIONAL SEAL (IF REVISION, APPLIES ONLY TO REVISED WORK)

RECORD DRAWING
09/14/2010

REVISION NUMBER	DRAWN BY	CHECKED BY	APPR'D BY	DATE	REMARKS
				09/14/2010	RECORD DRAWINGS

ISSUE (PROGRESS, ESTIMATE, BID, CONSTRUCTION, CONFORMED, REVISION, AS-BUILT)

LBNL SEISMIC AND STRUCTURAL SAFETY UPGRADE - PHASE 1
BUILDING 50
FIRE ALARM SYSTEM SYSTEM 3 INTERCONNECTION DIAGRAM

UNIVERSITY OF CALIFORNIA
LAWRENCE BERKELEY NATIONAL LABORATORY
FACILITIES DIVISION

DRAWN BY DWH	DATE 09/14/2010
CHECKED BY BBT	09/14/2010
APPROVED BY	
CAD FILE PATH 00023232	
SCALE As Noted	
DRAWING NO. 6N50E130	SHEET FA0.2-50
PROJECT NO. FN7200	