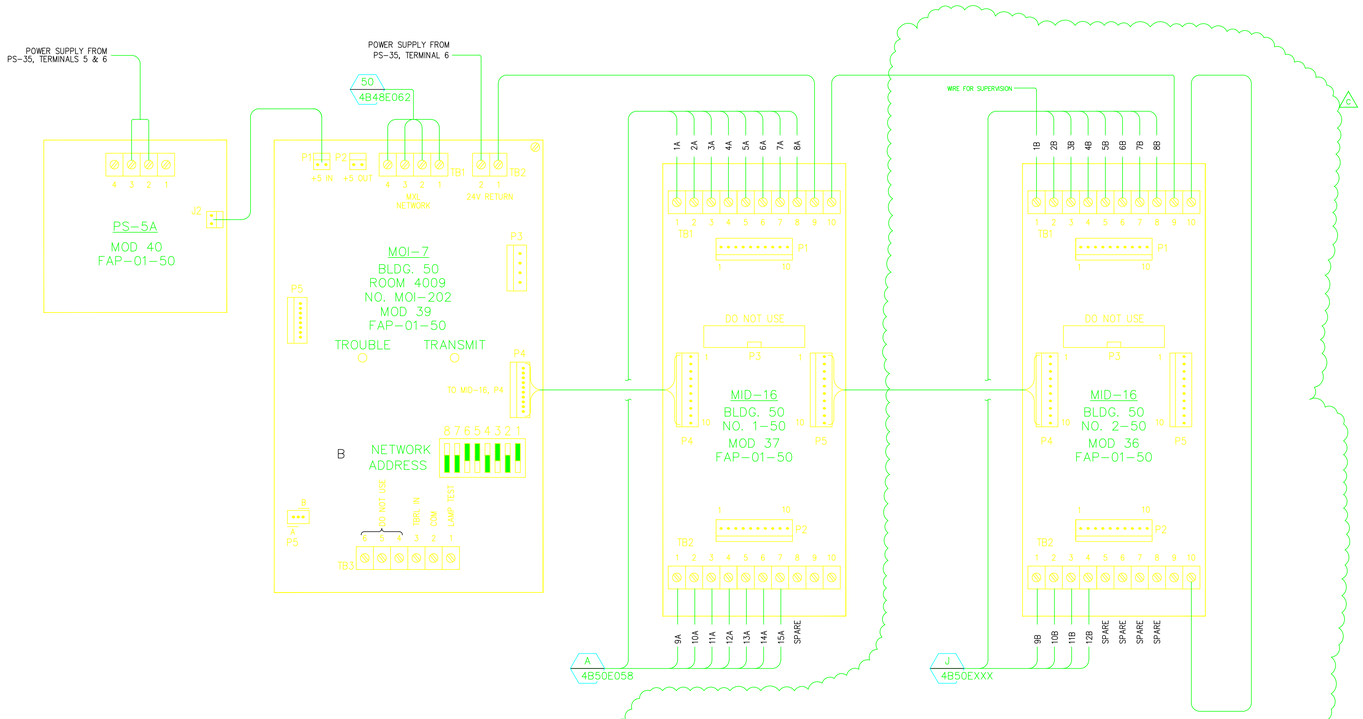

OLD ADDRESS	DESCRIPTION	MID-16 TERMINATION	MODULE TYPE & NO.	MXL NO. 02-50B ADDRESS
1G49	WATER FLOW 1ST-4TH LVL	TB. 1 NO. 1	MID-16 NO. 1-50	2-202-1
1G50	WATER FLOW 2ND-5TH LVL	TB. 1 NO. 2	MID-16 NO. 1-50	2-202-2
1G51	WATER FLOW 3RD & 6TH LVL	TB. 1 NO. 3	MID-16 NO. 1-50	2-202-3
1G52	WATER FLOW PENTHOUSE	TB. 1 NO. 4	MID-16 NO. 1-50	2-202-4
1G53	WATER FLOW AUDITORIUM	TB. 1 NO. 5	MID-16 NO. 1-50	2-202-5
1G54	FCB & HD'S 1ST-4TH LVL	TB. 1 NO. 6	MID-16 NO. 1-50	2-202-6
1G55	FCB & HD'S 2ND/5TH/AUDITORIUM	TB. 1 NO. 7	MID-16 NO. 1-50	2-202-7
1G56	FCB & HD'S 3RD & 6TH LVL	TB. 1 NO. 8	MID-16 NO. 1-50	2-202-8
1G57	FCB & HD'S ROOF/PENTHOUSE	TB. 2 NO. 1	MID-16 NO. 1-50	2-202-9
1G58	SD ELEVATOR RECALL	TB. 2 NO. 2	MID-16 NO. 1-50	2-202-10
1G59	SD-DUCTS	TB. 2 NO. 3	MID-16 NO. 1-50	2-202-11
1G60	VALVE SUPERVISION RISER VALVE & 4TH LVL	TB. 2 NO. 4	MID-16 NO. 1-50	2-202-12
1G61	VALVE SUPERVISION 2ND/5TH & AUDITORIUM	TB. 2 NO. 5	MID-16 NO. 1-50	2-202-13
1G62	VALVE SUPERVISION RISER/4TH/6TH & AUDITORIUM	TB. 2 NO. 6	MID-16 NO. 1-50	2-202-14
1G63	SYSTEM 3 TROUBLE	TB. 2 NO. 7	MID-16 NO. 1-50	2-202-15
1G64	MX-203 TROUBLE	TB. 2 NO. 8	N/A	N/A

OLD ADDRESS	DESCRIPTION	MID-16 TERMINATION	MODULE TYPE & NO.	MXL NO. 02-50B ADDRESS
NA	MODULE SUPERVISION	TB. 1 NO. 1	MID-16 NO. 2-50	2-202-16
NA	4TH FLOOR CORRIDOR DOORS SD	TB. 1 NO. 2	MID-16 NO. 2-50	2-202-17
NA	5TH FLOOR CORRIDOR DOORS SD	TB. 1 NO. 3	MID-16 NO. 2-50	2-202-18
NA	6TH FLOOR CORRIDOR DOORS SD	TB. 1 NO. 4	MID-16 NO. 2-50	2-202-19
NA	4TH FLOOR CORRIDOR HSSD LEVEL 3	TB. 1 NO. 5	MID-16 NO. 2-50	2-202-20
NA	5TH FLOOR CORRIDOR HSSD LEVEL 3	TB. 1 NO. 6	MID-16 NO. 2-50	2-202-21
NA	6TH FLOOR CORRIDOR HSSD LEVEL 3	TB. 1 NO. 7	MID-16 NO. 2-50	2-202-22
NA	HSSD POWER SUPPLY #1 SUPERVISION	TB. 1 NO. 8	MID-16 NO. 2-50	2-202-23
NA	HSSD POWER SUPPLY #1 SUPERVISION	TB. 2 NO. 1	MID-16 NO. 2-50	2-202-24
NA	4TH FLOOR CORRIDOR HSSD SUPERVISION	TB. 2 NO. 2	MID-16 NO. 2-50	2-202-25
NA	5TH FLOOR CORRIDOR HSSD SUPERVISION	TB. 2 NO. 3	MID-16 NO. 2-50	2-202-26
NA	6TH FLOOR CORRIDOR HSSD SUPERVISION	TB. 2 NO. 4	MID-16 NO. 2-50	2-202-27
NA	SPARE	TB. 2 NO. 5	MID-16 NO. 2-50	SPARE
NA	SPARE	TB. 2 NO. 6	MID-16 NO. 2-50	SPARE
NA	SPARE	TB. 2 NO. 7	MID-16 NO. 2-50	SPARE
NA	SPARE	TB. 2 NO. 8	MID-16 NO. 2-50	SPARE

PROFESSIONAL SEAL OF REVISION, APPLIES ONLY TO REVISED WORK

ISSUE (PROGRESS, ESTIMATE, BID, CONSTRUCTION, CONFORMED, REVISION, RECORD)

REVISION NUMBER	DRAWN BY	CHECKED BY	APPR'D BY	DATE	REMARKS
C	HYT	HYT		6/24/08	SEISMIC UPGRADE PROJECT PHASE 1
B	AD	LDD	MCD	03/06/08	REVISED FOR MXL COPPER LOOP
A	AD	MCG	MCG	04/13/05	REVISED FOR MXL/DIGITIZE SYSTEMS

50
REPLACEMENT FIRE ALARM SYSTEM
MOI/MID MODULE ARRANGEMENT

UNIVERSITY OF CALIFORNIA
LAWRENCE BERKELEY NATIONAL LABORATORY
FACILITIES DIVISION

DRAWN BY AD	DATE 4/12/2005
CHECKED BY MCG	4/12/2005
APPROVED BY MCG	4/12/2005
CAD FILE PATH 00021031	
SCALE Full	
DRAWING NO. 4B50E119C	SHEET FA0.3
PROJECT NO. TBD	1 OF 1

UNIVERSITY OF CALIFORNIA
LAWRENCE BERKELEY NATIONAL LABORATORY
FACILITIES DIVISION
BERKELEY LAB

OWNER

160 Pine Street
San Francisco, CA 94111

Tel 415.781.9800
Fax 415.788.5216
www.rmw.com

CONSULTING FIRM

HYT Corporation
Fire Protection Engineers and Consultants
3498 Clayton Road - Suite 101 Concord, California 94519
Phone: (925) 681-2731 FAX: (925) 681-2733

CONSULTING AE FIRM

PROFESSIONAL SEAL OF REVISION, APPLIES ONLY TO REVISED WORK

RECORD DRAWING
09/14/2010

ISSUE (PROGRESS, ESTIMATE, BID, CONSTRUCTION, CONFORMED, REVISION, AS-BUILT)

REVISION NUMBER	DRAWN BY	CHECKED BY	APPR'D BY	DATE	REMARKS
				09/14/2010	RECORD DRAWINGS

LBNL SEISMIC AND STRUCTURAL SAFETY UPGRADE - PHASE 1
BUILDING 50
FIRE ALARM SYSTEM - MOI/MID MODULE ARRANGEMENT

UNIVERSITY OF CALIFORNIA
LAWRENCE BERKELEY NATIONAL LABORATORY
FACILITIES DIVISION

DRAWN BY DWH	DATE 09/14/2010
CHECKED BY BBT	09/14/2010
APPROVED BY	
CAD FILE PATH 00023232	
SCALE As Noted	
DRAWING NO. 6N50E131	SHEET FA0.3-50
PROJECT NO. FN7200	