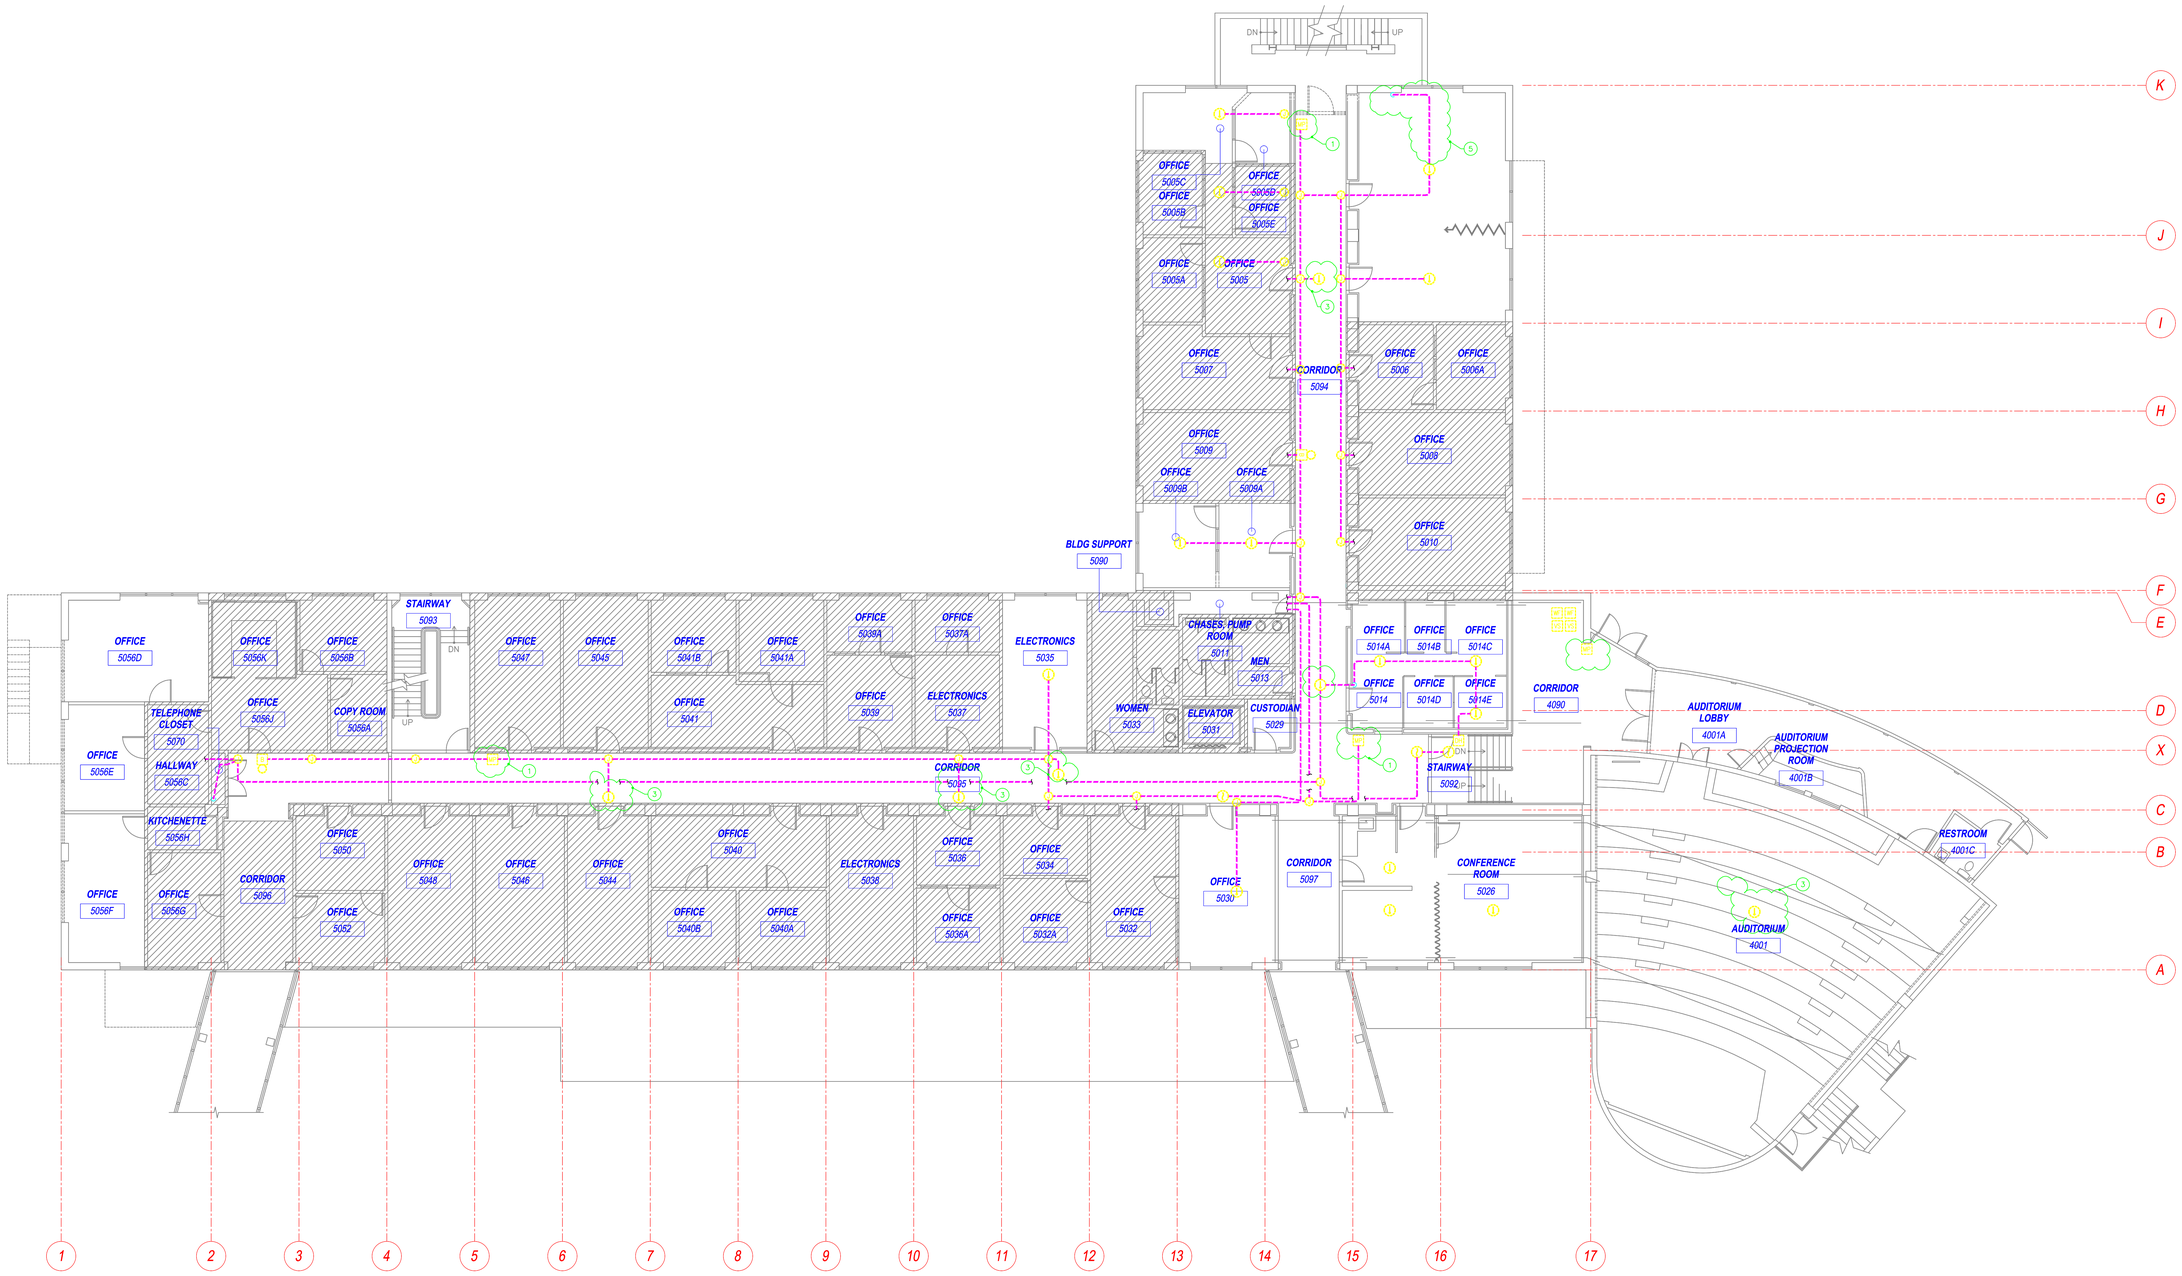

1 5TH LEVEL DEMOLITION PLAN - FIRE ALARM
1/8" = 1'-0"

KEY NOTES:

1. CAREFULLY REMOVE INDICATED FIRE CALL BOX AND CONDUIT DROP. COMPLETE ALARM CIRCUIT TO PLACE SYSTEM BACK INTO SERVICE. PROVIDE TEMPORARY PLUG/CAP AT JUNCTION BOX. RETAIN FIRE CALL BOX FOR REINSTALLATION WHERE INDICATED.
2. CAREFULLY REMOVE INDICATED SMOKE DETECTOR (AND CONDUIT IF EXPOSED). COMPLETE ALARM CIRCUIT TO PLACE SYSTEM BACK INTO SERVICE. PROVIDE TEMPORARY PLUG/CAP AT JUNCTION BOX. RETAIN SMOKE DETECTOR FOR REINSTALLATION WHERE INDICATED.
3. REMOVE AND DISPOSE OF THE EXISTING HEAT DETECTOR. COMPLETE ALARM CIRCUIT TO PLACE SYSTEM BACK INTO SERVICE. PROVIDE COVER OVER BOX.
4. CAREFULLY REMOVE INDICATED NOTIFICATION APPLIANCE. COMPLETE ALARM CIRCUIT TO PLACE SYSTEM BACK INTO SERVICE. PROVIDE TEMPORARY PLUG/CAP AT JUNCTION BOX. RETAIN NOTIFICATION APPLIANCE FOR REINSTALLATION WHERE INDICATED.
5. TO THE EXTENT NECESSARY TO FACILITATE SEISMIC STRUCTURAL WORK ELEMENTS IN THIS AREA, REMOVE EXISTING CONDUIT AND SUPPORTS.

UNIVERSITY OF CALIFORNIA
LAWRENCE BERKELEY NATIONAL LABORATORY
FACILITIES DIVISION
BERKELEY LAB

OWNER

CONSULTING FIRM

160 Pine Street
San Francisco, CA 94111

Tel 415.781.9800
Fax 415.788.5216
www.rttw.com

HYT Corporation
Fire Protection Engineers and Consultants
3498 Clayton Road - Suite 101 Concord, California 94519
Phone: (925) 681-2731 FAX: (925) 681-2733

CONSULTING AE FIRM

PROFESSIONAL SEAL
(IF REVISION, APPLIES ONLY TO REVISED WORK)

RECORD DRAWING
09/14/2010

ISSUE (PROGRESS; ESTIMATE; BID; CONSTRUCTION; CONFORMED; REVISION; AS-BUILT)

REVISION NUMBER	DRAWN BY	CHECKED BY	APPRVD BY	DATE	REMARKS
				09/14/2010	RECORD DRAWINGS

LBNL SEISMIC AND STRUCTURAL SAFETY UPGRADE - PHASE 1
BUILDING 50
5TH LEVEL DEMOLITION PLAN - FIRE ALARM

UNIVERSITY OF CALIFORNIA
LAWRENCE BERKELEY NATIONAL LABORATORY
FACILITIES DIVISION

DRAWN BY	DWH
DATE	09/14/2010
CHECKED BY	BBT
DATE	09/14/2010
APPROVED BY	
CAD FILE PATH	00023232
SCALE	As Noted
DRAWING NO	6N50E134
SHEET	FA1.5-50
PROJECT NO	FN7200