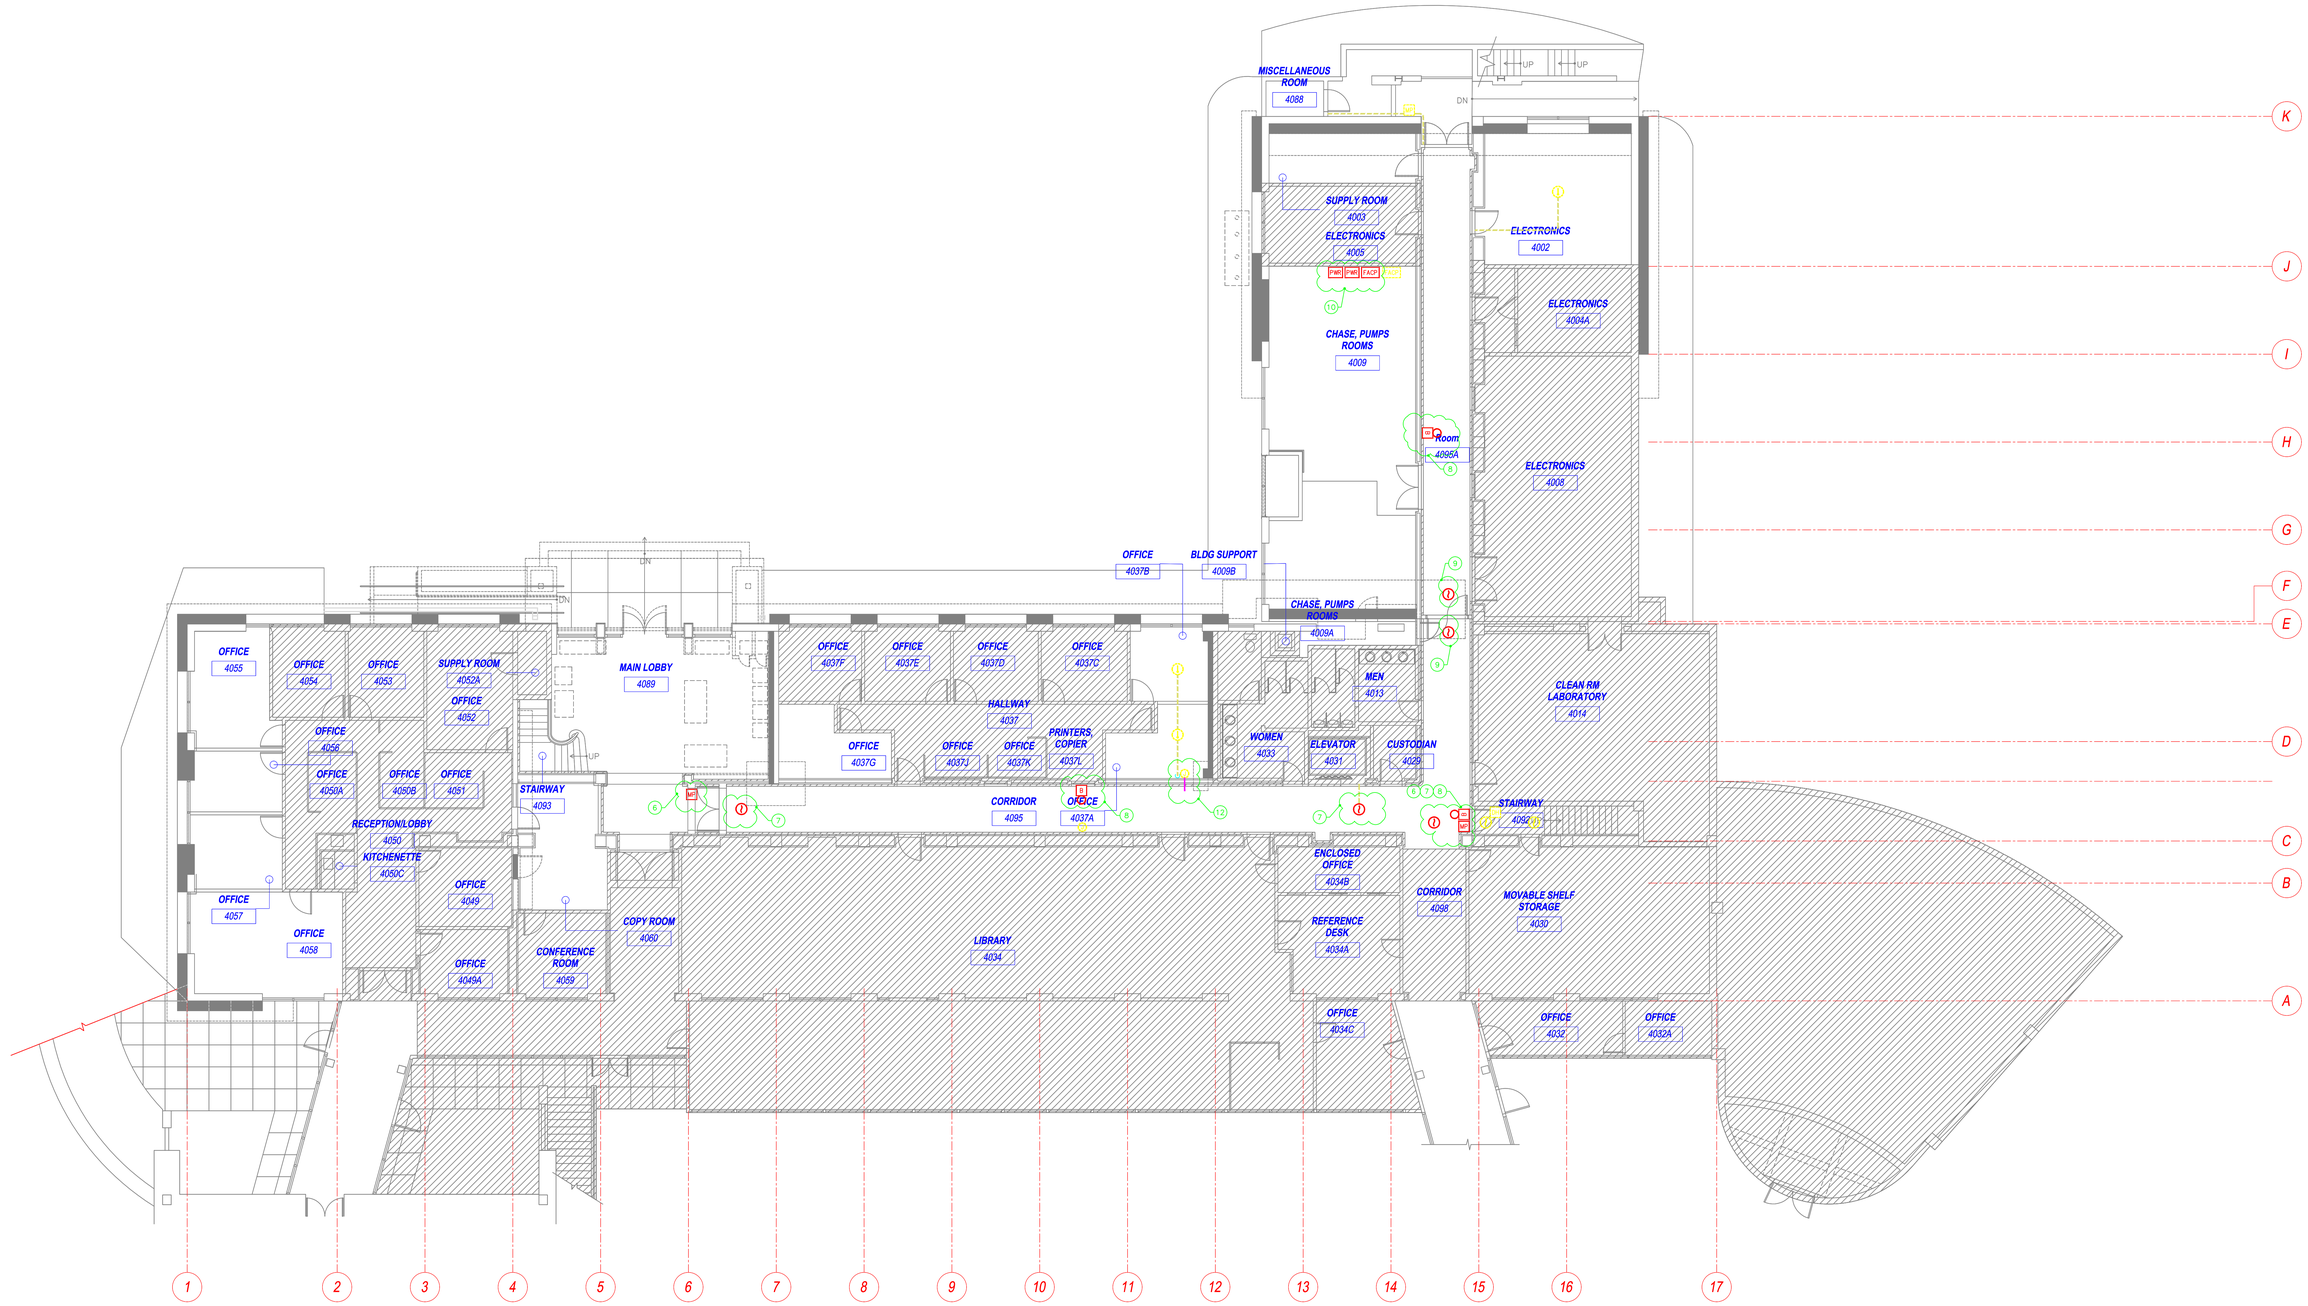

1 4TH LEVEL MODIFICATIONS PLAN - FIRE ALARM
1/8" = 1'-0"

KEY NOTES:

6. INSTALL FIRE CALL BOX (REUSED/EXISTING BOX) AT CORRECT HEIGHT.
7. INSTALL SMOKE DETECTOR (REUSED/EXISTING DETECTOR).
8. INSTALL NOTIFICATION APPLIANCE (REUSED/EXISTING APPLIANCE) AT CORRECT HEIGHT.
9. INSTALL NEW SMOKE DETECTOR FOR DOOR RELEASE.
10. NEW HSSD POWER SUPPLIES AND NEW SYSTEM 3 2-ROW CONTROL UNIT.
11. NEW HSSD SYSTEM.
12. ROUTE NEW CONDUIT AWAY FROM SEISMIC STRUCTURAL WORK. COMPLETE FIRE ALARM CIRCUIT(S).
13. COORDINATE WITH NEW CEILING SYSTEM FOR ACCESS TO DEVICE FOR SERVICING AND TESTING.

UNIVERSITY OF CALIFORNIA
LAWRENCE BERKELEY NATIONAL LABORATORY
FACILITIES DIVISION
BERKELEY LAB
OWNER

CONSULTING FIRM

160 Pine Street
San Francisco, CA 94111

Tel 415.781.9800
Fax 415.788.5216
www.rmw.com

HYT Corporation
Fire Protection Engineers and Consultants
3498 Clayton Road - Suite 101 Concord, California 94519
Phone: (925) 681-2731 FAX: (925) 681-2733
CONSULTING AE FIRM

PROFESSIONAL SEAL
(IF REVISION, APPLIES ONLY TO REVISED WORK)

ISSUE (PROGRESS, ESTIMATE, BID, CONSTRUCTION, CONFORMED, REVISION, AS-BUILT)

RECORD DRAWING
09/14/2010

REVISION NUMBER	DRAWN BY	CHECKED BY	APPRD BY	DATE	REMARKS
				09/14/2010	RECORD DRAWINGS

LBNL SEISMIC AND STRUCTURAL SAFETY UPGRADE - PHASE 1
BUILDING 50
4TH LEVEL MODIFICATIONS PLAN - FIRE ALARM

UNIVERSITY OF CALIFORNIA
LAWRENCE BERKELEY NATIONAL LABORATORY
FACILITIES DIVISION

DRAWN BY	DWH	DATE 09/14/2010
CHECKED BY	BBT	09/14/2010
APPROVED BY		
CAD FILE PATH	00023232	
SCALE	As Noted	
DRAWING NO.	6N50E136	SHEET FA2.4-50
PROJECT NO	FN7200	