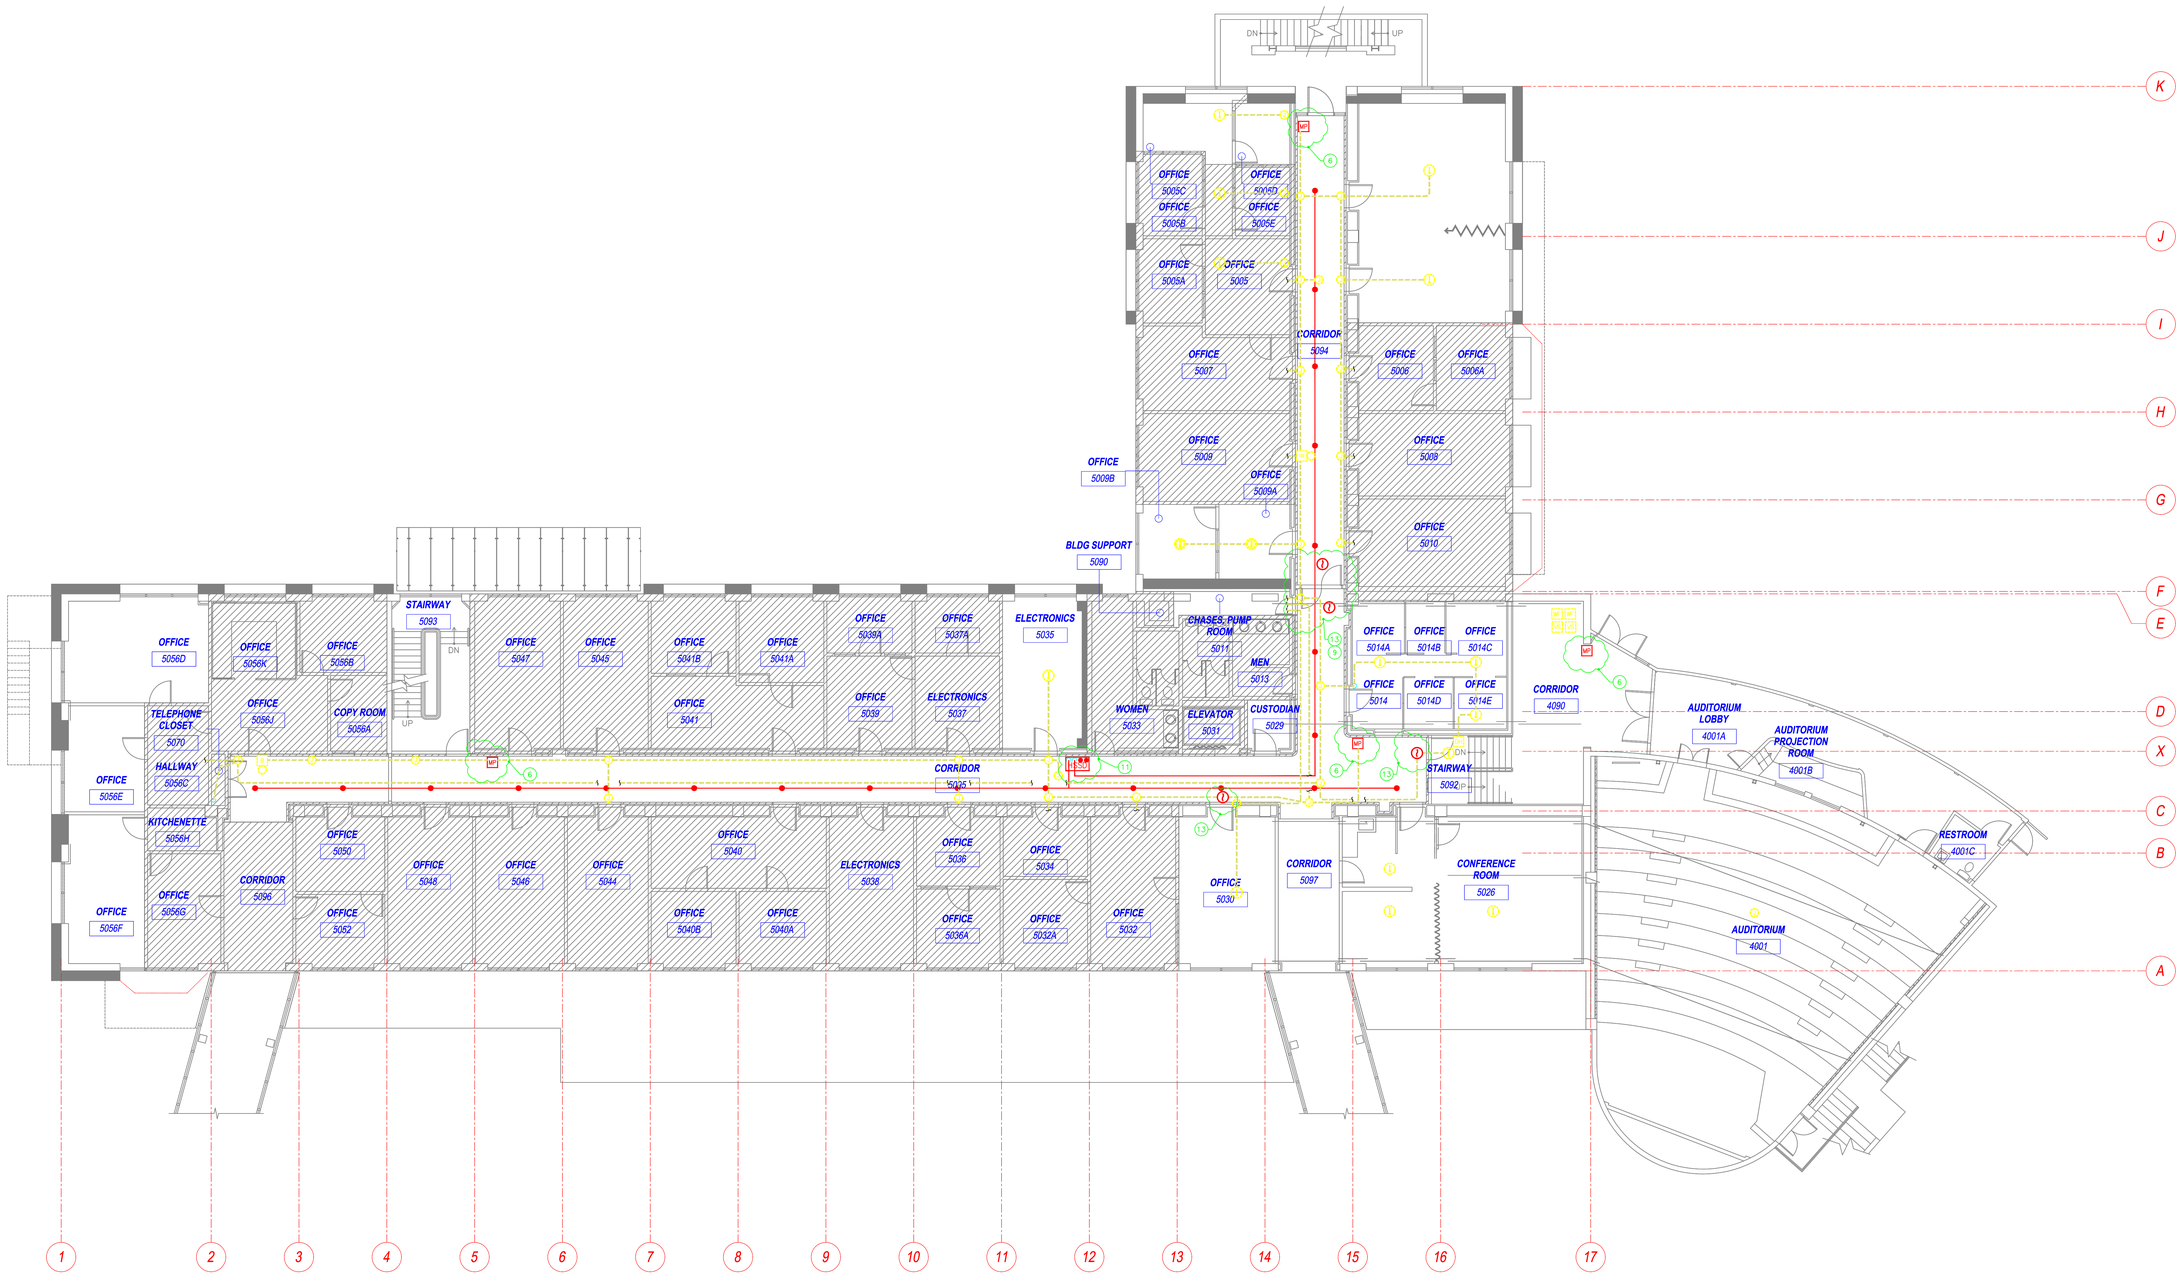


1 5TH LEVEL MODIFICATIONS PLAN - FIRE ALARM
1/8" = 1'-0"

## KEY NOTES:

6. INSTALL FIRE CALL BOX (REUSED/EXISTING BOX) AT CORRECT HEIGHT.
7. INSTALL SMOKE DETECTOR (REUSED/EXISTING DETECTOR).
8. INSTALL NOTIFICATION APPLIANCE (REUSED/EXISTING APPLIANCE) AT CORRECT HEIGHT.
9. INSTALL NEW SMOKE DETECTOR FOR DOOR RELEASE.
10. NEW HSSD POWER SUPPLIES.
11. NEW HSSD SYSTEM.
12. ROUTE NEW CONDUIT AWAY FROM SEISMIC STRUCTURAL WORK. COMPLETE FIRE ALARM CIRCUIT(S).
13. COORDINATE WITH NEW CEILING SYSTEM FOR ACCESS TO DEVICE FOR SERVICING AND TESTING.

UNIVERSITY OF CALIFORNIA
LAWRENCE BERKELEY NATIONAL LABORATORY
FACILITIES DIVISION
BERKELEY LAB

OWNER

CONSULTING FIRM

160 Pine Street
San Francisco, CA 94111

Tel 415.781.9800
Fax 415.788.5216
www.rmw.com

HYT Corporation
Fire Protection Engineers and Consultants
3498 Clayton Road - Suite 101 Concord, California 94519
Phone: (925) 681-2731 FAX: (925) 681-2733

CONSULTING A/E FIRM

PROFESSIONAL SEAL
(IF REVISION, APPLIES ONLY TO REVISED WORK

RECORD DRAWING
09/14/2010

ISSUE (PROGRESS, ESTIMATE, BID, CONSTRUCTION, CONFORMED, REVISION, AS-BUILT)

| REVISION NUMBER | DRAWN BY | CHECKED BY | APPRD BY | DATE | REMARKS |
|---|---|---|---|---|---|
| | | | | 09/14/2010 | RECORD DRAWINGS |

LBNL SEISMIC AND STRUCTURAL SAFETY UPGRADE - PHASE 1
BUILDING 50
5TH LEVEL MODIFICATIONS PLAN - FIRE ALARM

UNIVERSITY OF CALIFORNIA
LAWRENCE BERKELEY NATIONAL LABORATORY
FACILITIES DIVISION

| | | | |
|---|---|---|---|
| DRAWN BY | DWH | DATE | 09/14/2010 |
| CHECKED BY | BBT | | 09/14/2010 |
| APPROVED BY | | | |
| CAD FILE PATH | 00023232 | | |
| SCALE | As Noted | | |
| DRAWING NO | 6N50E137 | SHEET | FA2.5-50 |
| PROJECT NO | FN7200 | | |