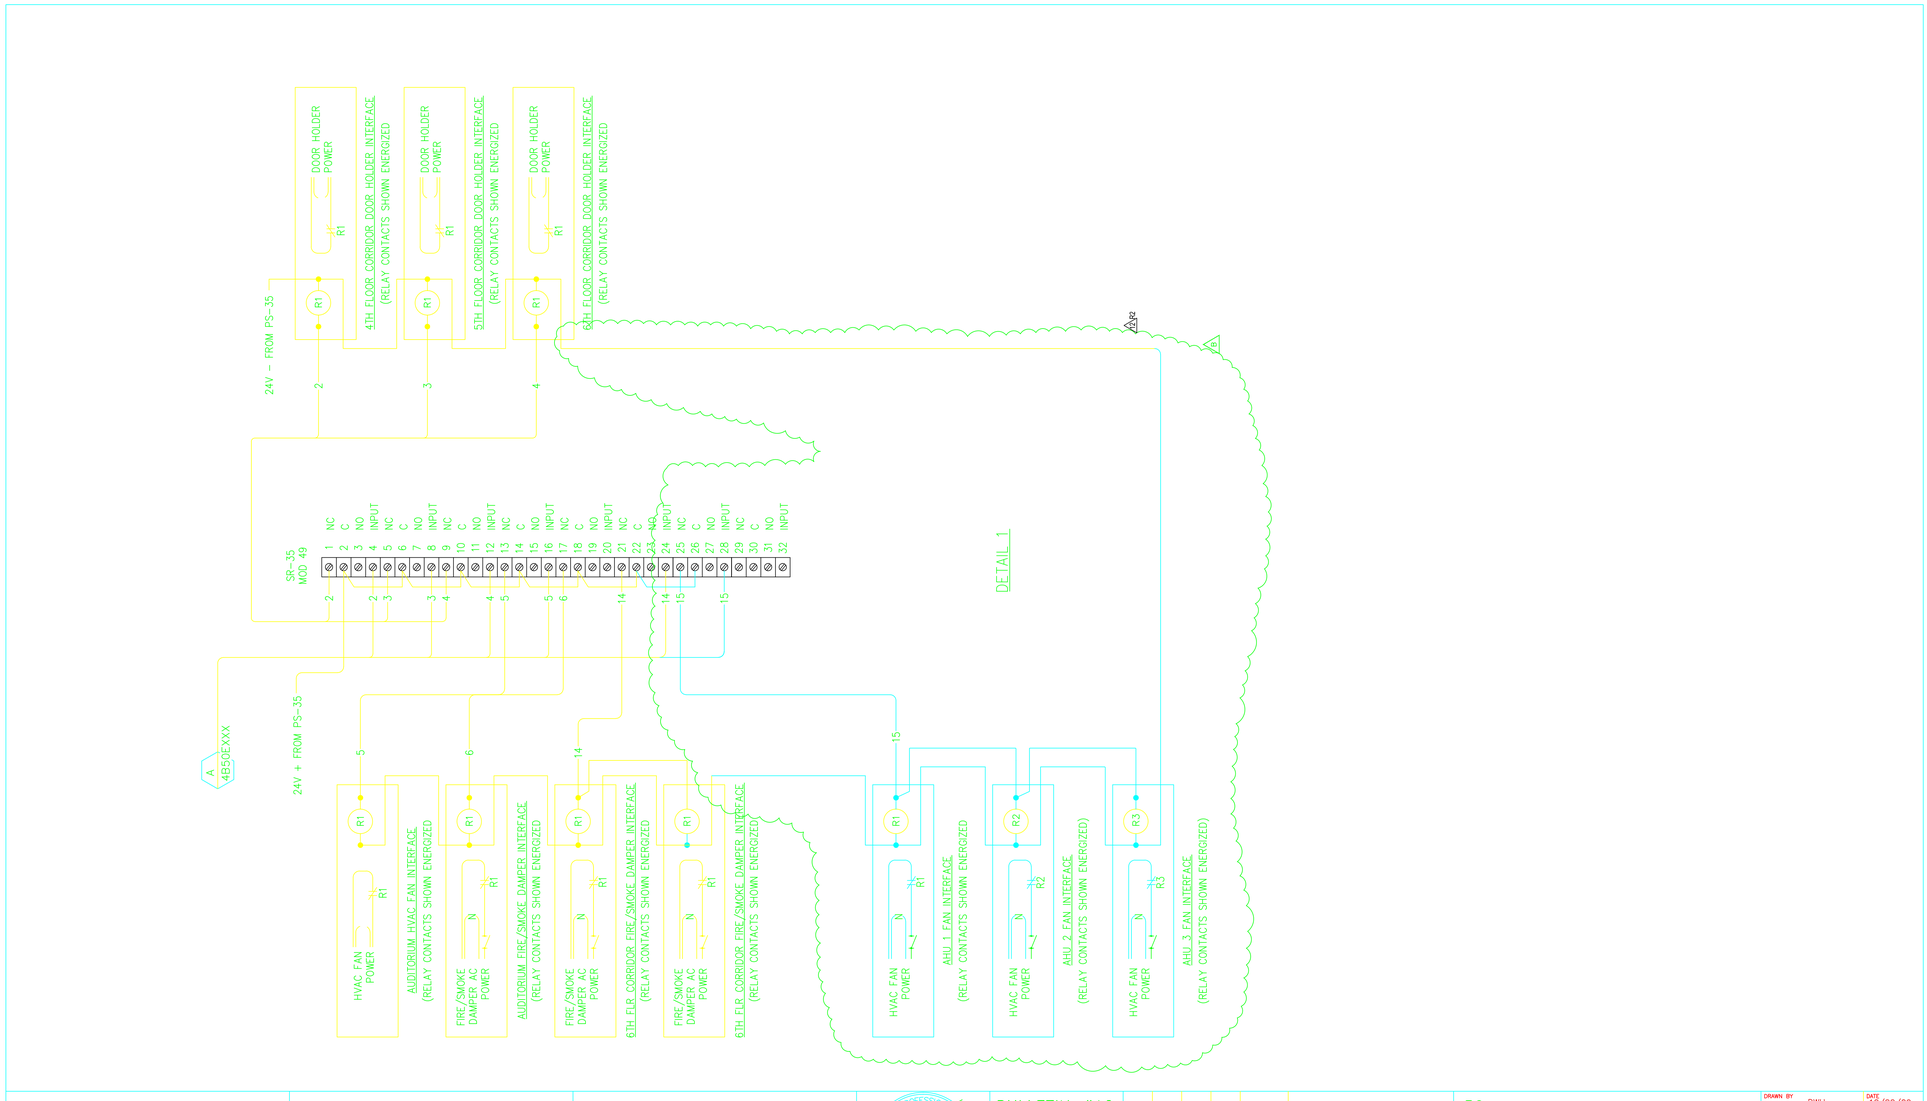

CONSULTING FIRM | CONSULTING FIRM | CONSULTING A/E FIRM | PROFESSIONAL SEAL (IF REVISION, APPLIES ONLY TO REVISED WORK)

REGISTERED PROFESSIONAL ENGINEER BRET B. TREDER No. 1165 Exp. 9/30/10 FIRE PROTECTION STATE OF CALIFORNIA

BULLETIN #12
ADDENDUM #2
100% FINAL DESIGN
04/07/10

ISSUE (PROGRESS, ESTIMATE, BID, CONSTRUCTION, CONFORMED, REVISION, AS-BUILT)

REVISION NUMBER	DRAWN BY	CHECKED BY	APPR'D BY	DATE	REMARKS
B	HYT	HYT		4/2/10	6TH FLOOR PHYSICS SUITE PROJECT REVISIONS
A	HYT	HYT		12/22/09	6TH FLOOR PHYSICS SUITE PROJECT (NEW DRAWING)

50
FAP 02-050 WIRING
FIRE ALARM SYSTEM

UNIVERSITY OF CALIFORNIA
LAWRENCE BERKELEY NATIONAL LABORATORY
FACILITIES DIVISION

DRAWN BY	DWH	DATE	12/22/09
CHECKED BY	BBT		12/22/09
APPROVED BY			
CAD FILE PATH	TBD		
SCALE	As Noted		
DRAWING NO.	4B50EXXX	SHEET	FA1.6.6-50
PROJECT NO.	TBD	OF	

UNIVERSITY OF CALIFORNIA
LAWRENCE BERKELEY NATIONAL LABORATORY
FACILITIES DIVISION
BERKELEY LAB

OWNER

160 Pine Street
San Francisco, CA 94111

Tel 415.781.9800
Fax 415.788.5216
www.rmw.com

CONSULTING FIRM

HYT Corporation
Fire Protection Engineers and Consultants
3498 Clayton Road - Suite 101 Concord, California 94519
Phone: (925) 681-2731 FAX: (925) 681-2733

CONSULTING A/E FIRM

REGISTERED PROFESSIONAL ENGINEER BRET B. TREDER No. 1165 Exp. 9/30/10 FIRE PROTECTION STATE OF CALIFORNIA

PROFESSIONAL SEAL (IF REVISION, APPLIES ONLY TO REVISED WORK)

BULLETIN #12
ADDENDUM #2
100% FINAL DESIGN
04/07/2010

ISSUE (PROGRESS, ESTIMATE, BID, CONSTRUCTION, CONFORMED, REVISION, AS-BUILT)

REVISION NUMBER	DRAWN BY	CHECKED BY	APPR'D BY	DATE	REMARKS
12	HYT	HYT		12/28/2009	BULLETIN #12
12 R2	HYT	HYT		04/07/2010	BULLETIN #12 - ADDENDUM #2

LBNL SEISMIC PHASE 1
BUILDING 50 - PHYSICS SUITE
FIRE ALARM DETAILS AND SCHEMATICS

UNIVERSITY OF CALIFORNIA
LAWRENCE BERKELEY NATIONAL LABORATORY
FACILITIES DIVISION

DRAWN BY	HYT	DATE	04/07/2010
CHECKED BY	HYT		
APPROVED BY			
CAD FILE PATH	00023155		
SCALE	AS NOTED		
DRAWING NO.	6N50E145	SHEET	FA1.6.3-50
PROJECT NO.	FN7200		