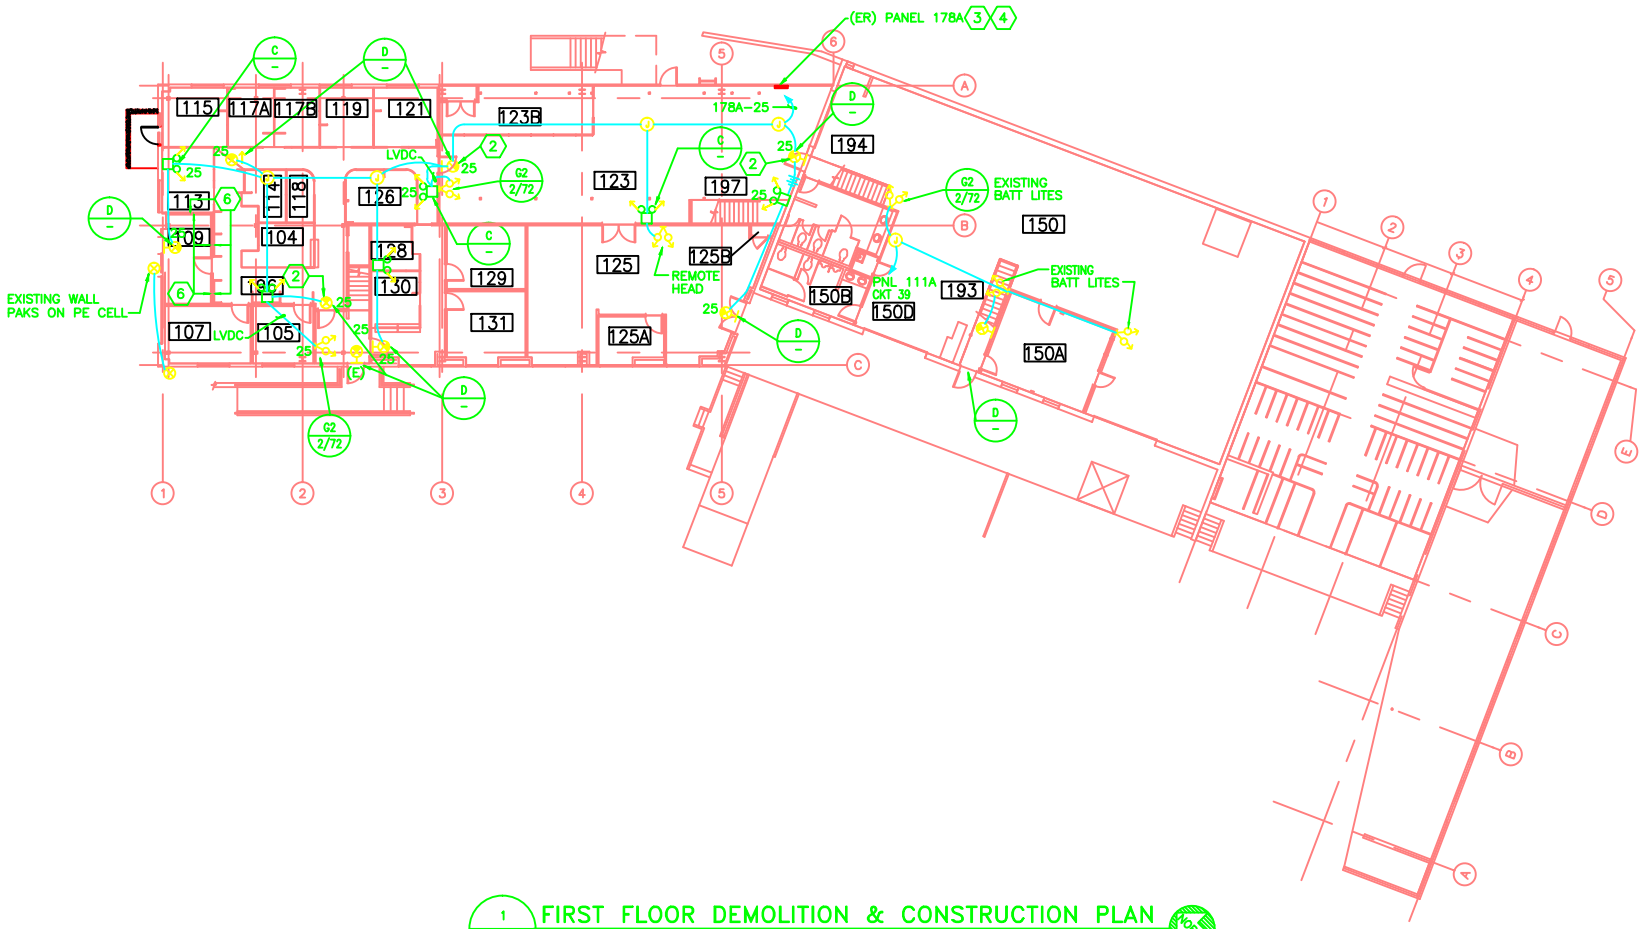

1 / 69-E2.1 FIRST FLOOR DEMOLITION & CONSTRUCTION PLAN

SCALE: 1/8"=1'-0"

DESIGN CRITERIA:

28. PROVIDE SECOND EXIT FOR THE OFFICE AREA ON THE FIRST FLOOR.
87. PROVIDE ADEQUATE EMERGENCY LIGHTING FOR THE EXIT WAYS.
88. PROVIDE ILLUMINATED EXIT SIGNA AS REQUIRED TO PROPERLY IDENTIFY EXIT PATH WAYS.

SHEET NOTES

1. NOT USED.
2. REMOVE AND REPLACE (E) EXIT LIGHT WITH NEW.
3. (E) PANEL 178A, 100A BUS, 208Y/120V, 3ø, 4W.
   ADDED LOADS: CKT. – 25 = ±182 WATTS.
   CKT. – 27 = ±98 WATTS.
   CKT. – 29 = ±150 WATTS.
4. INSTALL (N) 3–20A, 1 POLE BREAKER IN (E) SPACE CIRCUITS 25,27,29.
5. PHOTO ELECTRIC CELL ORIENTED TOWARD, NORTH MOUNTED ON ROOF. LOCATION TO BE VERIFIED IN THE FIELD. TORK MODEL 3000
6. INSTAL (N) 3–20A, 1 POLE BREAKER IN

ess ARCHITECTS
466 Eighth Street
San Francisco, CA 94103
415 252-9500
415 252-1585 Fax

CONSULTANT
MAZZETTI & ASSOCIATES, INC.
Consulting Mechanical & Electrical Engineers
1000 BRANNAN STREET – SAN FRANCISCO, CA 94103-4871
TELEPHONE (415) 864-3800 FAX (415) 864-0363
621-283

REVISIONS

no.	date	description
1		90% TITLE II 9/26/94
2		100% TITLE II 11/7/94
3		FINAL TITLE II 2/13/95
4		REISSUE FINAL TITLE II 3/30/95
5		AS BUILT 7/25/97

JOB TITLE

FIRE AND SAFETY SYSTEMS UPGRADE
PHASE I
LAWRENCE BERKELEY LABORATORY, UNIVERSITY OF CALIFORNIA
BERKELEY, CALIFORNIA

KEY PLAN

REGISTERED PROFESSIONAL ENGINEER WILLIAM F. MAZZETTI No. 13450 EXP. 9/30/96 ELECTRICAL STATE OF CALIFORNIA

ESS ARCHITECTS JOB #: 9292
LBL SC#: 728
LBL FILE DRAWING: *
ACAD FILE NAME:
LBNL DWG. 3N69E032E
PROJ # 120257

SHEET TITLE:
BUILDING 69
FIRST FLOOR
DEMO. & CONSTRUCTION PLAN

SCALE: AS NOTED
DATE: 2/13/95

SHEET: 69-E2.1E