SHEET NOTES

1. REMOVE AND REPLACE (E) EXIT LIGHT WITH NEW.

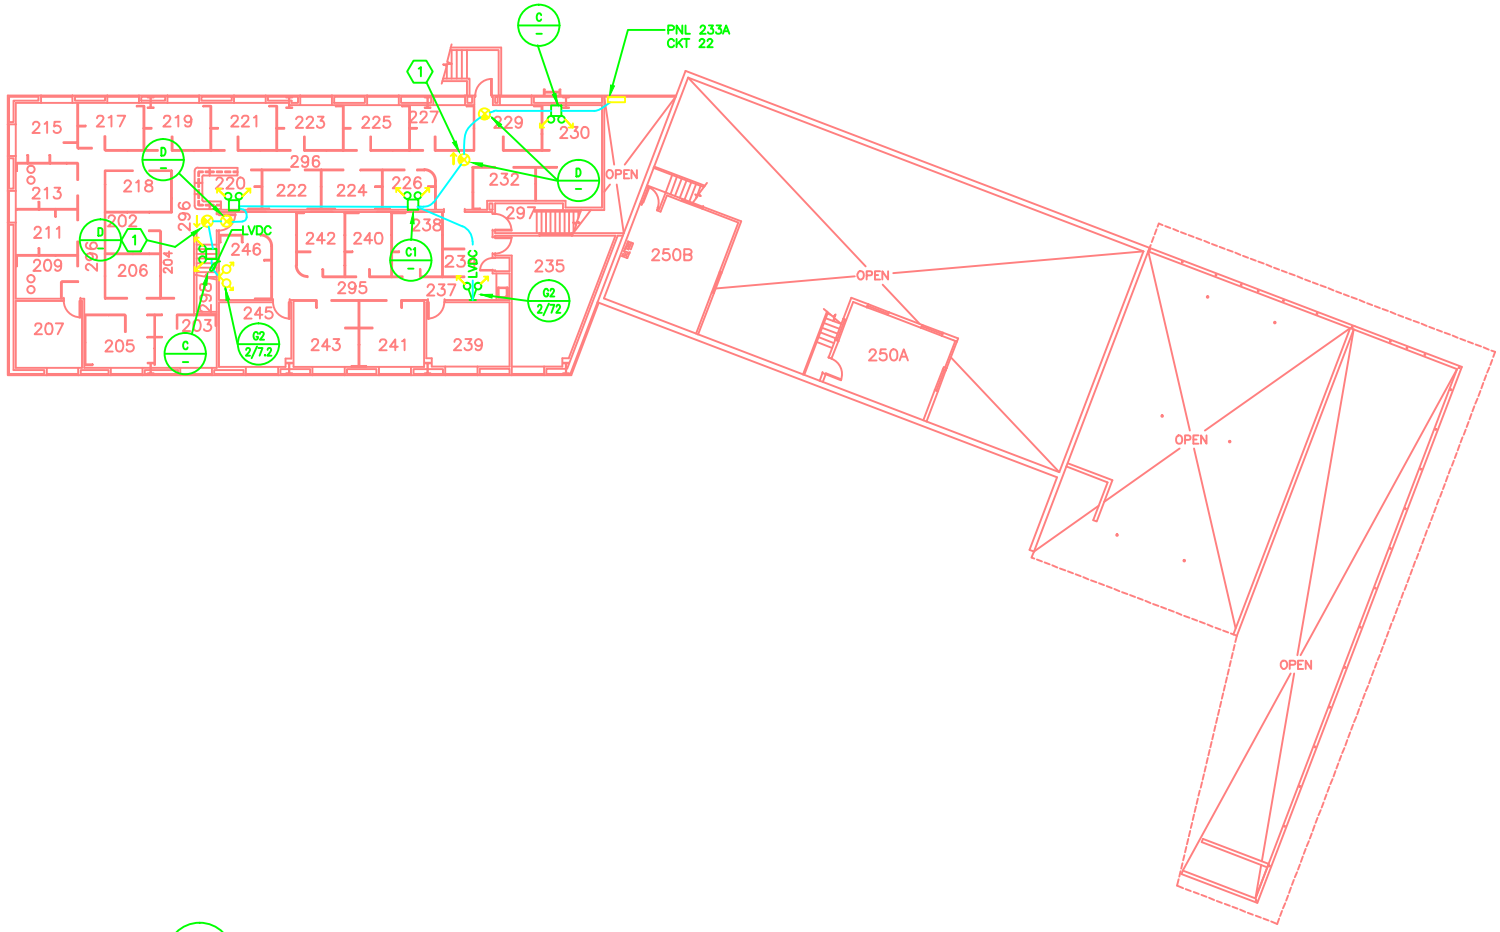

SECOND FLOOR DEMOLITION & CONSTRUCTION PLAN

1 / 69-E2.2

SCALE: 1/16"=1'-0"

NORTH

ess ARCHITECTS
466 Eighth Street
San Francisco, CA 94103
415 252-9200
415 252-1585 Fax

CONSULTANT

MAZZETTI & ASSOCIATES, INC.
Consulting Mechanical & Electrical Engineers
1000 BRANNAN STREET - SAN FRANCISCO, CA 94103-4871
TELEPHONE (415) 864-5800 FAX (415) 864-6363
621-283

REVISIONS

no.	date	description
1		90% TITLE II 9/26/94
2		100% TITLE II 11/7/94
3		FINAL TITLE II 2/13/95
4		AS BUILT 7/25/97

JOB TITLE

FIRE AND SAFETY SYSTEMS UPGRADE
PHASE I
LAWRENCE BERKELEY LABORATORY, UNIVERSITY OF CALIFORNIA
BERKELEY, CALIFORNIA

KEY PLAN

REGISTERED PROFESSIONAL ENGINEER
WILLIAM P. MAZZETTI JR.
No. 13450
EXP. 9/30/00
ELECTRICAL
STATE OF CALIFORNIA

ESS ARCHITECTS JOB #: 9292
LBL SC#: 728
LBL FILE DRAWING:
ACAD FILE NAME:
LBNL DWG. 3N69E033D
PROJ # 120257

SHEET TITLE:
BLDG. 69
SECOND FLOOR PLAN
DEMO. & CONSTRUCTION PLAN

SCALE: 1/16"=1'-0" DATE: 2/13/95

SHEET: 69-E2.2D