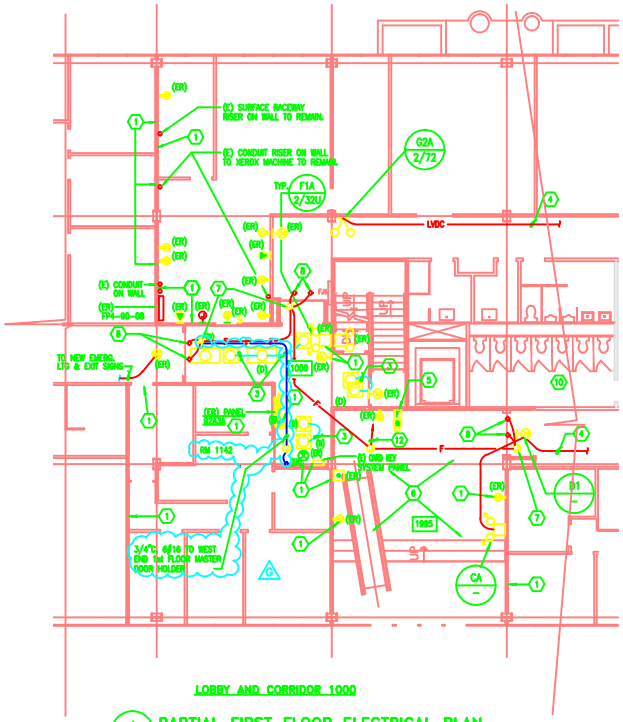

LOBBY AND CORRIDOR 1000

1 / 90-E2.2 PARTIAL FIRST FLOOR ELECTRICAL PLAN
SCALE: 1/8" = 1'-0"

SHEET NOTES

1. REMOVE (E) ELECTRICAL EQUIPMENT AND DEVICES. RE-INSTALL AFTER NEW 2-HOUR WALL CONSTRUCTION. PROVIDE THROUGH PENETRATION PROTECTION CEILING SYSTEM FOR (C) CONDUITS AND 2-HOUR ENCLOSURE FOR (E) EQUIPMENT AND DEVICES. SEE 2/90-E0.1 3/90-E0.1
2. NOT USED
3. EXTEND EXISTING CIRCUIT TO NEW FIXTURES AND CONNECT COMPLETE.
4. NOT USED
5. (E) MANUAL PULL STATION, FCB-003-90, ZONE 1H18.
6. REMOVE (E) LIGHT FIXTURES. RE-INSTALL AFTER CEILING WORK. FOR (E) LIGHT FIXTURE LAYOUT ARRANGEMENT REFER TO SHEET 90-A2.3.
7. PROVIDE 4" SQUARE BOX ABOVE CEILING SPACE AND CONDUIT/WIRING TO THE DOOR TRACK BUILT-IN SMOKE DETECTOR. SEE DETAIL 4/90-E0.2
8. POWER CONNECTION TO DOOR HOLDER SOLENOID INSIDE THE DOOR TRACK ASSEMBLY. SEE DETAIL 4/90-E0.2
9. NOT USED
10. NOT USED
11. NOT USED
12. RUN FA CIRCUITS TO TERMINAL CANIM 2ND FLOOR STAIRWAY REFER TO DWG. 4B90104, REV A FOR DETAILED CONNECTION DIAGRAM. CONNECT 1ST FLOOR SMOKE DETECTORS WITH DOOR CLOSER/HOLDER TO ZONE 1H41. SEE DWG 4B90E101, REV A FOR ZONE ALLOCATION.

ARCHITECTS

CONSULTANT
MAZZETTI & ASSOCIATES, INC.
Consulting Mechanical & Electrical Engineers
1960 ADDISON STREET • SAN FRANCISCO, CA 94520-4371
TELEPHONE (415) 549-0500 FAX (415) 549-0503
03-06

REVISIONS

no.	date	description
1		60% TITLE # 9/28/94
2		100% TITLE # 11/7/94
3		FINAL TITLE # 2/13/95
4		REVISED FINAL TITLE # 3/20/95
5		REVISED FINAL TITLE # 3/20/95
6		ADDED DOOR HOLDER TO RM 1142
7		AS BUILT 7/20/97

JOB TITLE

FIRE AND SAFETY SYSTEMS UPGRADE
PHASE I
LAWRENCE BERKELEY LABORATORY, UNIVERSITY OF CALIFORNIA
BERKELEY, CALIFORNIA

KEY PLAN

REGISTERED PROFESSIONAL ENGINEER
No. 12489
Exp. 6/30/95
ELECTRICAL
STATE OF CALIFORNIA

ESS ARCHITECTS JOB #: 9202
LBL SQ.ft: 726
LBL FILE DRAWING: *
ACAD FILE NAME:
LBNL DWG. 3N90E125G
PROJ # 120257

SHEET TITLE
BUILDING 90
PARTIAL FIRST FLOOR
ELECTRICAL PLAN

SCALE: AS NOTED
DATE: 2/13/94

SHEET
90-E2.2F