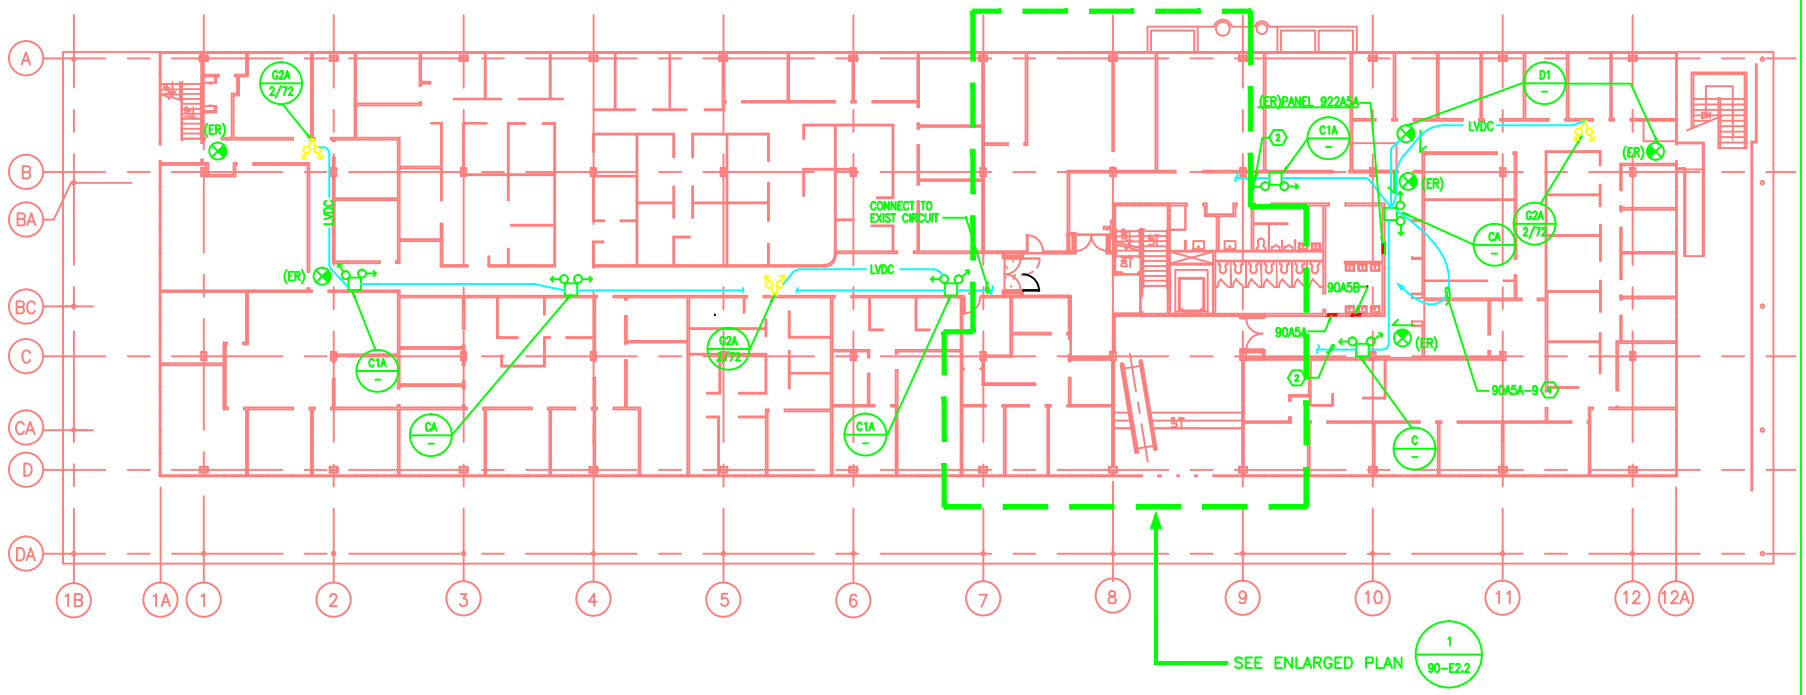

1 / 90-E2.3 FIRST FLOOR DEMOLITION AND CONSTRUCTION KEY PLAN

SCALE: 1/32" = 1'-0"

SHEET NOTES

1. REMOVE (E) ELECTRICAL EQUIPMENT AND DEVICES. RE-INSTALL AFTER NEW 2-HOUR WALL CONSTRUCTION. PROVIDE THROUGH PENETRATION PROTECTION CEILING SYSTEM FOR (E) CONDUITS AND 2-HOUR ENCLOSURE FOR (E) EQUIPMENT AND DEVICES.
2. NOT USED
3. NOT USED
4. (E) PANEL 90A5A: 225A BUS, 480/277V, 3ø, 4W.
   ADDED LOAD: CIRCUIT 9 = 485 WATTS

ess ARCHITECTS
466 Eighth Street
San Francisco, CA 94103
415 252-9200
415 252-1585 Fax

CONSULTANT

MAZZETTI & ASSOCIATES, INC.
Consulting Mechanical & Electrical Engineers
1000 BRANNAN STREET – SAN FRANCISCO, CA 94103-4871
TELEPHONE (415) 864-5800 FAX (415) 864-5363
621-283

REVISIONS

no.	date	description
1		90% TITLE II 9/28/94
2		100% TITLE II 11/7/94
3		FINAL TITLE II 2/13/95
4		REISSUE FINAL TITLE II 3/30/95
5		DELETED NOTE 2 & 12W PWR SUPPLY TO DOOR HOLDERS REV'D LTG PWR BY LBNL
6		AS BUILT 7/25/97

JOB TITLE

FIRE AND SAFETY SYSTEMS UPGRADE
PHASE I
LAWRENCE BERKELEY LABORATORY, UNIVERSITY OF CALIFORNIA
BERKELEY, CALIFORNIA

KEY PLAN

REGISTERED PROFESSIONAL ENGINEER
WILLIAM F. MAZZETTI JR.
No. 13450
EXP. 9/30/98
ELECTRICAL
STATE OF CALIFORNIA

ESS ARCHITECTS JOB #: 9292
LBL SC#: 728
LBL FILE DRAWING: *
ACAD FILE NAME:
LBNL DWG. 3N90E126F
PROJ # 120257

SHEET TITLE:
BUILDING 90
FIRST FLOOR
DEMO & CONSTRUCTION PLAN

SCALE: AS NOTED
DATE: 2/13/95

SHEET: 90-E2.3F