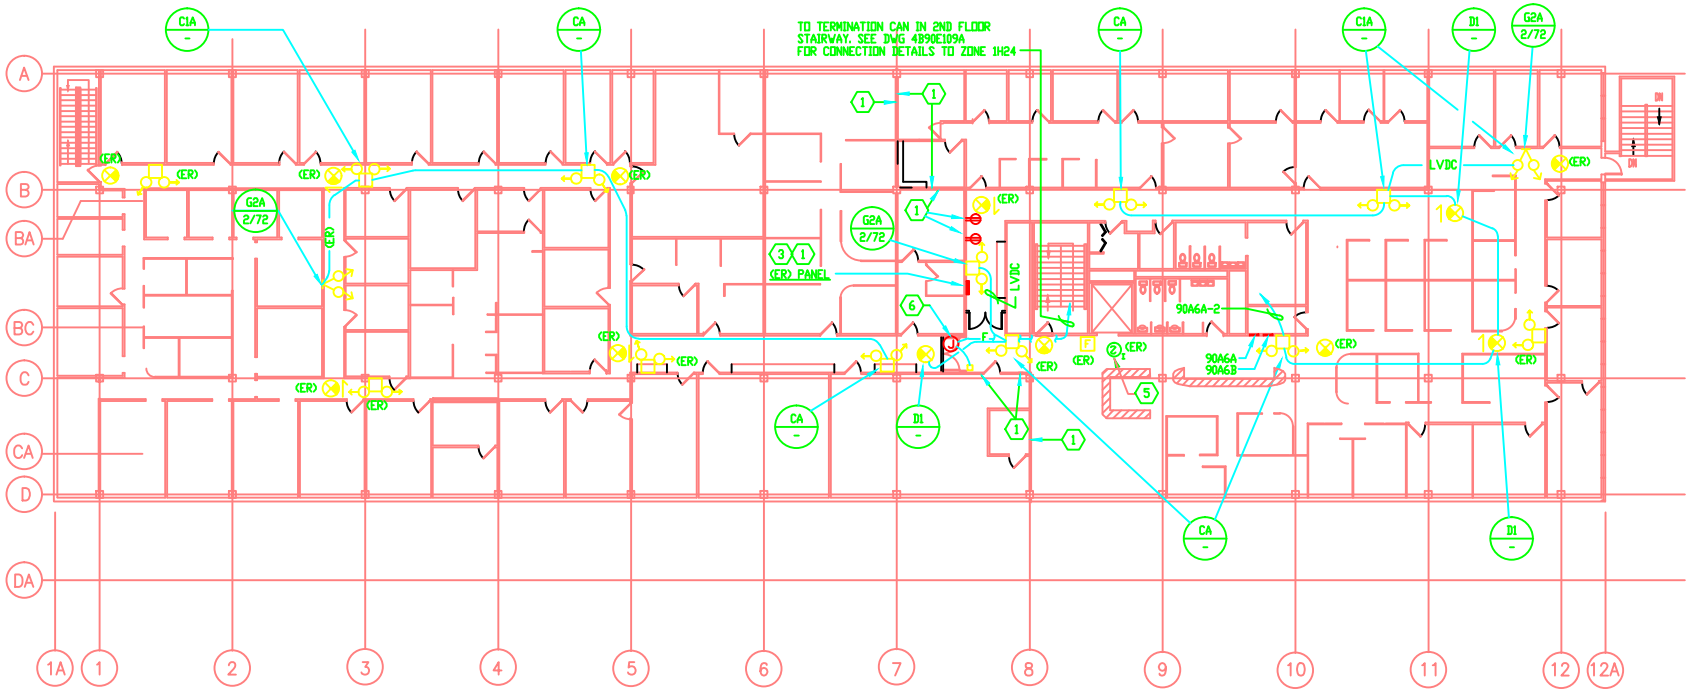


4
00-E0.1

## 1 / 90-E2.5 THIRD FLOOR DEMOLITION AND CONSTRUCTION KEY PLAN

SCALE: 1/16" = 1'-0"

5. (E) SMOKE SMOKE DETECTOR, SD-00-090, ZONE 1H26.

6. PROVIDE 4" SQUARE BOX ABOVE CEILING SPACE AND CONDUIT/WIRING TO THE DOOR TRACK BUILT-IN SMOKE DETECTOR. SIMILAR TO DETAIL 2 / 90-E2.2.

7. NOT USED

8. NOT USED

### SHEET NOTES

1. REMOVE (E) ELECTRICAL EQUIPMENT AND DEVICES. RE-INSTALL AFTER NEW 2-HOUR WALL CONSTRUCTION. PROVIDE THROUGH PENETRATION PROTECTION SYSTEM FOR (E) CONDUITS AND 2-HOUR ENCLOSURE FOR (E) EQUIPMENT AND DEVICES.

2. NOT USED

3. PROVIDE 2-HOUR ENCLOSURES FOR (E) PANEL. SEE 4 / 00-E0.1

4. PROVIDE A REVISED, TYPED PANELBOARD SCHEDULE.


ess ARCHITECTS
466 Eighth Street
San Francisco, CA 94103
415 252-9500
415 252-1585 Fax


CONSULTANT
MAZZETTI & ASSOCIATES, INC.
Consulting Mechanical & Electrical Engineers
1000 BRANNAN STREET – SAN FRANCISCO, CA 94103-4671
TELEPHONE (415) 864-5800 FAX (415) 864-5363
# 621-283

REVISIONS

| no. | date | description |
|---|---|---|
| 1 | | 90% TITLE II 9/26/94 |
| 2 | | 100% TITLE II 11/7/94 |
| 3 | | FINAL TITLE II 2/13/95 |
| 4 | | REISSUE FINAL TITLE II 3/30/95 |
| 5 | | REVISED NOTES AND DOOR HOLDER LAYOUT BY LBNL 9/19/96 |
| 6 | | AS BUILT 7/25/97 |

JOB TITLE

# FIRE AND SAFETY SYSTEMS UPGRADE
# PHASE I
# LAWRENCE BERKELEY LABORATORY, UNIVERSITY OF CALIFORNIA
# BERKELEY, CALIFORNIA

KEY PLAN

REGISTERED PROFESSIONAL ENGINEER
WILLIAM R. MAZZETTI
No. 13450
EXP. 9/30/98
ELECTRICAL
STATE OF CALIFORNIA

ESS ARCHITECTS JOB #: 9292
LBL SC#: 728
LBL FILE DRAWING: *
ACAD FILE NAME:
LBNL DWG. 3N90E128F
PROJ # 120257

SHEET TITLE:
BUILDING 90
THIRD FLOOR
DEMO. & CONSTURCTION PLAN

SCALE: AS NOTED
DATE: 2/13/95

SHEET:
90-E2.5F