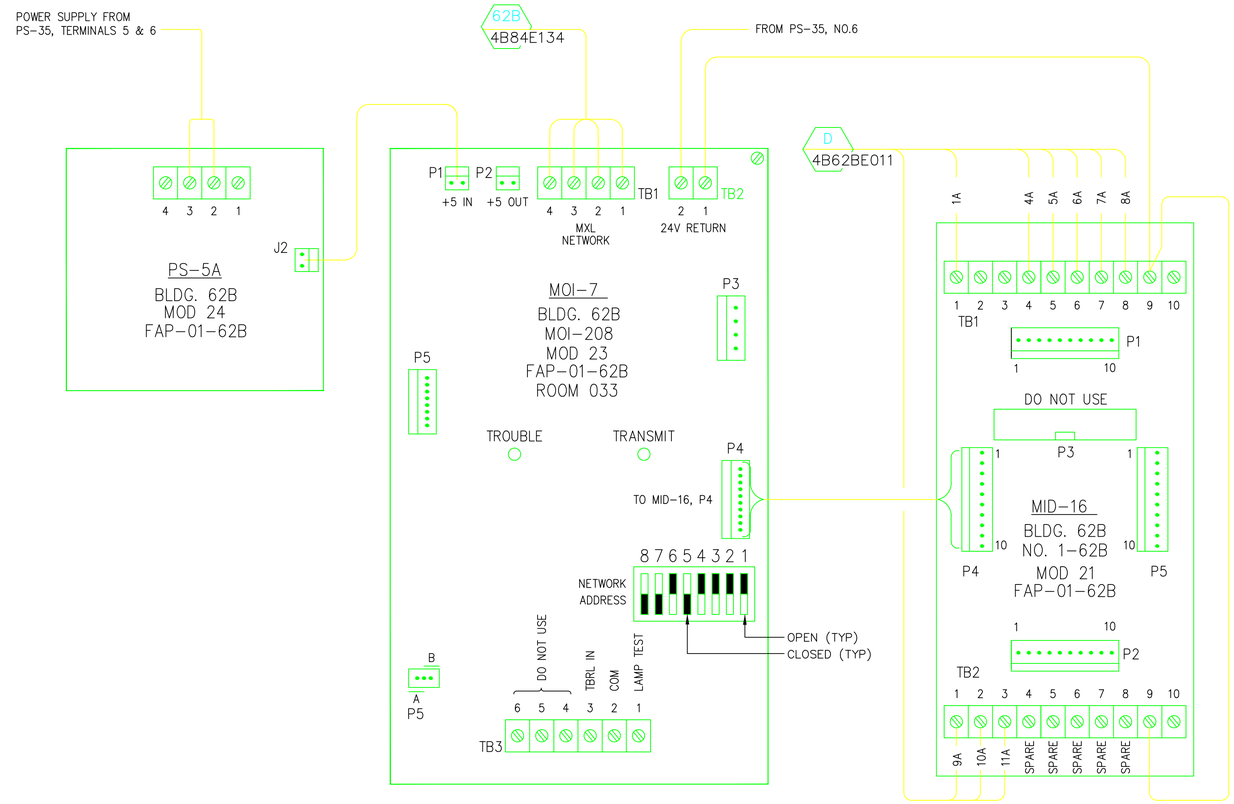

OLD ADDRESS	DESCRIPTION	MID-16 TERMINATION	MODULE TYPE & NO.	MXL NO. 6 AT B. 84 ADDRESS
2E33	MX-316 AC POWER FAIL	N/A	N/A	N/A
2E34	MX-316 PANEL TROUBLE	N/A	N/A	N/A
2E35	MX-316 GROUND FAULT	N/A	N/A	N/A
2E36	MX-316 BATTERY FAILURE	N/A	N/A	N/A
2E37	RISER VALVE SUPERVISION	TB. 1 NO. 1	MID-16 NO. 1-62B	6-208-01
2E38	NOT USED	N/A	N/A	N/A
2E39	NOT USED	N/A	N/A	N/A
2E40	NOT USED	N/A	N/A	N/A
2E41	WATER FLOW, B. SPRINKLERS	TB. 1 NO. 4	MID-16 NO. 1-62B	6-208-04
2E42	FCB, OUTSIDE ENTRANCE	TB. 1 NO. 5	MID-16 NO. 1-62B	6-208-05
2E43	HEAT DETECTOR	TB. 1 NO. 6	MID-16 NO. 1-62B	6-208-06
2E44	SYSTEM 3 COMMON TROUBLE	TB. 1 NO. 7	MID-16 NO. 1-62B	6-208-07
2E45	HALON FIRST ALARM	TB. 1 NO. 8	MID-16 NO. 1-62B	6-208-08
2E46	HALON SECOND ALARM	TB. 2 NO. 1	MID-16 NO. 1-62B	6-208-09
2E47	HALON DISCHARGE	TB. 2 NO. 2	MID-16 NO. 1-62B	6-208-10
2E48	HALON TROUBLE	TB. 2 NO. 3	MID-16 NO. 1-62B	6-208-11

AS BUILT

C
5/28/2013

REVISION NUMBER	DRAWN BY	CHECKED BY	APPR'D BY	DATE	REMARKS
C	LDD	LDD	MCD	05/28/13	AS BUILT PER FIELD VERIFICATIONS
B	AD	LDD	MCD	10/03/07	FIRE ALARM SYSTEM UPGRADE
A	AD	LDD	MCD	6/06/06	REVISED FOR MXL COPPER LOOP

PROFESSIONAL SEAL (IF REVISION, APPLIES ONLY TO REVISED WORK)

ISSUE (PROGRESS, ESTIMATE, BID, CONSTRUCTION, CONFORMED, REVISION, RECORD)

62B FIRE ALARM SYSTEM
SYSTEM 3 PANEL WIRING AND
MID/MOI MODULE ARRANGEMENT

UNIVERSITY OF CALIFORNIA
LAWRENCE BERKELEY NATIONAL LABORATORY
FACILITIES DIVISION

DRAWN BY	AD	DATE 5/24/2005
CHECKED BY	MCG	5/24/2005
APPROVED BY	MCG	5/24/2005
CAD FILE PATH		
SCALE	Full	
DRAWING NO.	4B62BE009C	SHEET
PROJECT NO.	WN1787	1 OF 1