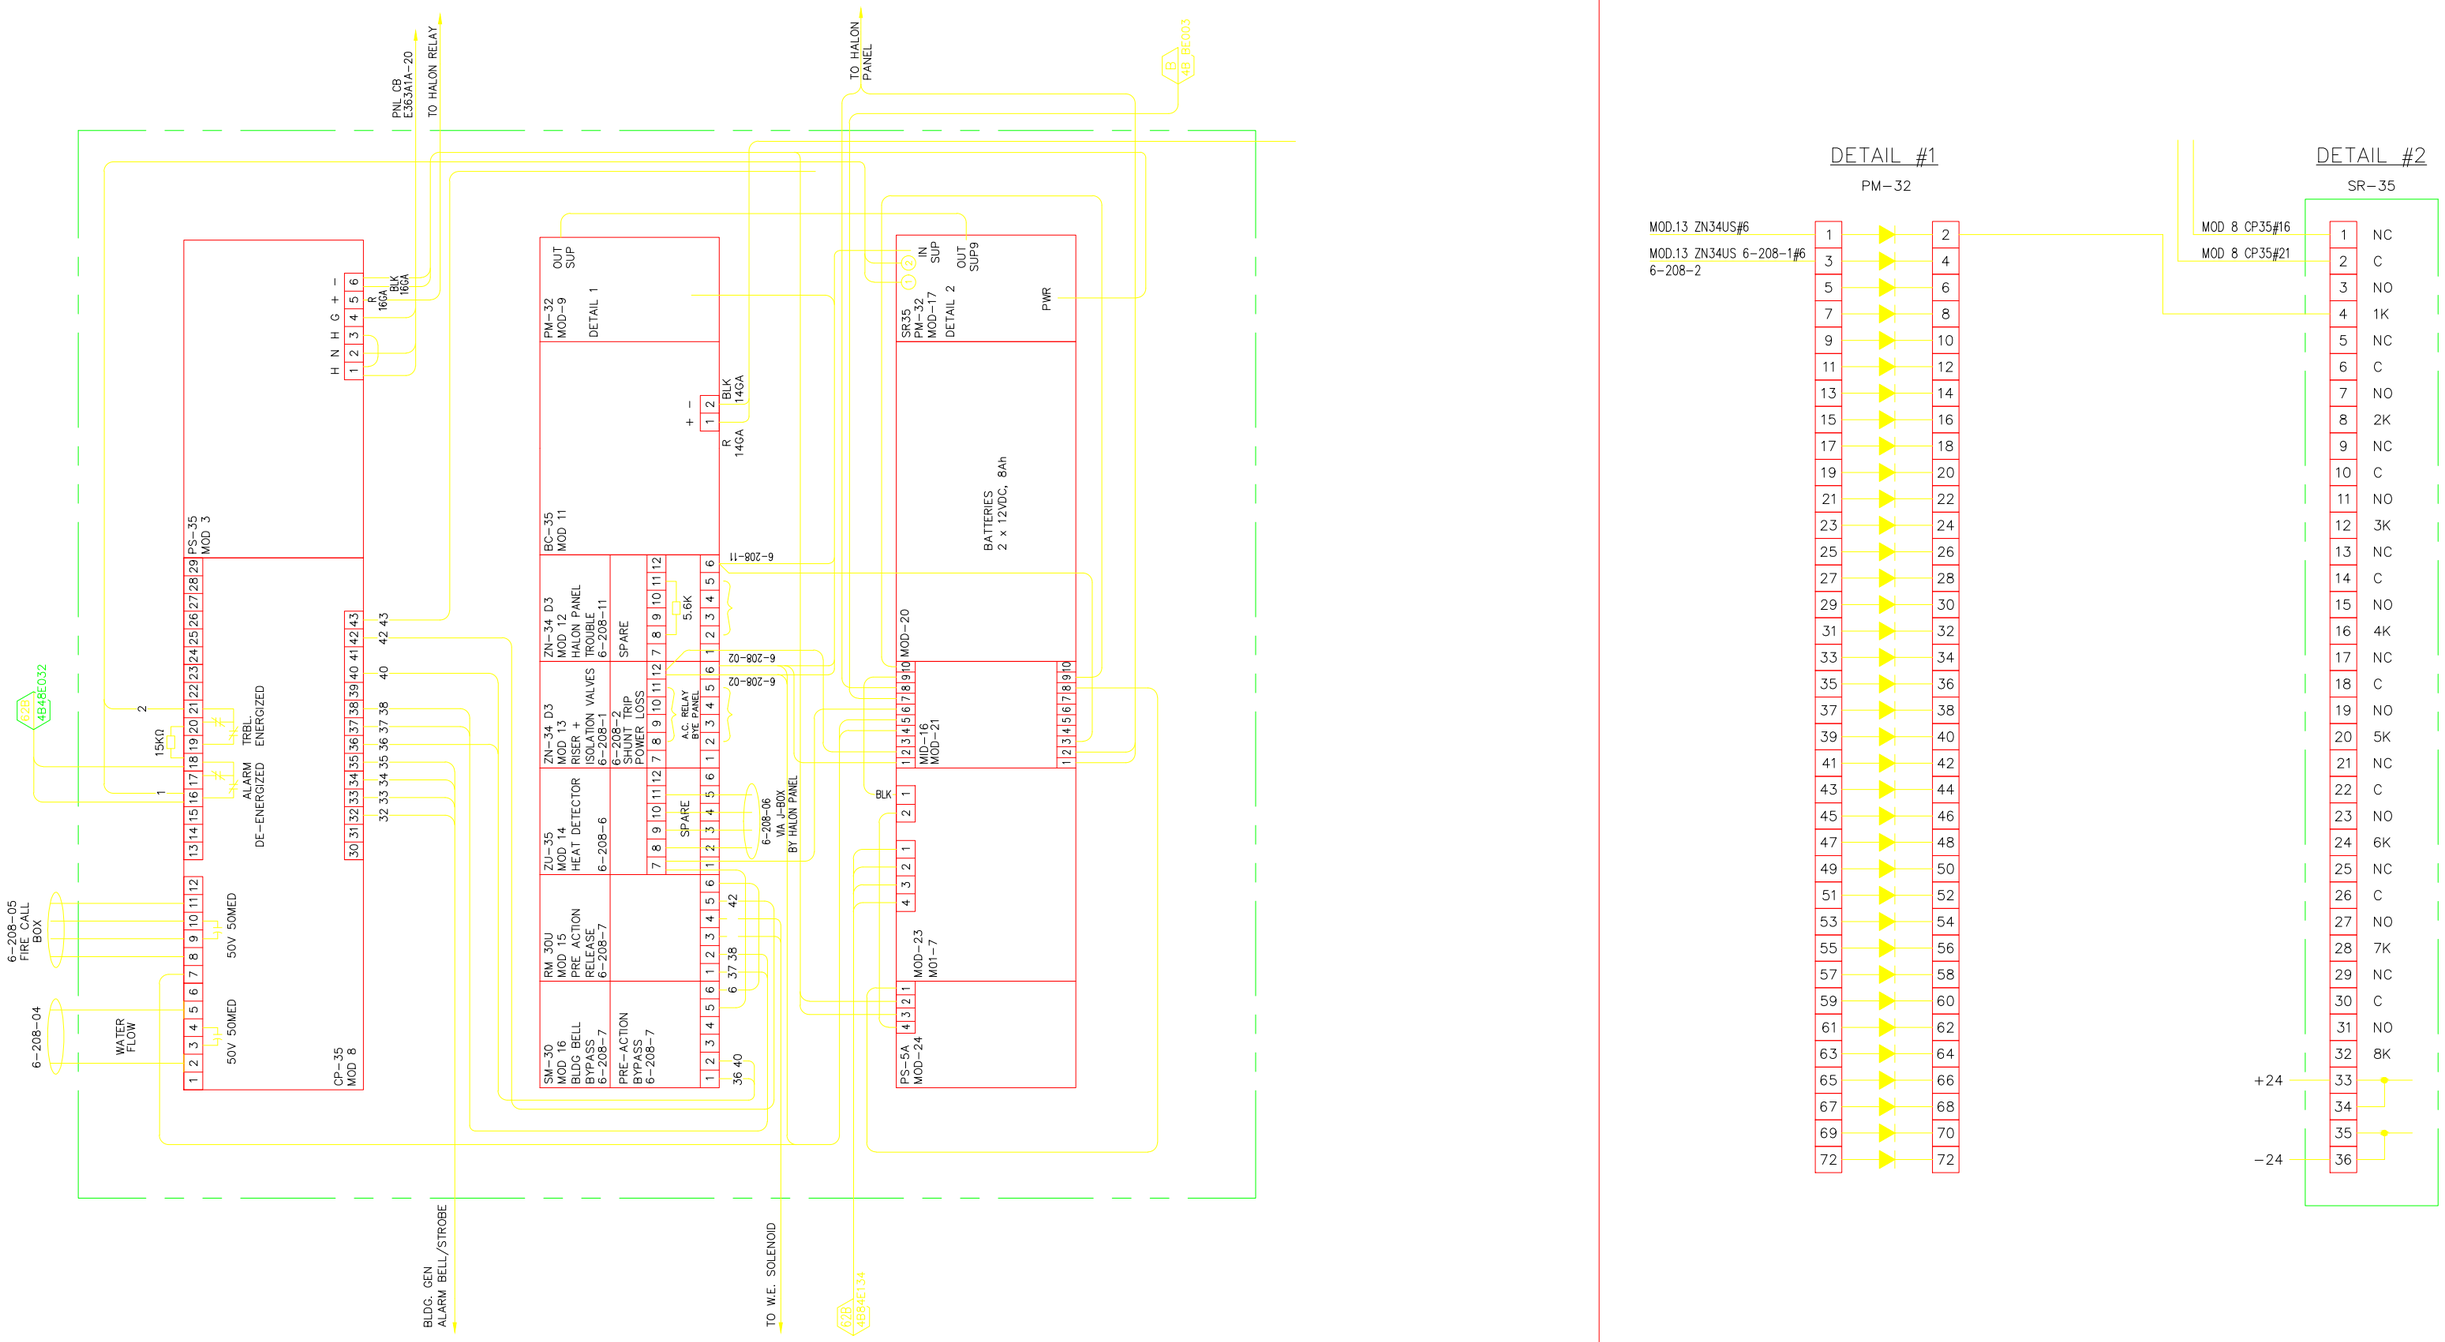

DETAIL #1

PM-32

MOD.13 ZN34US#6

MOD.13 ZN34US 6-208-1#6
6-208-2

1	2
3	4
5	6
7	8
9	10
11	12
13	14
15	16
17	18
19	20
21	22
23	24
25	26
27	28
29	30
31	32
33	34
35	36
37	38
39	40
41	42
43	44
45	46
47	48
49	50
51	52
53	54
55	56
57	58
59	60
61	62
63	64
65	66
67	68
69	70
72	72

DETAIL #2

SR-35

MOD 8 CP35#16

MOD 8 CP35#21

	1	NC
	2	C
	3	NO
	4	1K
	5	NC
	6	C
	7	NO
	8	2K
	9	NC
	10	C
	11	NO
	12	3K
	13	NC
	14	C
	15	NO
	16	4K
	17	NC
	18	C
	19	NO
	20	5K
	21	NC
	22	C
	23	NO
	24	6K
	25	NC
	26	C
	27	NO
	28	7K
	29	NC
	30	C
	31	NO
	32	8K
+24	33	
	34	
	35	
−24	36	

REVISION NUMBER	DRAWN BY	CHECKED BY	APPR'D BY	DATE	REMARKS
D	LDD	LDD	MCD	05/28/13	AS BUILT PER FIELD VERIFICATIONS
C				9/3/10	AS BUILT
B				12/01/09	AS BUILT
A				9/30/08	AS BUILT

PROFESSIONAL SEAL (IF REVISION, APPLIES ONLY TO REVISED WORK)

ISSUE (PROGRESS, ESTIMATE, BID, CONSTRUCTION, CONFORMED, REVISION, RECORD)

AS BUILT
D
5/28/2013

62B FIRE ALARM
SYS 3 PANEL FAP-01-62B
INTERCONNECTION DIAGRAM

UNIVERSITY OF CALIFORNIA
LAWRENCE BERKELEY NATIONAL LABORATORY
FACILITIES DIVISION

DRAWN BY	AD	DATE 9/30/20C
CHECKED BY	MCG	9/30/20C
APPROVED BY	MCG	9/30/20C
CAD FILE PATH		
SCALE	AS NOTED	
DRAWING NO.	4B62BE011D	SHEET FA
PROJECT NO.		