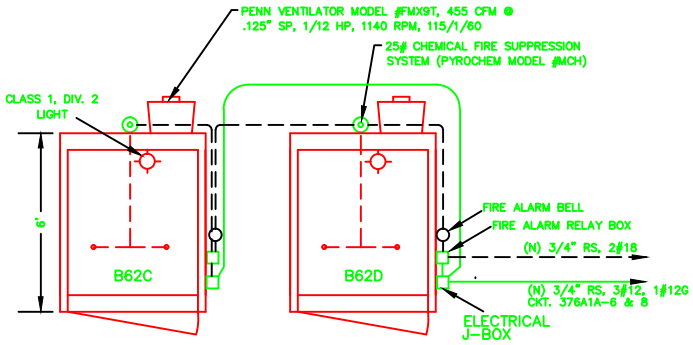

CONTAINER TOP VIEW

SCALE: 1/2" = 1' - 0"

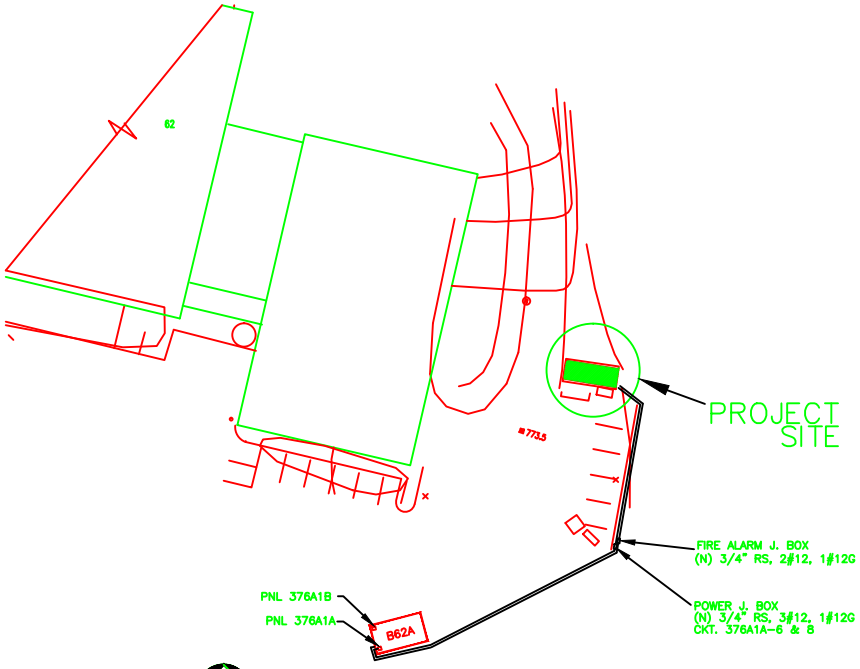

LOCATION PLAN

SCALE: 1" = 10'-0"

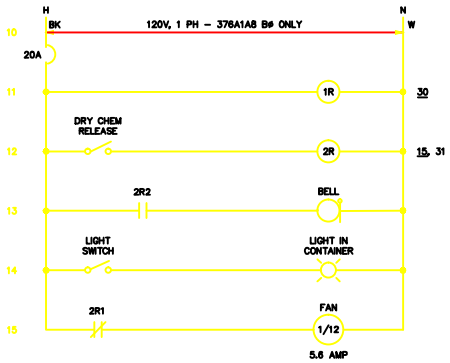

CHEM-STORAGE UNIT B62C

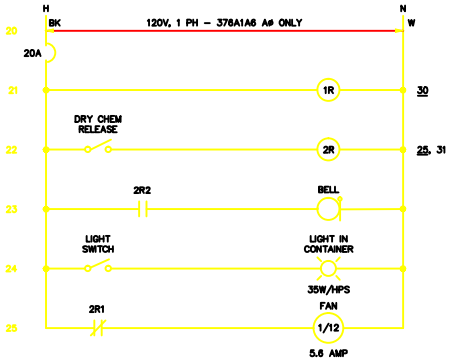

CHEM-STORAGE UNIT B62D

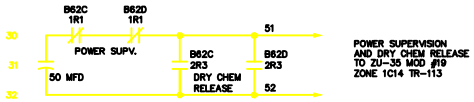

FIRE ALARM CONNECTIONS

NOTES:

1. INSTALL A WEATHERPROOF FIRE ALARM RELAY BOX AND A 120 VAC BELL ON EACH CONTAINER AND WIRE PER DETAIL.
2. PROVIDE A 3/4" RSC TO THE FIRE ALARM PANEL IN BUILDING 62.
3. PROVIDE A 3/4" RSC FROM PANEL 376A1A-9 FOR POWER. REMOVE ONE 20A BREAKER FROM EACH CONTAINER AND WIRE PER DETAIL.
4. CADWELD A GROUND PAD TO EACH CONTAINER AND RECONNECT GROUND ROD.
5. REFERENCE FIRE ALARM DRAWINGS 4B62E011C & 4B62E009C.

REVISION NUMBER	DRAWN BY	CHECKED BY	APPR'D BY	DATE	REMARKS
B	RB	ROB	MCG	2/8/94	AS-BUILT
A	RB	BHS	BHS	10/20/93	ADD CKTS 10 THRU 32 & NOTES

62
WASTE ACCUMULATION CONTAINER
ELECTRICAL POWER PLAN

UNIVERSITY OF CALIFORNIA
LAWRENCE BERKELEY NATIONAL LABORATORY
FACILITIES DEPARTMENT

DRAWN BY	SC	06/28/93
CHECKED BY	PC	06/28/93
APPROVED BY	RG	06/28/93
CAD FILE PATH	00007607	
SCALE	As Noted	
DRAWING NO.	4B62E023B	
PROJECT NO.	120198	
SHEET	1 OF 1	