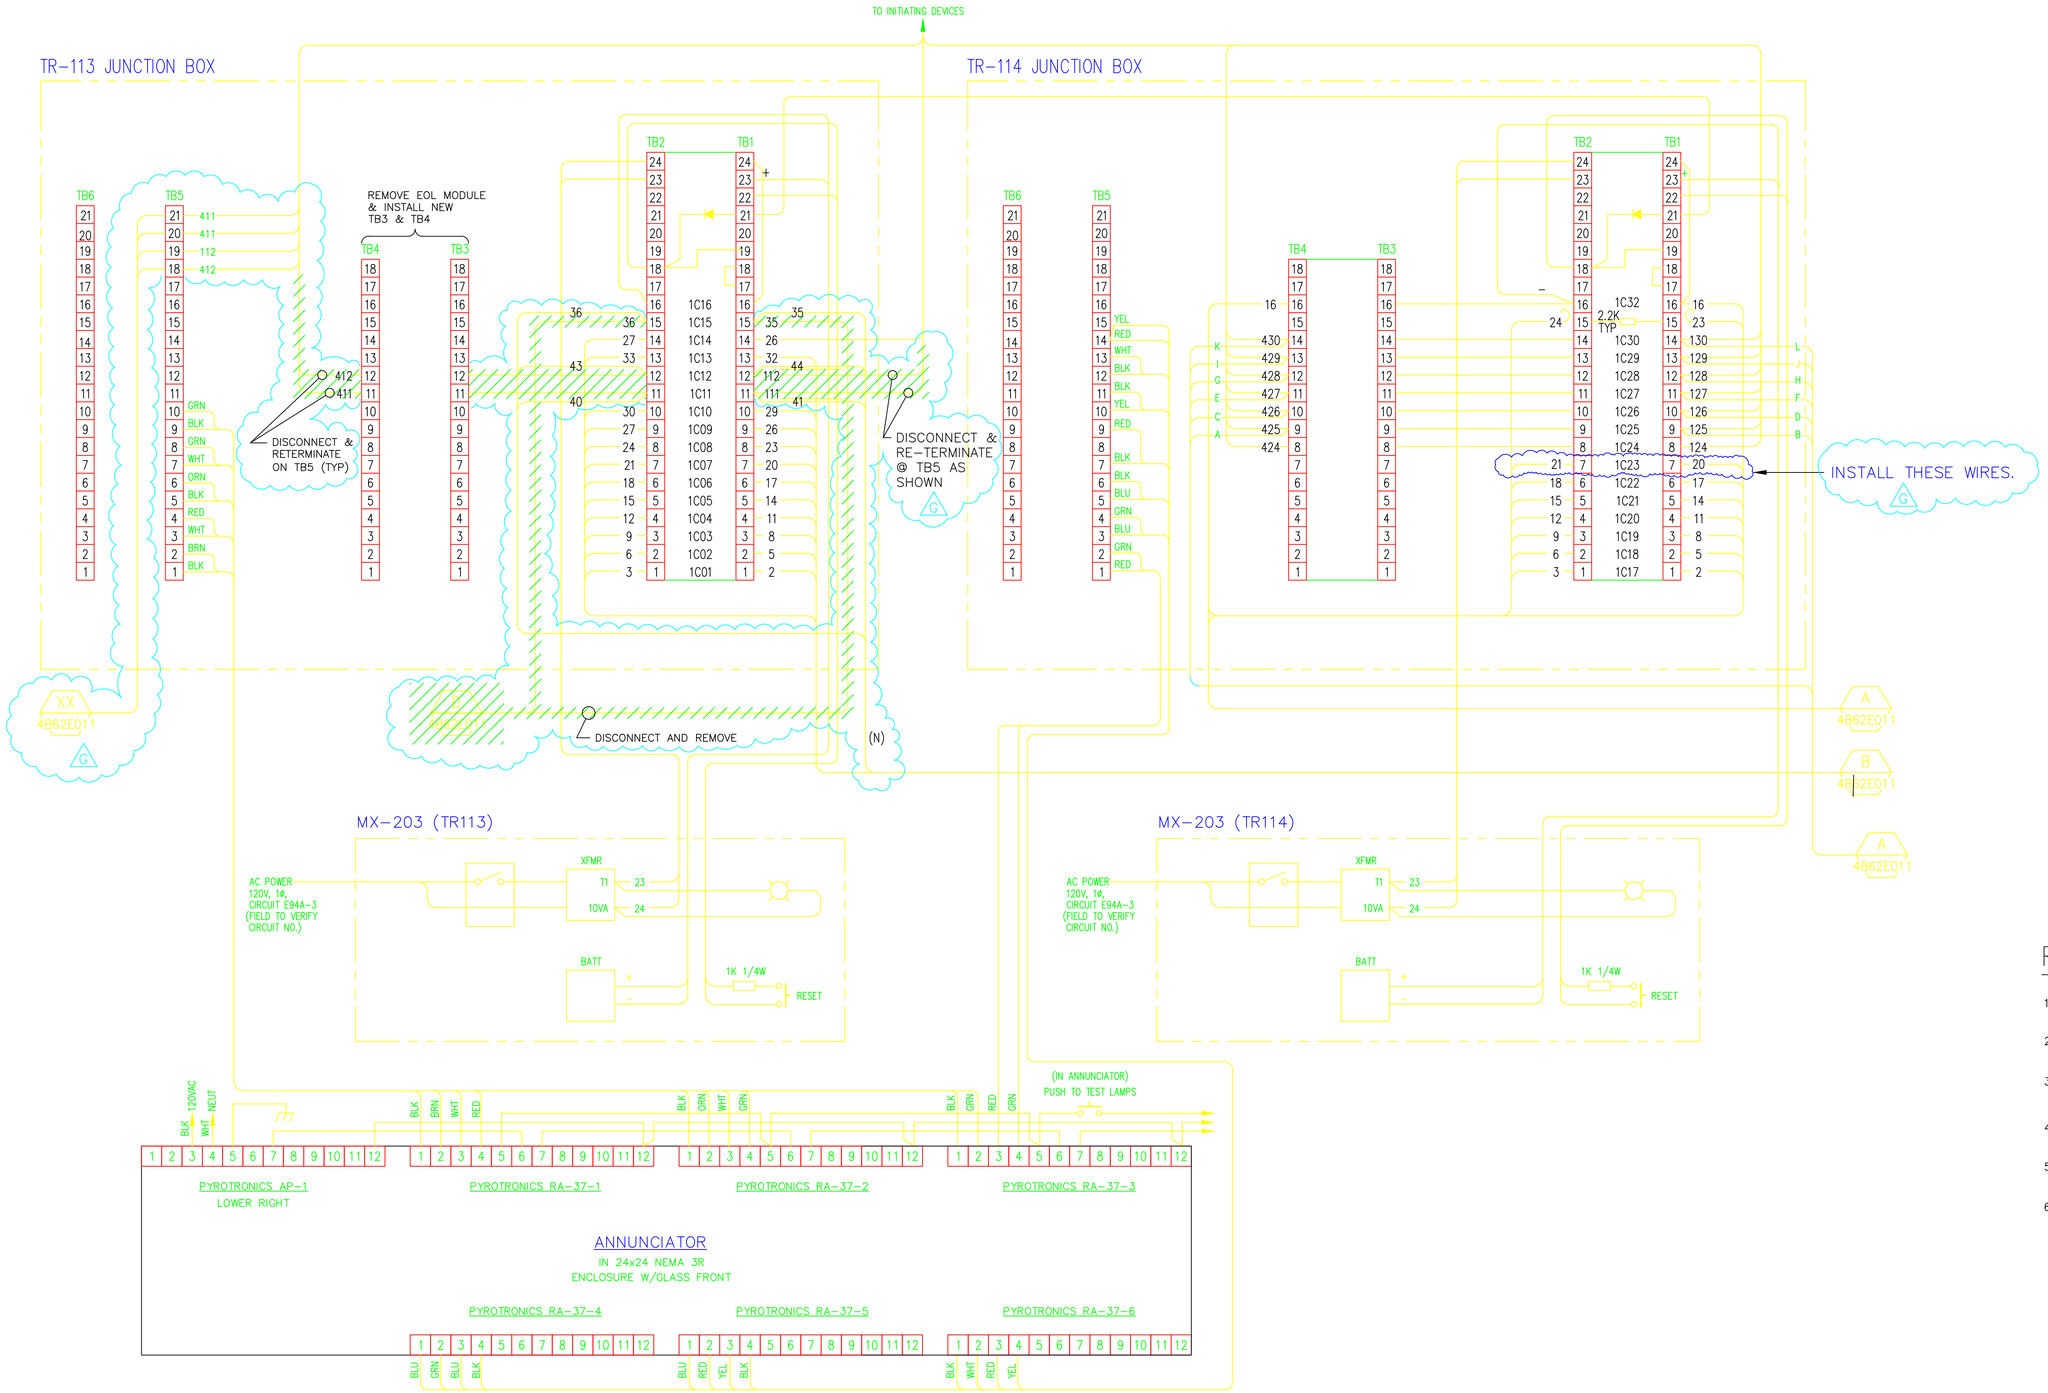

REFERENCE DRAWINGS:

1. 4B62E011 BLDG 62 FIRE ALARM SYSTEM SYS 3 WIRING DIAGRAM
2. 4B62E057 BLDG 62 FIRE ALARM SYSTEM LOGIC DIAGRAM
3. 4B62E058 BLDG 62 FIRE ALARM SYSTEM 1ST FLOOR & 62A INIT / ALARM DEVICES
4. 4B62E059 BLDG 62 FIRE ALARM SYSTEM 2ND FLOOR INIT / ALARM DEVICES
5. 4B62E060 BLDG 62 FIRE ALARM SYSTEM 3RD FLOOR INIT / ALARM DEVICES
6. 4B62E061 BLDG 62 FIRE ALARM SYSTEM ELEV & MISC INIT / ALARM DEVICES

DISTRIBUTION LIST:

2-ELECTRIC SHOP B76 (FILE I & II)
1-B90J (FILE III)
1-STICK FILE B90J
ORIGINAL-FLAT FILE B90F

TITLE 2
REVISION
G
4/15/2005

REVISION NUMBER	DRAWN BY	CHECKED BY	APPR'D BY	DATE	REMARKS
G	RZT	MCG	MCG	4/15/05	REVISED FOR DIGITIZE SYSTEM.
F	AD	AD	MCG	11/14/03	AS-BUILT, PHASE II FA UPGRADE
E	HYT	HYT	–	4/8/02	REPLACEMENT FIRE ALARM PROJECT
D	AD	MCG	MCG	4/2/02	AS BUILT RECORD DRAWING

PROFESSIONAL SEAL (IF REVISION, APPLIES ONLY TO REVISED WORK)
ISSUE (PROGRESS, ESTIMATE, BID, CONSTRUCTION, CONFORMED, REVISION, RECORD)

62 FIRE ALARM SYSTEM
TX 113, 114
ZONE WIRING DIAGRAM

UNIVERSITY OF CALIFORNIA
LAWRENCE BERKELEY NATIONAL LABORATORY
FACILITIES DIVISION

DRAWN BY RG	DATE 2/4/1988	
CHECKED BY		
APPROVED BY BS	2/10/1988	
CAD FILE PATH 00019271		
SCALE As Noted		
DRAWING NO. 4B62E024G	SHEET 1 OF 1	
PROJECT NO. 308021		