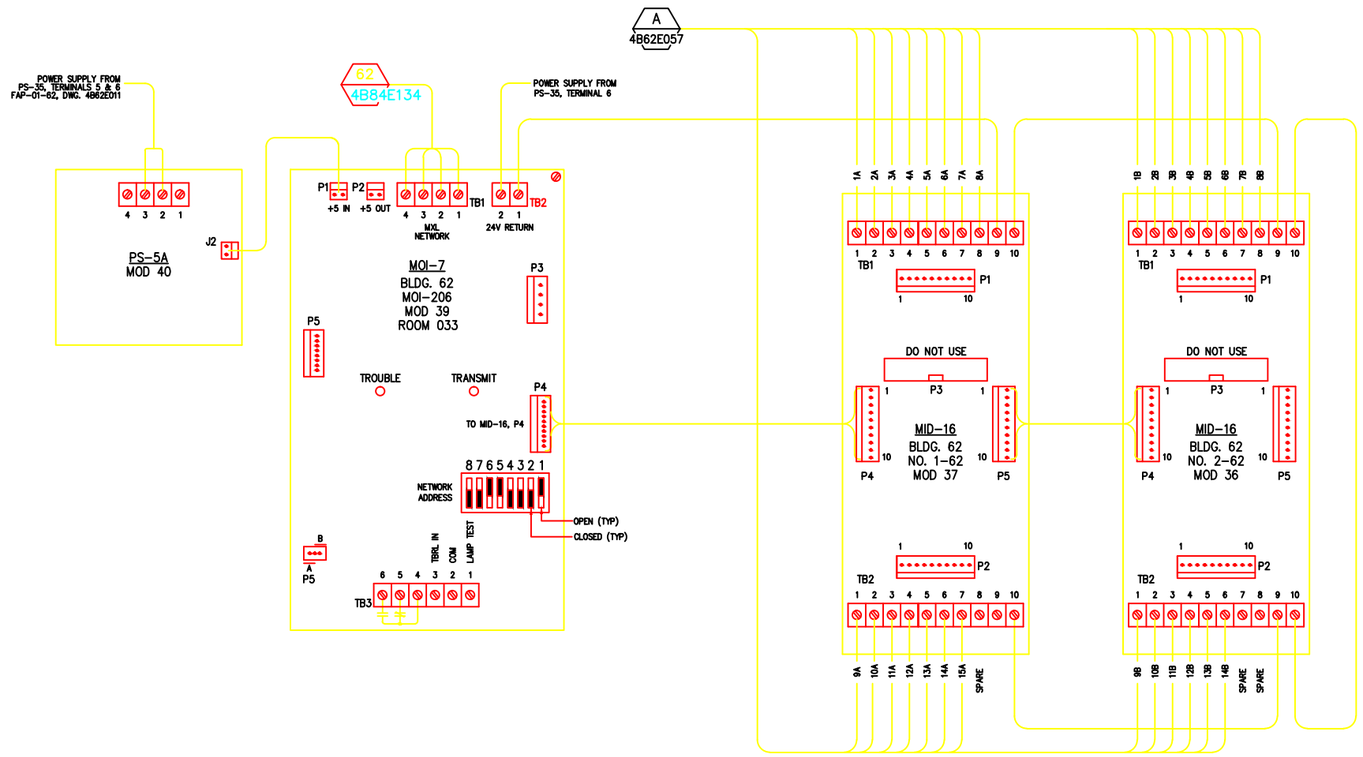

OLD ADDRESS	DESCRIPTION	MID-16 TERMINATION	MODULE TYPE & NO.	MXL NO. 6 AT B84 ADDRESS
1C01	FCB/HD HI BAY	TB. 1 NO. 1	MID-16 NO. 1-62	6-206-1
1C02	FCB/HD BASEMENT	TB. 1 NO. 2	MID-16 NO. 1-62	6-206-2
1C03	FCB/HD 1ST FLOOR WEST	TB. 1 NO. 3	MID-16 NO. 1-62	6-206-3
1C04	FCB/HD 1ST FLOOR EAST	TB. 1 NO. 4	MID-16 NO. 1-62	6-206-4
1C05	FCB/HD 2ND FLOOR WEST	TB. 1 NO. 5	MID-16 NO. 1-62	6-206-5
1C06	FCB/HD 2ND FLOOR EAST	TB. 1 NO. 6	MID-16 NO. 1-62	6-206-6
1C07	FCB/HD 3RD FLOOR WEST	TB. 1 NO. 7	MID-16 NO. 1-62	6-206-7
1C08	FCB/HD 3RD FLOOR EAST	TB. 1 NO. 8	MID-16 NO. 1-62	6-206-8
1C09	FCB/HD ROOF	TB. 2 NO. 1	MID-16 NO. 1-62	6-206-9
1C10	FCB/HD TRAILER 62A	TB. 2 NO. 2	MID-16 NO. 1-62	6-206-10
1C11	LOW WATER PRESSURE	TB. 2 NO. 6	MID-16 NO. 1-62	6-206-14
1C12	HIGH WATER PRESSURE	TB. 2 NO. 7	MID-16 NO. 1-62	HOLD
1C13	WFS TRAILER 62A	TB. 2 NO. 3	MID-16 NO. 1-62	6-206-11
1C14	DRY CHEM DISCHARGE 62C,D	TB. 2 NO. 4	MID-16 NO. 1-62	6-206-12
1C15	SYSTEM 3 SUPERVISION	TB. 2 NO. 5	MID-16 NO. 1-62	6-206-13
1C16	MX-203 TROUBLE	N/A	N/A	N/A

FORMERLY MX-203 (TR-113)

OLD ADDRESS	DESCRIPTION	MID-16 TERMINATION	MODULE TYPE & NO.	MXL NO. 6 AT B84 ADDRESS
1C17	WFS HI BAY	TB. 1 NO. 1	MID-16 NO. 2-62	6-206-17
1C18	WFS BASEMENT	TB. 1 NO. 2	MID-16 NO. 2-62	6-206-18
1C19	WFS 1ST FLOOR	TB. 1 NO. 3	MID-16 NO. 2-62	6-206-19
1C20	WFS 2ND FLOOR	TB. 1 NO. 4	MID-16 NO. 2-62	6-206-20
1C21	WFS 3RD FLOOR	TB. 1 NO. 5	MID-16 NO. 2-62	6-206-21
1C22	SD 1ST/3RD LOOBY/EL MACH RM	TB. 1 NO. 6	MID-16 NO. 2-62	6-206-22
	SD 2ND FLOOR LOBBY	TB. 1 NO. 7	MID-16 NO. 2-62	6-206-23
1C23	SD AT FACP	TB. 2 NO. 6	MID-16 NO. 2-62	6-206-30
1C24	NOT USED	N/A	N/A	N/A
1C25	RISER & TRAILER ISO VLV SUPV	TB. 1 NO. 8	MID-16 NO. 2-62	6-206-24
1C26	HI BAY ISO VLV SUPV	TB. 2 NO. 1	MID-16 NO. 2-62	6-206-25
1C27	BASEMENT ISO VLV SUPV	TB. 2 NO. 2	MID-16 NO. 2-62	6-206-26
1C28	1ST FLOOR ISO VLV SUPV	TB. 2 NO. 3	MID-16 NO. 2-62	6-206-27
1C29	2ND FLOOR ISO VLV SUPV	TB. 2 NO. 4	MID-16 NO. 2-62	6-206-28
1C30	3RD FLR/ROOF ISO VLV SUPV	TB. 2 NO. 5	MID-16 NO. 2-62	6-206-29
1C31	NOT USED	N/A	N/A	N/A
1C32	MX-203 TROUBLE	N/A	N/A	N/A

FORMERLY MX-203 (TR-114)

AS BUILT

D
5/24/2013

PROFESSIONAL SEAL (IF REVISION, APPLIES ONLY TO REVISED WORK)

ISSUE (PROGRESS, ESTIMATE, BID, CONSTRUCTION, CONFORMED, REVISION, RECORD)

REVISION NUMBER	DRAWN BY	CHECKED BY	APPR'D BY	DATE	REMARKS
D	DSV	LDD	MCD	5/24/13	AS BUILT PER FIELD VERIFICATION
C	AD	LDD	MCD	6/06/06	REVISED FOR MXL COPPER LOOP
B	RZT	MCG	MCG	4/15/05	ADDED WIRES 14A & 15A.
A	AD	AD	MCG	11/14/03	AS-BUILT, PHASE II FA UPGRADE

62
FIRE ALARM SYSTEM
MOI/MID MODULE ARRANGEMENT

UNIVERSITY OF CALIFORNIA
LAWRENCE BERKELEY NATIONAL LABORATORY
FACILITIES DIVISION

DRAWN BY	HYT	DATE 2/12/2002
CHECKED BY	HYT	2/12/2002
APPROVED BY		
CAD FILE PATH		
SCALE	Full	
DRAWING NO.	4B62E089D	SHEET
PROJECT NO.	308021	1 OF 1