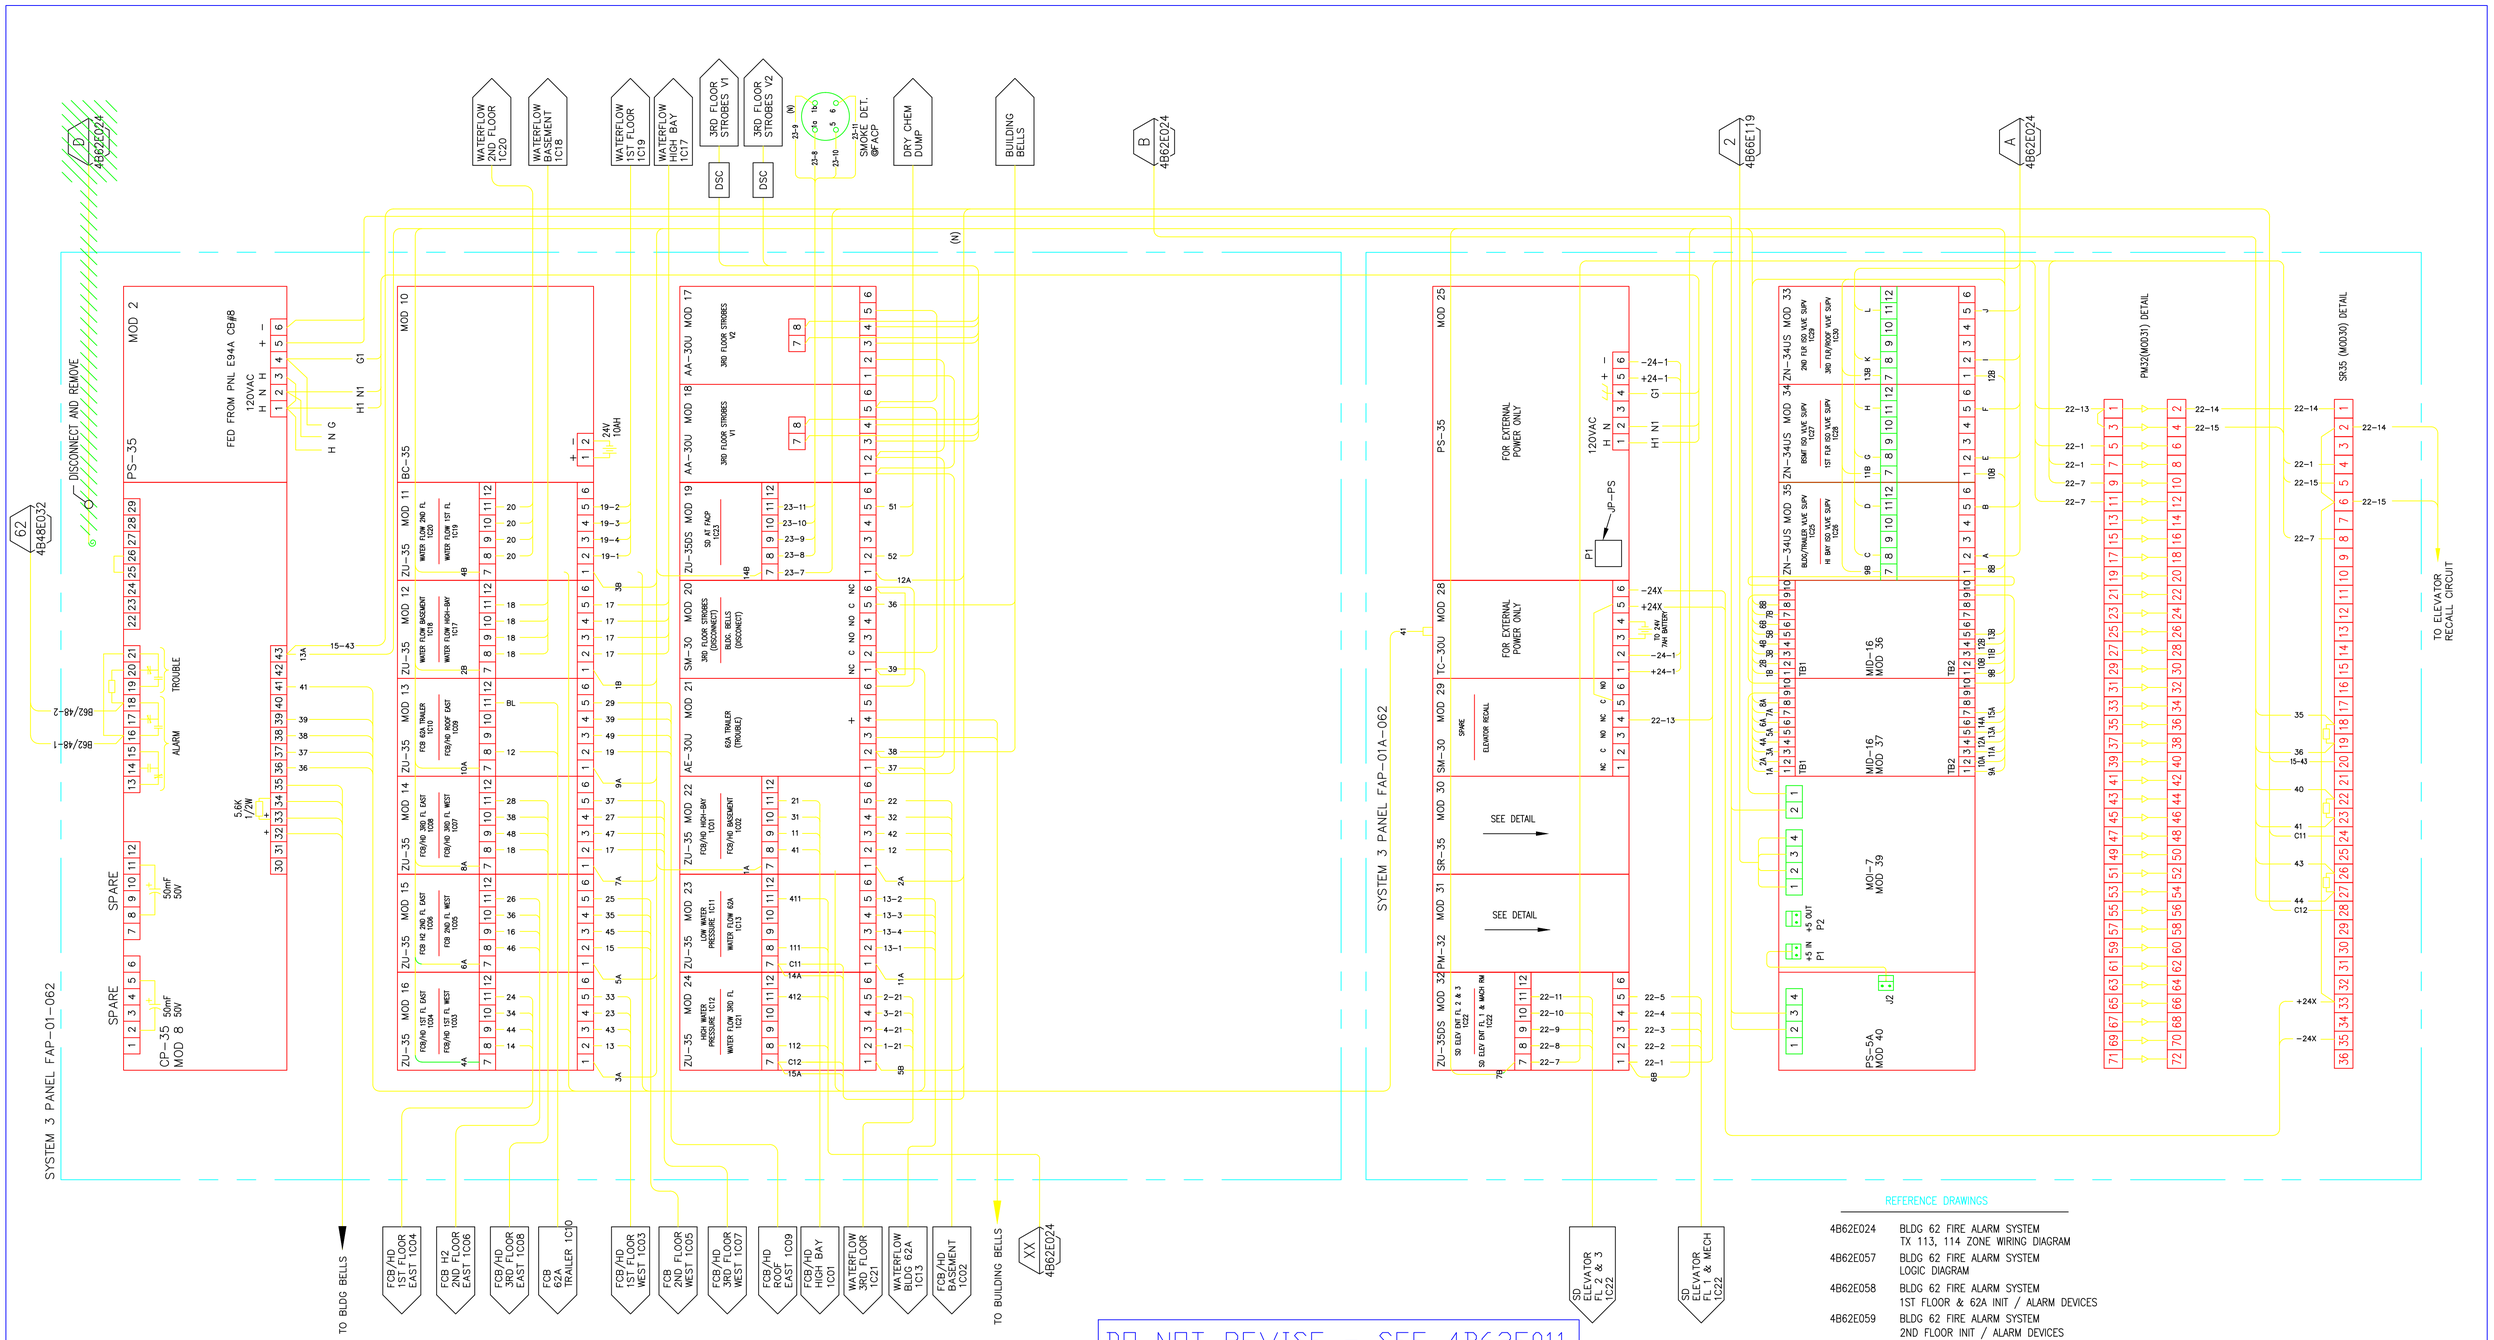

REFERENCE DRAWINGS

4B62E024	BLDG 62 FIRE ALARM SYSTEM TX 113, 114 ZONE WIRING DIAGRAM
4B62E057	BLDG 62 FIRE ALARM SYSTEM LOGIC DIAGRAM
4B62E058	BLDG 62 FIRE ALARM SYSTEM 1ST FLOOR & 62A INIT / ALARM DEVICES
4B62E059	BLDG 62 FIRE ALARM SYSTEM 2ND FLOOR INIT / ALARM DEVICES
4B62E060	BLDG 62 FIRE ALARM SYSTEM 3RD FLOOR INIT / ALARM DEVICES
4B62E061	BLDG 62 FIRE ALARM SYSTEM ELEV & MISC INIT / ALARM DEVICES

DUPLICATE COPY OF 4B62E011J

RECORD DRAWING

07/30/10

REVISION NUMBER	DRAWN BY	CHECKED BY	APPR'D BY	DATE	REMARKS
J	HYT	HYT	–	11/04/09	3RD FLOOR REMODEL/NOTIFICATION APPLIANCES
H	RZT	MCG	MCG	4/15/05	REVISED FOR MXL/DIGITIZE UPGRADE SYSTEM.
G	AD	AD	MCG	11/14/03	AS-BUILT, PHASE II FA UPGRADE
F	HYT	HYT	–	2/2/02	REPLACEMENT FIRE ALARM PROJECT
E	GMS	MCG	MCG	4/2/01	ADD SMOKE DETECTOR ELEVATOR RECALL

PROFESSIONAL SEAL (IF REVISION, APPLIES ONLY TO REVISED WORK)

ISSUE (PROGRESS, ESTIMATE, BID, CONSTRUCTION, CONFORMED, REVISION, RECORD)

62 FIRE ALARM SYSTEM
SYS 3 WIRING DIAGRAM
PANEL FAP 01-062

UNIVERSITY OF CALIFORNIA
LAWRENCE BERKELEY NATIONAL LABORATORY
FACILITIES DIVISION

DRAWN BY	RG	DATE 2/4/1988
CHECKED BY		
APPROVED BY	BS	2/10/1988
CAD FILE PATH		
SCALE	As Noted	
DRAWING NO.	4B62E138_	SHEET FA0.2
PROJECT NO.	FM9001	1 OF 1