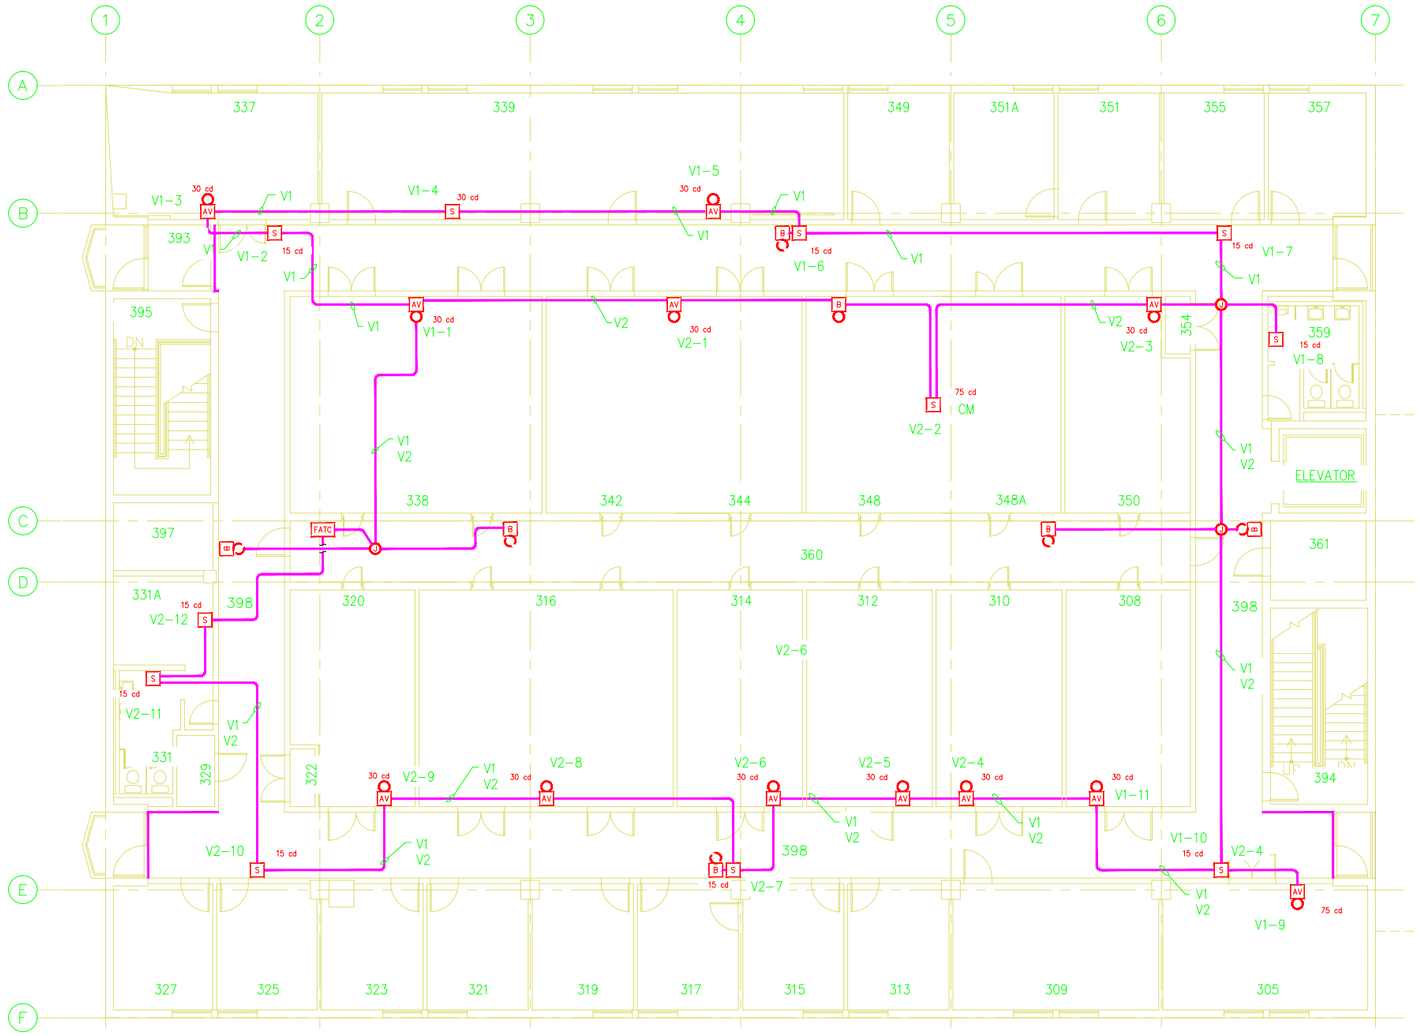

1 3RD FLOOR FIRE ALARM PLAN
D-size SCALE: 1/8"=1'-0"

0 8 FT 16 FT 24 FT
SCALE: 1/8"=1'-0" UNO

LEGEND

- S — NEW WALL MOUNTED STROBE, CANDELA AS NOTED.
- S CM — NEW CEILING MOUNTED STROBE, CANDELA AS NOTED.
- AV — NEW WALL MOUNTED BELL/STROBE, CANDELA AS NOTED.
- B — NEW WALL MOUNTED BELL.
- B — EXISTING WALL MOUNTED BELL.
- FATC — EXISTING FIRE ALARM TERMINAL CABINET.
- NEW 3/4 INCH FIRE ALARM CONDUIT.

SHEET NOTES

1. THE EXISTING BELL CIRCUIT(S) SERVING THE FLOOR ARE NOT SHOWN. UTILIZE THE EXISTING BELL CIRCUIT(S) TO POWER ALL NEW AND EXISTING BELLS FOR THE FLOOR. COMPLETE THE CIRCUIT TO COMPLY AS CLASS A WIRING.
2. EXISTING FIRE ALARM CONDUIT MAY BE USED TO THE EXTENT APPROPRIATE AND PRACTICAL IN LIEU OF INSTALLING NEW CONDUIT.

BUILDING KEY PLAN

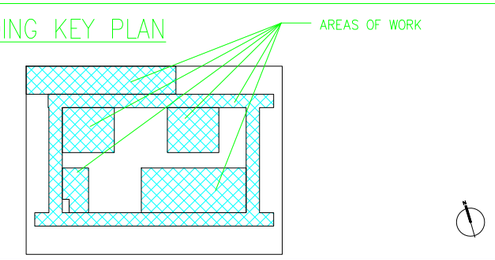

PROFESSIONAL SEAL (IF REVISION, APPLIES ONLY TO REVISED WORK)	RECORD DRAWING 07/30/10	REVISION NUMBER	DRAWN BY	CHECKED BY	APPR'D BY	DATE	REMARKS
	ISSUE (PROGRESS, ESTIMATE, BID, CONSTRUCTION, CONFORMED, REVISION, RECORD)						

62
FIRE ALARM SYSTEM
PLAN AND NOTES

UNIVERSITY OF CALIFORNIA
LAWRENCE BERKELEY NATIONAL LABORATORY
FACILITIES DIVISION

DRAWN BY DWH	DATE
CHECKED BY BBT	11/04/09
APPROVED BY _	_
CAD FILE PATH	
SCALE AS NOTED	
DRAWING NO. 4B62E139	SHEET FA1.0
PROJECT NO. FM9001	