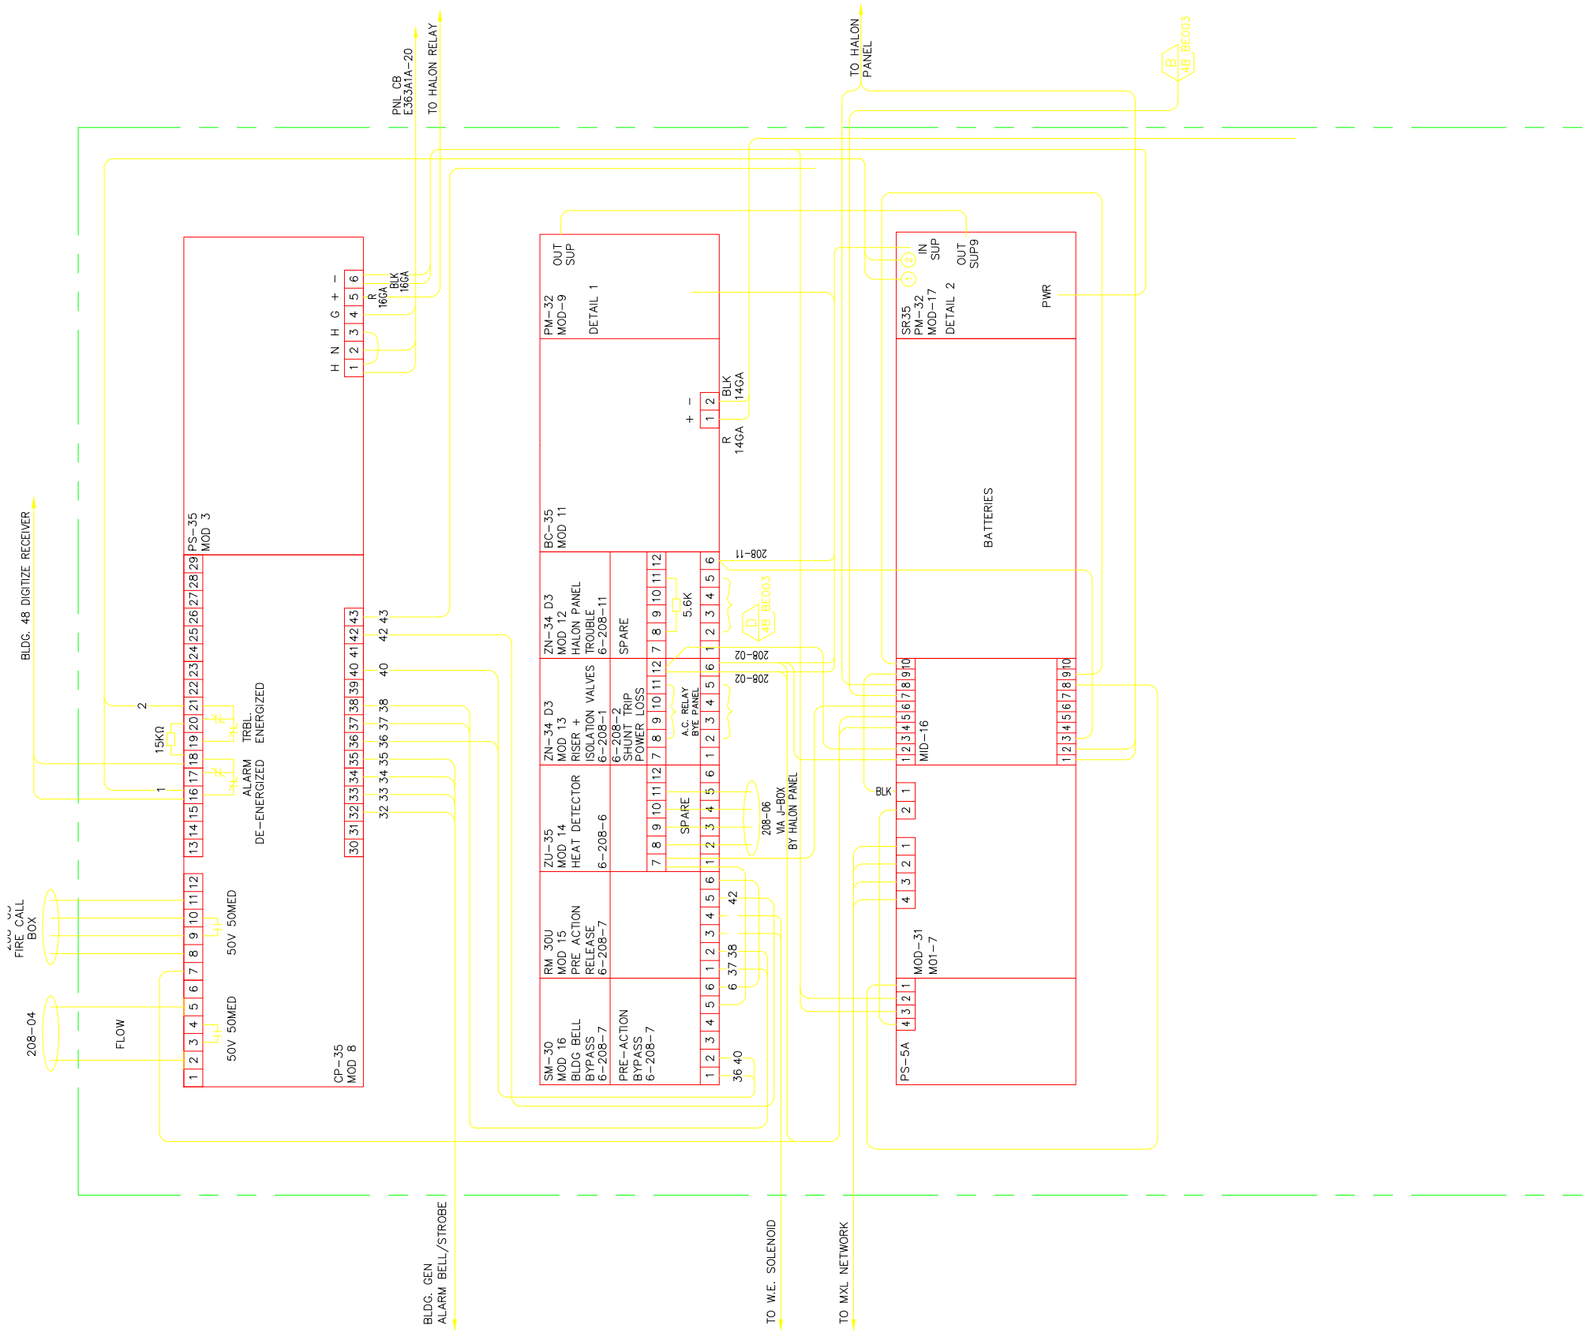

DETAIL #1

PM-32

MOD.13 ZN34US#6	1	2	MOD.17 SR35#4 PANEL SUPERVISORY
MOD.13 ZN34US 208-01#6 208-02	3	4	
	5	6	
	7	8	
	9	10	
	11	12	
	13	14	
	15	16	
	17	18	
	19	20	
	21	22	
	23	24	
	25	26	
	27	28	
	29	30	
	31	32	
	33	34	
	35	36	
	37	38	
	39	40	
	41	42	
	43	44	
	45	46	
	47	48	
	49	50	
	51	52	
	53	54	
	55	56	
	57	58	
	59	60	
	61	62	
	63	64	
	65	66	
	67	68	
	69	70	
	72	72	

DETAIL #2

SR-35

MOD 8 CP35#16	1	NC
MOD 8 CP35#21	2	C
	3	NO
MOD 9 PM32#2	4	1K
	5	NC
	6	C
	7	NO
	8	2K
	9	NC
	10	C
	11	NO
	12	3K
	13	NC
	14	C
	15	NO
	16	4K
	17	NC
	18	C
	19	NO
	20	5K
	21	NC
	22	C
	23	NO
	24	6K
	25	NC
	26	C
	27	NO
	28	7K
	29	NC
	30	C
	31	NO
	32	8K
+24	33	
	34	
	35	
−24	36	

DO NOT USE SEE
4B62BE011

PROFESSIONAL SEAL (IF REVISION, APPLIES ONLY TO REVISED WORK)	AS BUILT REVISION A 9/3/2010 (ISSUE: PROGRESS, ESTIMATE, BID, CONSTRUCTION, CONFORMED, REVISION, RECORD)	A			9/3/10	AS BUILT	
		REVISION NUMBER	DRAWN BY	CHECKED BY	APPR'D BY	DATE	REMARKS

62B FIRE ALARM
SYS3 PANEL FAP-01
INTERCONNECTION DIAGRAM

UNIVERSITY OF CALIFORNIA
LAWRENCE BERKELEY NATIONAL LABORATORY
FACILITIES DIVISION

DRAWN BY	DATE
CHECKED BY	
APPROVED BY	
CAD FILE PATH	
SCALE	
DRAWING NO. 4B62BE140A	SHEET FA
PROJECT NO.	