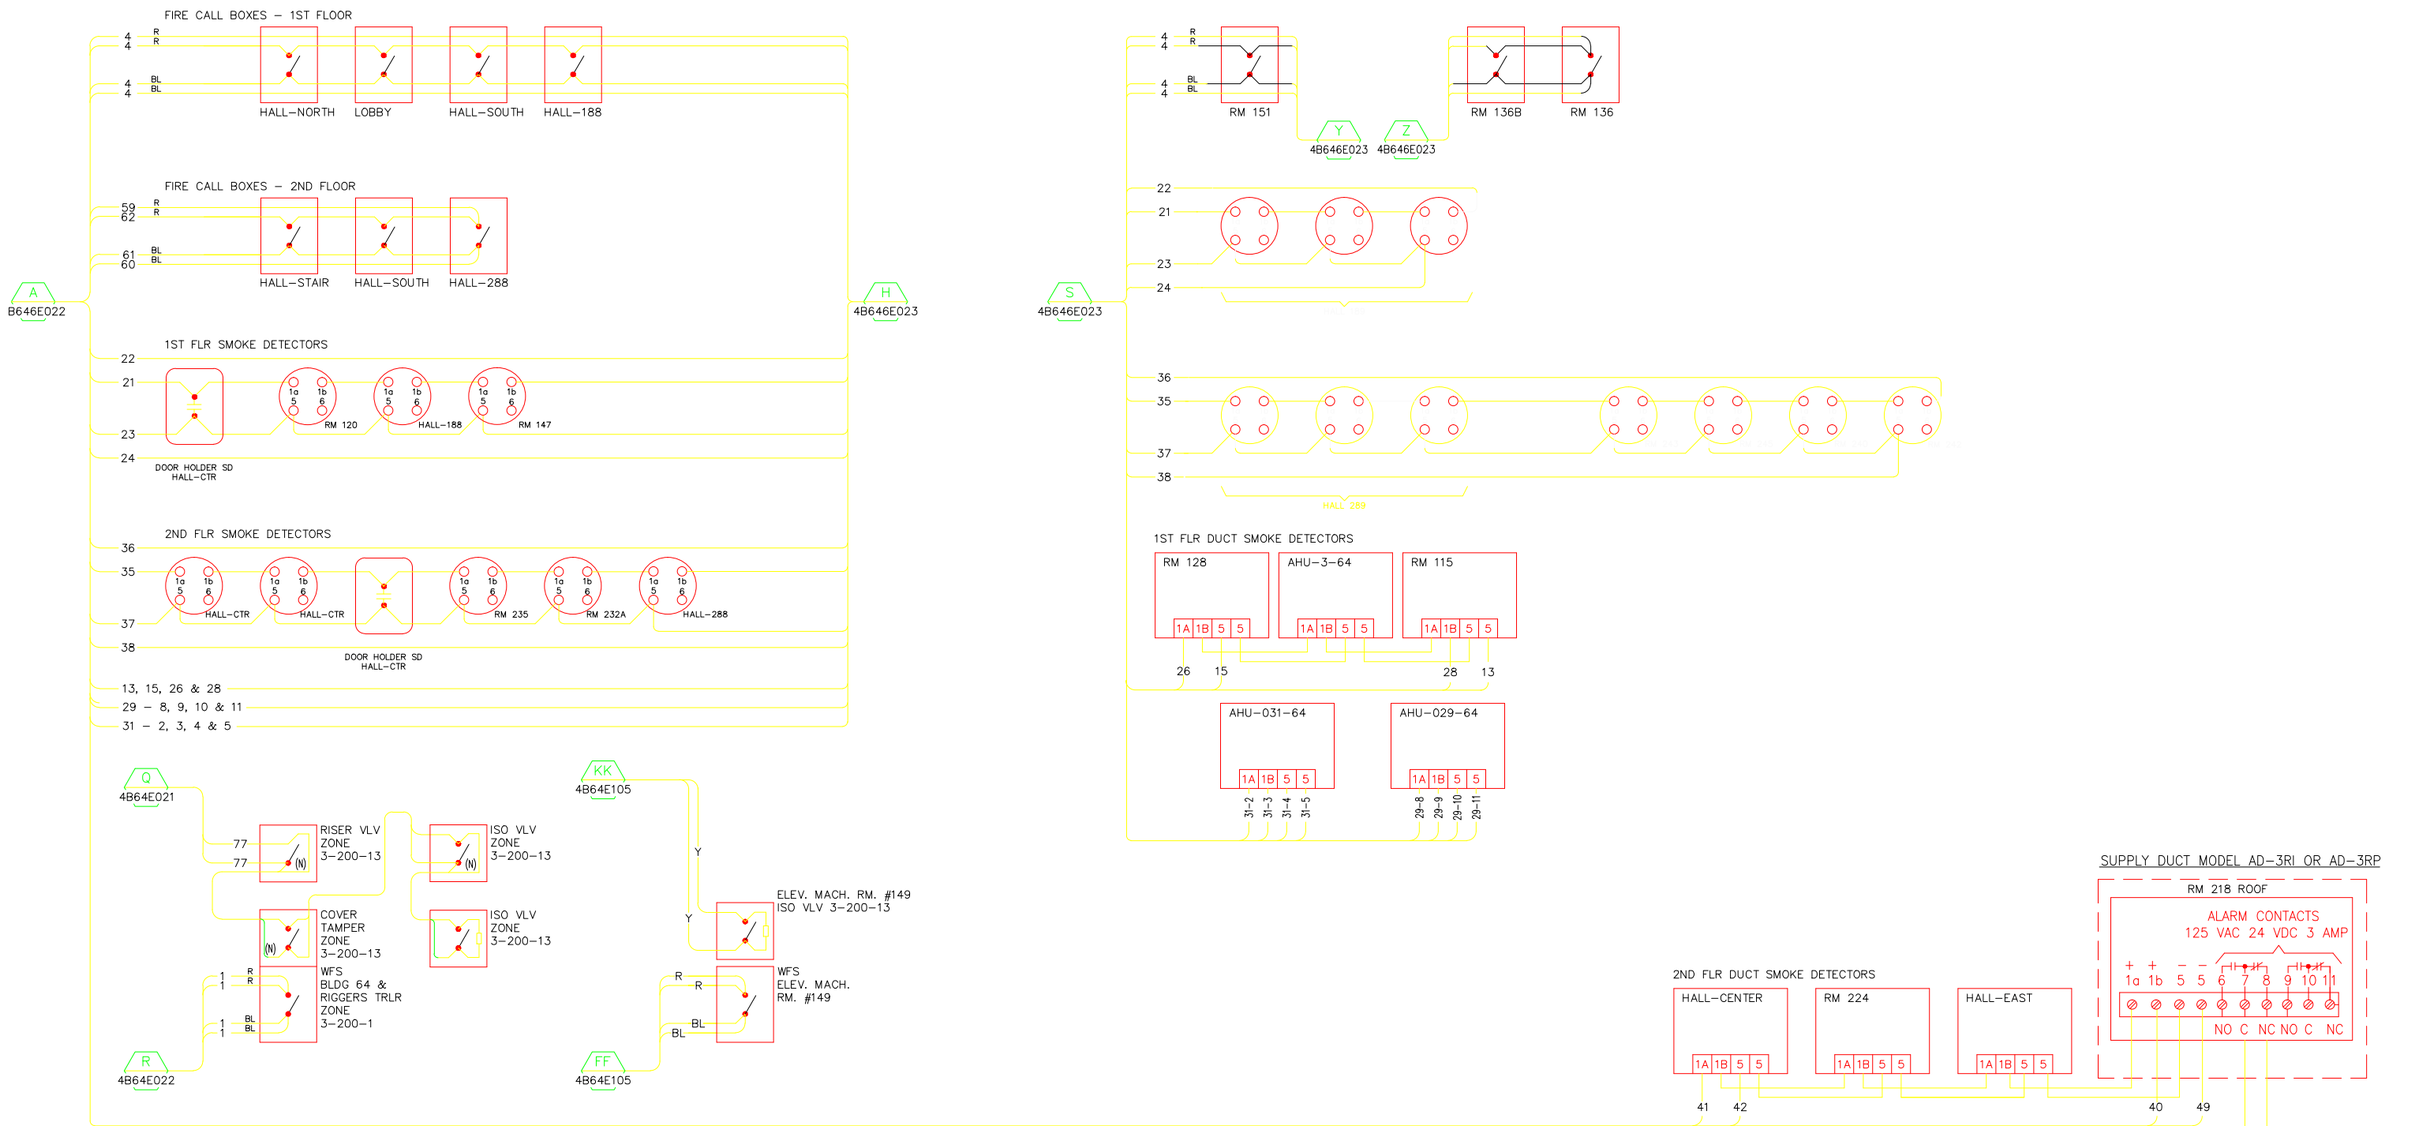

REFERENCE DRAWINGS

4B64E021	BLDG 64/56 TRANSMITTER WIRING & LOGIC
4B64E022	BLDG 64/56 SYS 3 WIRING PANEL FAP–001–064
4B64E023	BLDG 64/56 SYS 3 PANEL FAP–001–064 & TERMINATION PNL WIRING
4B64E084	BLDG 64 FIRE ALARM ALARM/ACTIVATION DEVICE WIRING
4B56E002	BLDG 56 FIRE ALARM DEVICE WIRING
4B64E105	BLDG 64/56 SYSTEM 3 PANEL FAP–002–64

AS BUILT

M
05/29/2013

REVISION NUMBER	DRAWN BY	CHECKED BY	APPR'D BY	DATE	REMARKS
M	DSV	LDD	MCD	5/29/13	AS BUILT PER FIELD VERIFICATION
L				5/15/09	AS BUILT
K				9/30/08	AS BUILT
J	RZT	MCG	MCG	4/09/05	REVISED FOR MXL/DIGITIZE SYSTEM
I	HYT	HYT	–	8/24/04	PROJECT FM3001 MODIFICATIONS
H	HYT	HYT	–	9/10/03	EXPANSION PROJECT FM3001
G	LDD	LDD	MCG	8/30/00	AS–BUILT– PROJS FM9210 & FM9310

PROFESSIONAL SEAL (IF REVISION, APPLIES ONLY TO REVISED WORK)

ISSUE (PROGRESS, ESTIMATE, BID, CONSTRUCTION, CONFORMED, REVISION, RECORD)

64
FIRE ALARM SYSTEM
INITIATING DEVICE WIRING

UNIVERSITY OF CALIFORNIA
LAWRENCE BERKELEY NATIONAL LABORATORY
FACILITIES DIVISION

DRAWN BY	FWD	DATE 8/5/1998
CHECKED BY	LDD	8/5/1998
APPROVED BY	MCG	8/5/1998
CAD FILE PATH		
SCALE	As Noted	
DRAWING NO.	4B64E024M	SHEET FA
PROJECT NO.	120700	1 OF1