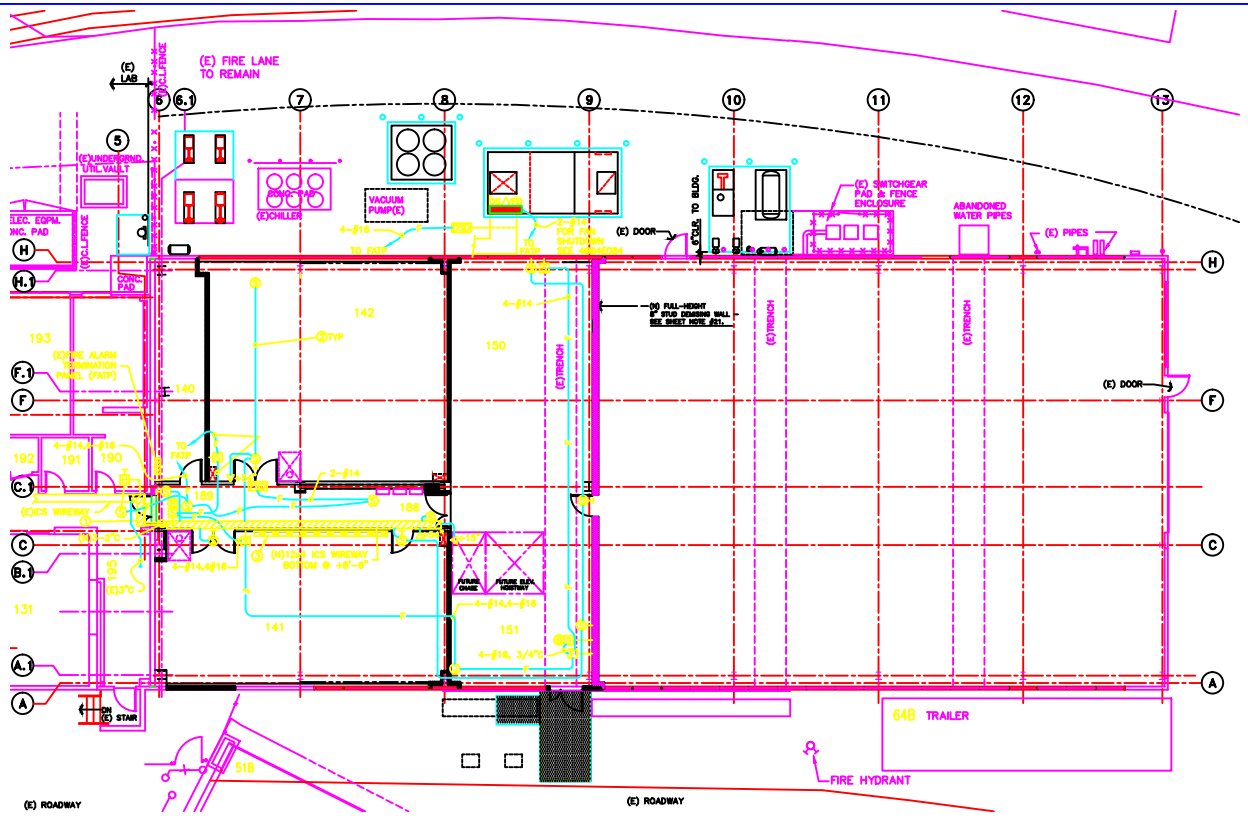

1 PARTIAL FIRST FLOOR PLAN
SCALE : 1/8" = 1'-0"

SHEET NOTES :

1. REMOVE (E) 12x12x4 JB & 3-2"C. TO INSTALL 12x4 WIREWAY TRANSITION PIECE.
2. 3/4"C WITH PULL STRING BETWEEN SPEAKER OUTLETS AND TO ICS WIREWAY
3. SEE SHEET E1 PLAN AND NOTES.

PROJECT REFERENCE NORTH

REVISION NUMBER	DRAWN BY	DESIGNED BY	APPROVED BY	DATE	REMARKS
A	LDD	LDD	MCG	10/17/01	AS BUILT

64 GENOME SEQUENCING FAC
HIGH BAY EXPANSION-GEN. CONST
1ST FLR FIRE ALARM & SIG PLAN

DRAWN BY	FWD	05/07/99
CHECKED BY	LDD	05/07/99
APPROVED BY	MCG	05/10/99
CAD FILE PATH	00013087	
SCALE	As Noted	

UNIVERSITY OF CALIFORNIA
LAWRENCE BERKELEY NATIONAL LABORATORY
FACILITIES DEPARTMENT

DRAWING NO. 4B64E067A
PROJECT NO. FM9210
SHEET E5 6 OF 9