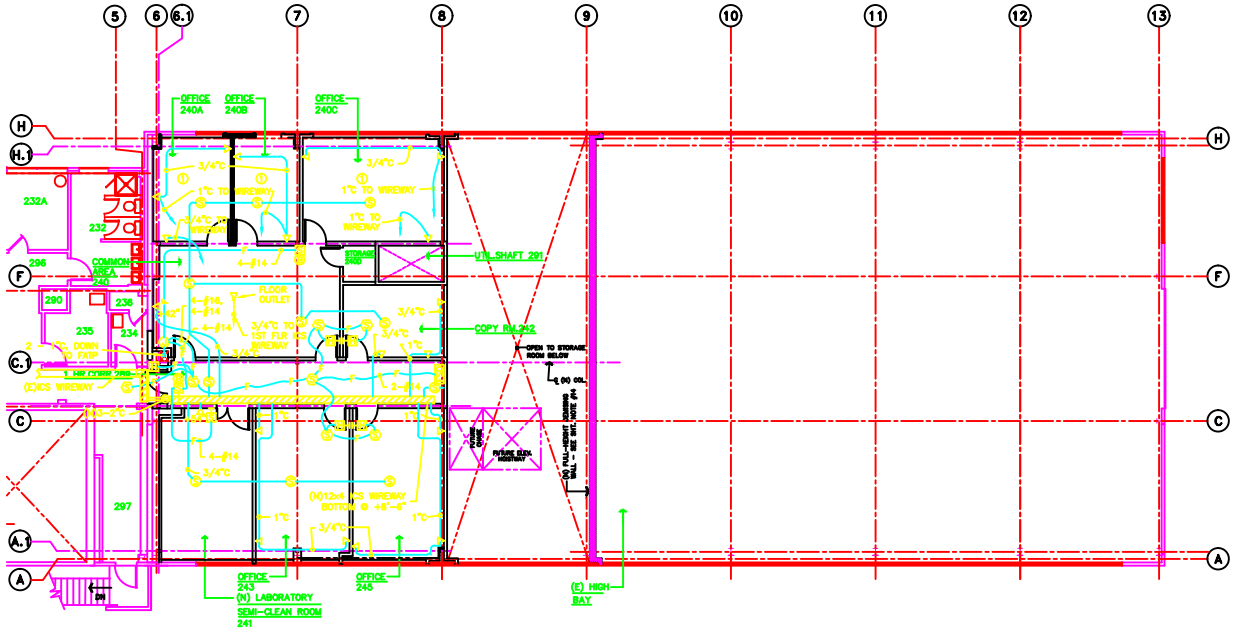

1 PARTIAL SECOND FLOOR PLAN
1/8" = 1'-0"

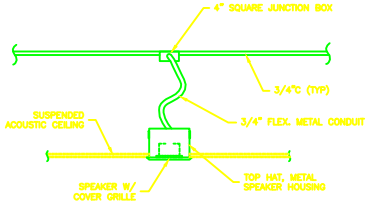

2 DETAIL–CEILING MOUNTED SPEAKER
N.T.S.

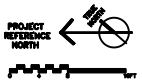

SHEET NOTES :

1. MOUNT ICS OUTLETS AT +33"A.F.F., ORIENTED HORIZONTALLY.

REVISION NUMBER	DRAWN BY	DESIGNED BY	APPROVED BY	DATE	REMARKS
A	LDD	LDD	MCG	10/17/01	AS BUILT

64 GENOME SEQUENCING FAC
HIGH BAY EXPANSION–GEN. CONST
2ND FLR FIRE ALARM & SIG PLAN

DRAWN BY	FWD	05/07/99
CHECKED BY	LDD	05/07/99
APPROVED BY	MCG	05/10/99
CAD FILE PATH	0001308B	
SCALE	As Noted	

UNIVERSITY OF CALIFORNIA
LAWRENCE BERKELEY NATIONAL LABORATORY
FACILITIES DEPARTMENT

DRAWING NO. 4B64E068A
PROJECT NO. FM9210
SHEET E6 7 OF 9