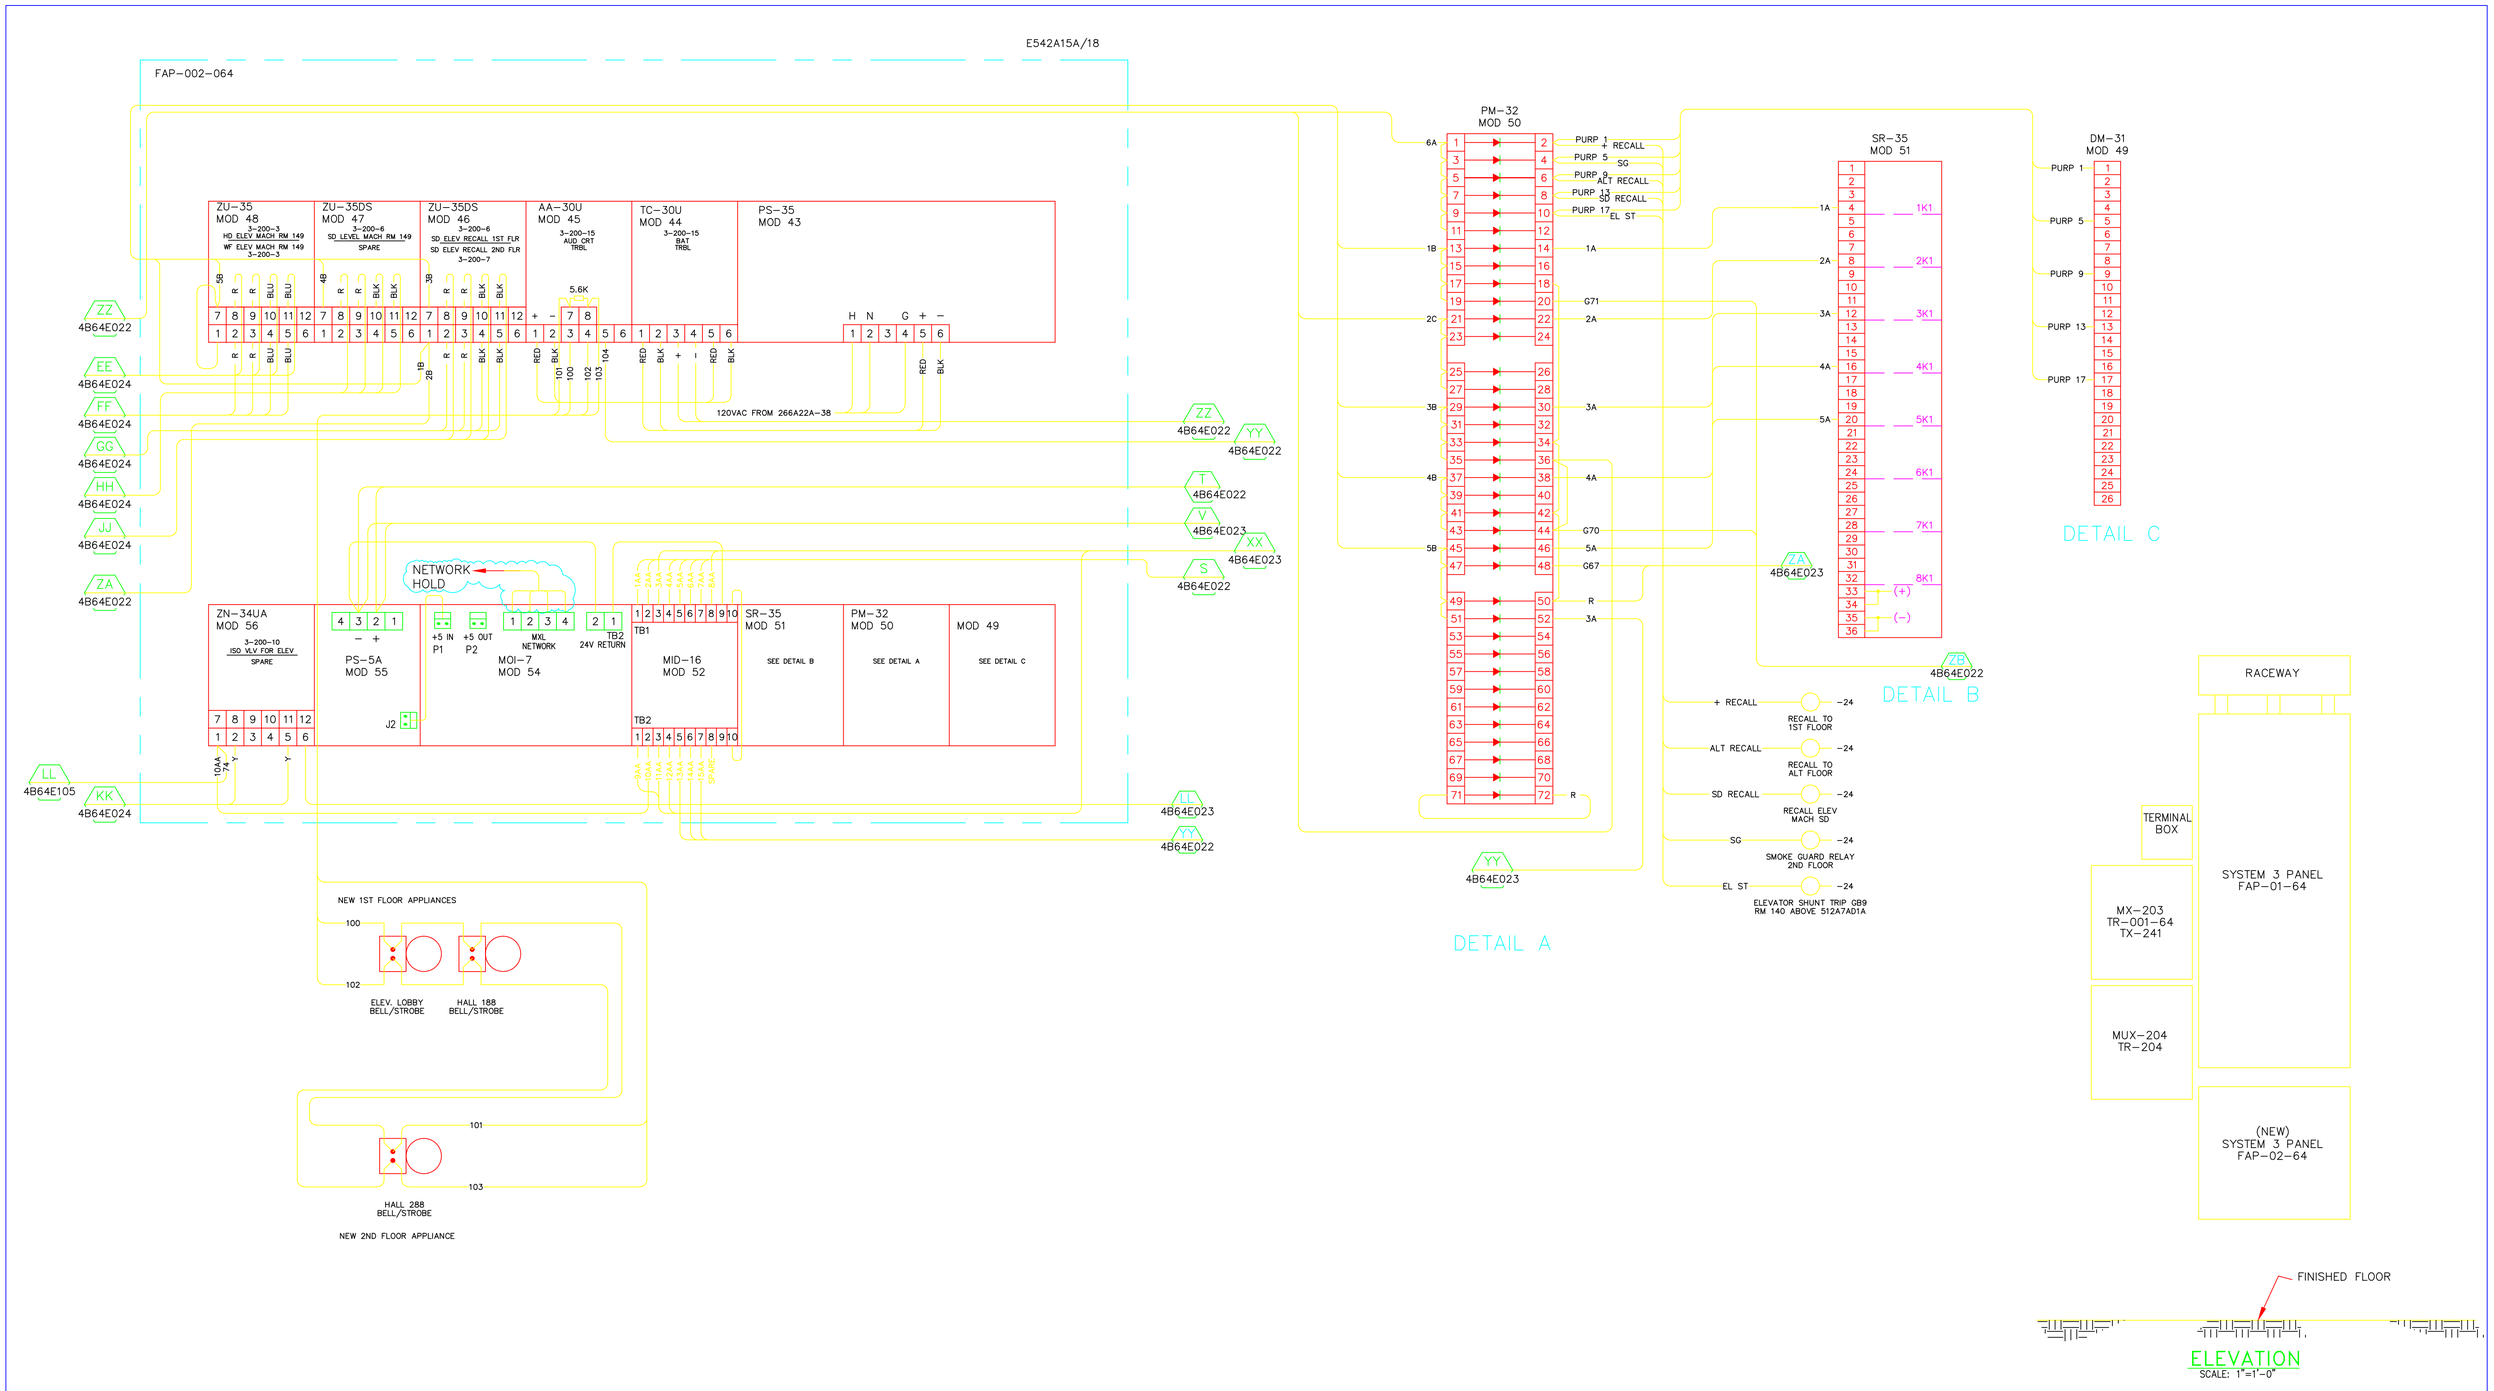

REFERENCE DRAWINGS

4B64E021	BLDG 64/56 TRANSMITTER LOGIC & WIRING
4B64E022	BLDG 64/56 SYS 3 WIRING FAP-001-064
4B64E023	BLDG 64/56 SYS 3 FAP-001-064 & TERMINATION PNL WIRING
4B64E024	BLDG 64 FIRE ALARM INITIATING SYSTEM DEVICE WIRING
4B64E084	BLDG 64 FIRE ALARM ALARM/ACTIVATION DEVICE WIRING
4B56E002	BLDG 56 FIRE ALARM SYSTEM DEVICE WIRING

AS BUILT

D
5/29/13

REVISION NUMBER	DRAWN BY	CHECKED BY	APPR'D BY	DATE	REMARKS
D	DSV	LDD	MCD	5/30/13	AS BUILT PER FIELD VERIFICATION
C	RZT	MCG	MCG	5/09/05	REVISED FOR MXL/DIGITIZE SYSTEMS
B	HYT	HYT	–	2/14/05	PROJECT FM3001 RECORD DRAWINGS
A	HYT	HYT	–	8/24/04	PROJECT FM3001 MODIFICATIONS

PROFESSIONAL SEAL (IF REVISION, APPLIES ONLY TO REVISED WORK)

ISSUE (PROGRESS, ESTIMATE, BID, CONSTRUCTION, CONFORMED, REVISION, RECORD)

64 FIRE ALARM SYSTEM
SYSTEM 3 WIRING
PNL FAP-002-064

UNIVERSITY OF CALIFORNIA
LAWRENCE BERKELEY NATIONAL LABORATORY
FACILITIES DIVISION

DRAWN BY HYT	DATE 7/29/2003	
CHECKED BY HYT	7/29/2003	
APPROVED BY		
CAD FILE PATH		
SCALE As Noted		
DRAWING NO. 4B64E105D	SHEET 1 OF1	
PROJECT NO. FM3001		