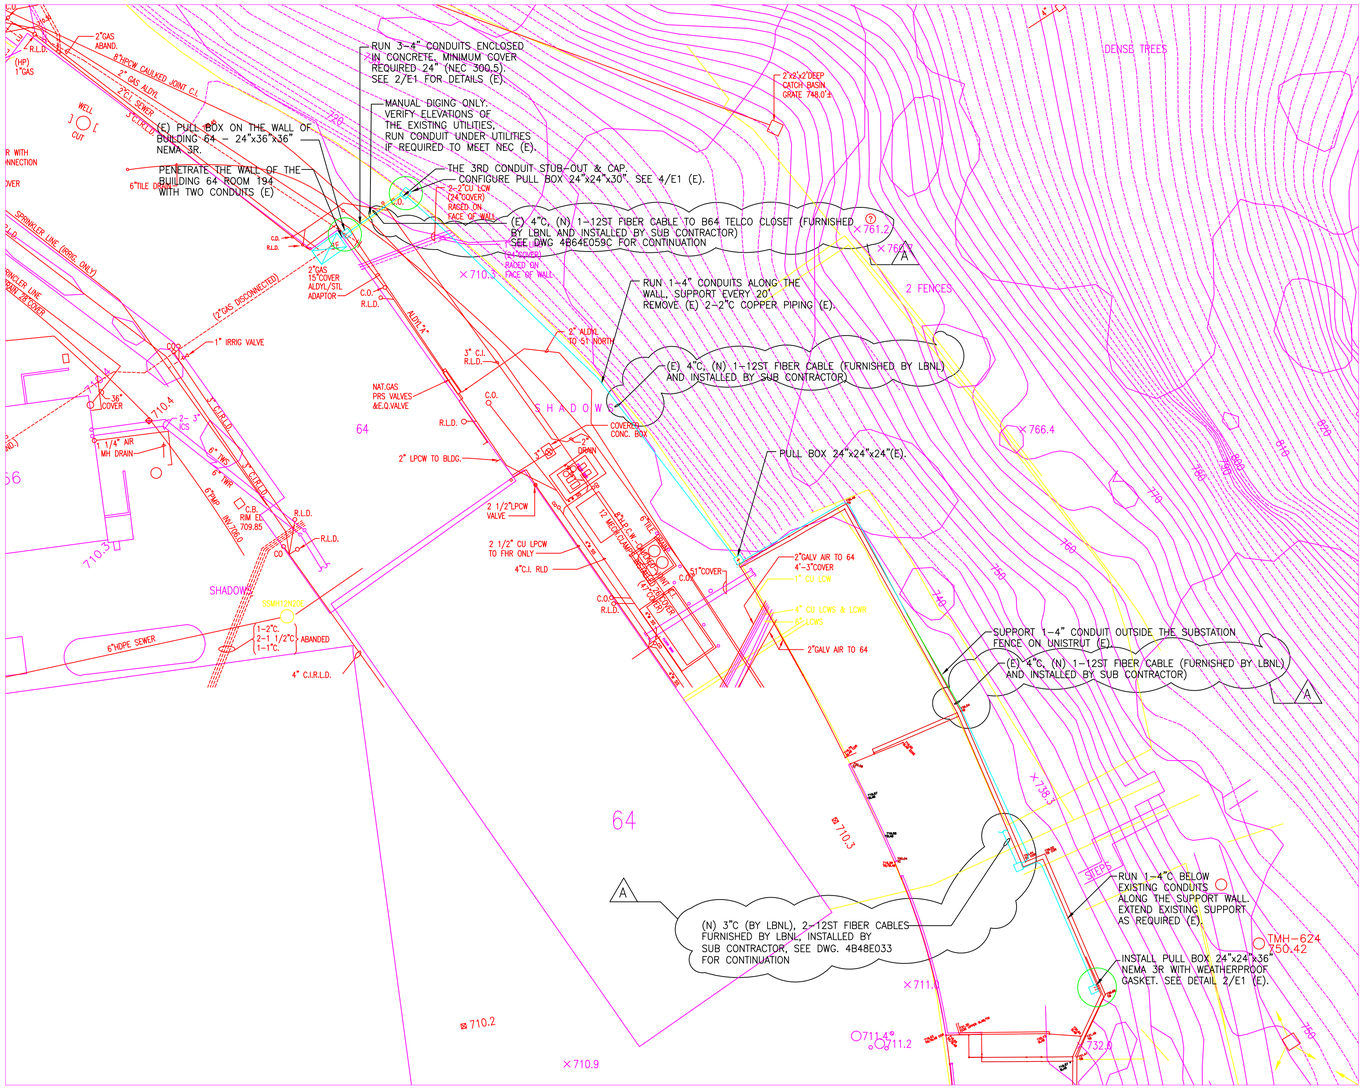

1 / E1 B64 SITE PLAN
SCALE: 1"=20'-0"

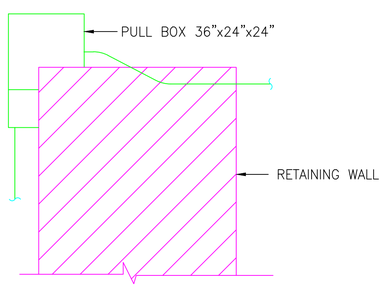

4 / E1 PULL BOX CONFIGURATION
SCALE: 1/2"=1'-0"

GENERAL NOTES:

1 PRIOR TO CONSTRUCTIOON FIELD VERIFY & CHECK EXISTING CONDITIONS, ELEVATIONS, DIMENSIONS AND INFORM ENGINEER/CONSTRUCTION SUPERINTENDANT OF CONFLICTS, INTERFERENCES & UNEXPECTED CONDITIONS.

2. CONDUIT & WIREWAY ROUTING ARE DIAGRAMATIC. MIN. 3/4"C & #12 AWG WIRE SIZES. SUPPORT CONDUITS & WIREWAY AT LEAST EVERY 10 FEET OR AS REQUIRED.

3. FIELD TO VERIFY & CHECK EQUIPMENT RATING, INTERCONNECTIONS, PRIOR TO TIE-DOWNS.

4. TAG & LABEL ALL ELECTRICAL EQPT & DEVICES WITH CIRCUIT NOs. AND/OR EQUIPMENT NOs.

5. FIELD TO SUBMIT MARKED-UP PRINTS AFTER THE INSTALLATIONS COMPLETE FOR "AS-BUILT".

NOTES:

1. 90 SWEEPS MUST BE AT LEAST 24" RADIUS.
2. CONDUITS SHALL BE OUTSIDE OF ELECTRICAL AREA AS SHOWN
3. NO 'LB' TO BE USED

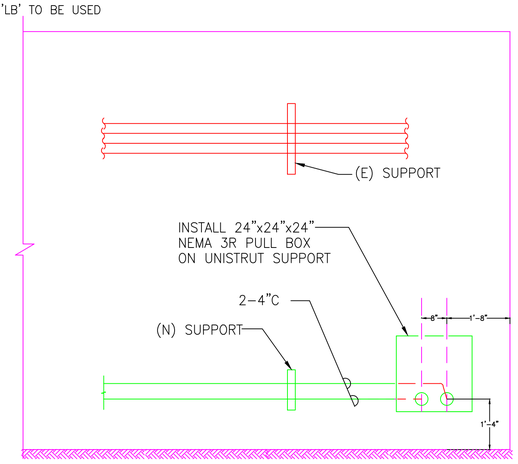

2 / E1 PULL BOX DETAIL
SCALE: 1/2"=1'-0"

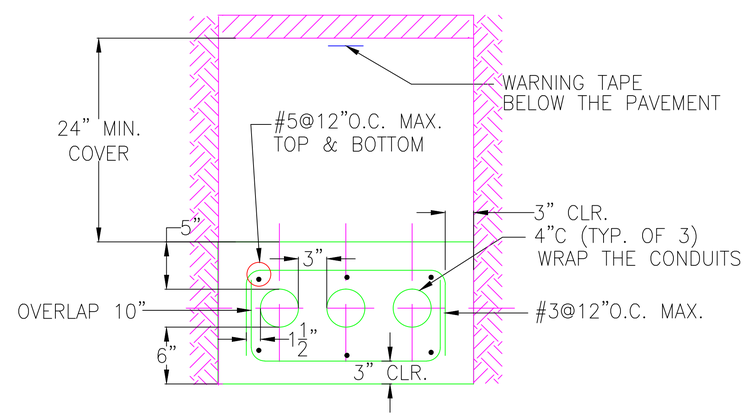

3 / E1 UNDERGROUND DUCT
SCALE: 1"=1'-0"

REVISION NUMBER	DRAWN BY	CHECKED BY	APPR'D BY	DATE	REMARKS
A	TK	MCG	MCG	02/16/05	NEW FIBER CABLE ROUTING (FE5012 PROJECT)

64 PHONE/DATA REROUTE
B51 EPB HALL DEMO
SITE PLAN, DETAILS, NOTES

UNIVERSITY OF CALIFORNIA LAWRENCE BERKELEY LABORATORY
FACILITIES DEPARTMENT

DRAWN BY	IPM	DATE 9/2/2003
CHECKED BY	TK	9/2/2003
APPROVED BY	MC	
CAD FILE PATH	00018985	
SCALE	As Noted	
DRAWING NO.	4B64E118A	SHEET E-1
PROJECT NO.	FT3200	1 OF1